


RIDGE PLAZA 11TH


WICHITA, SEDGWICK COUNTY, KANSAS

TRACT IN THE NE1/4 OF SEC. 28, TWP. 27-S, R-1-W
OF THE 6TH P.M., SEDGWICK COUNTY, KANSAS.

BOWEN H. & MARY E. BRADY
6405 E. KELLOGG
WICHITA, KS 67218

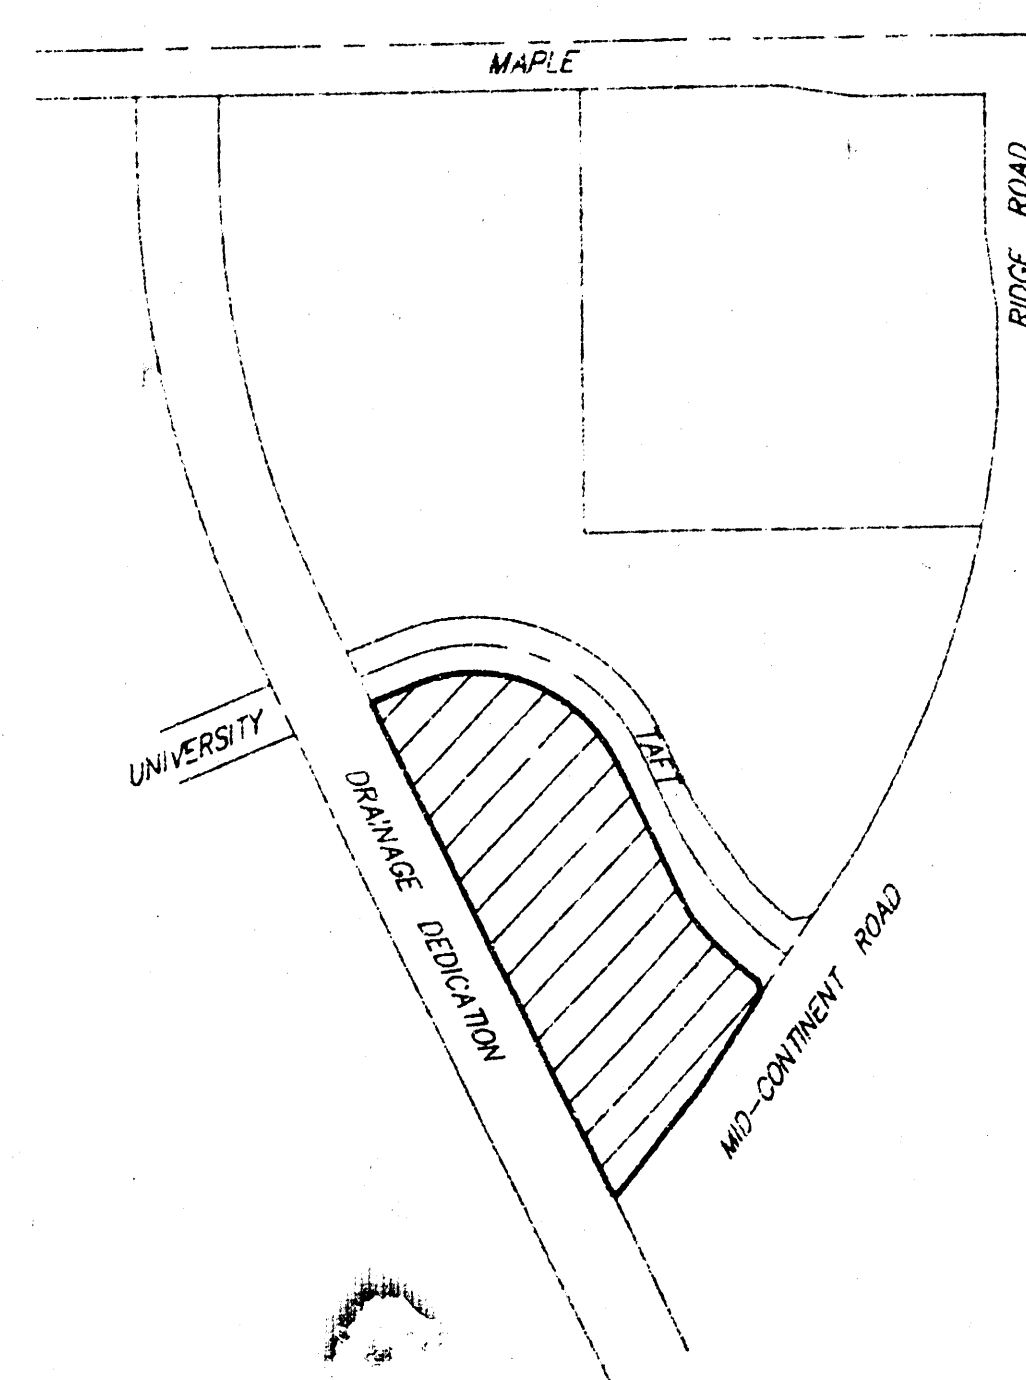

VICINITY PLAT

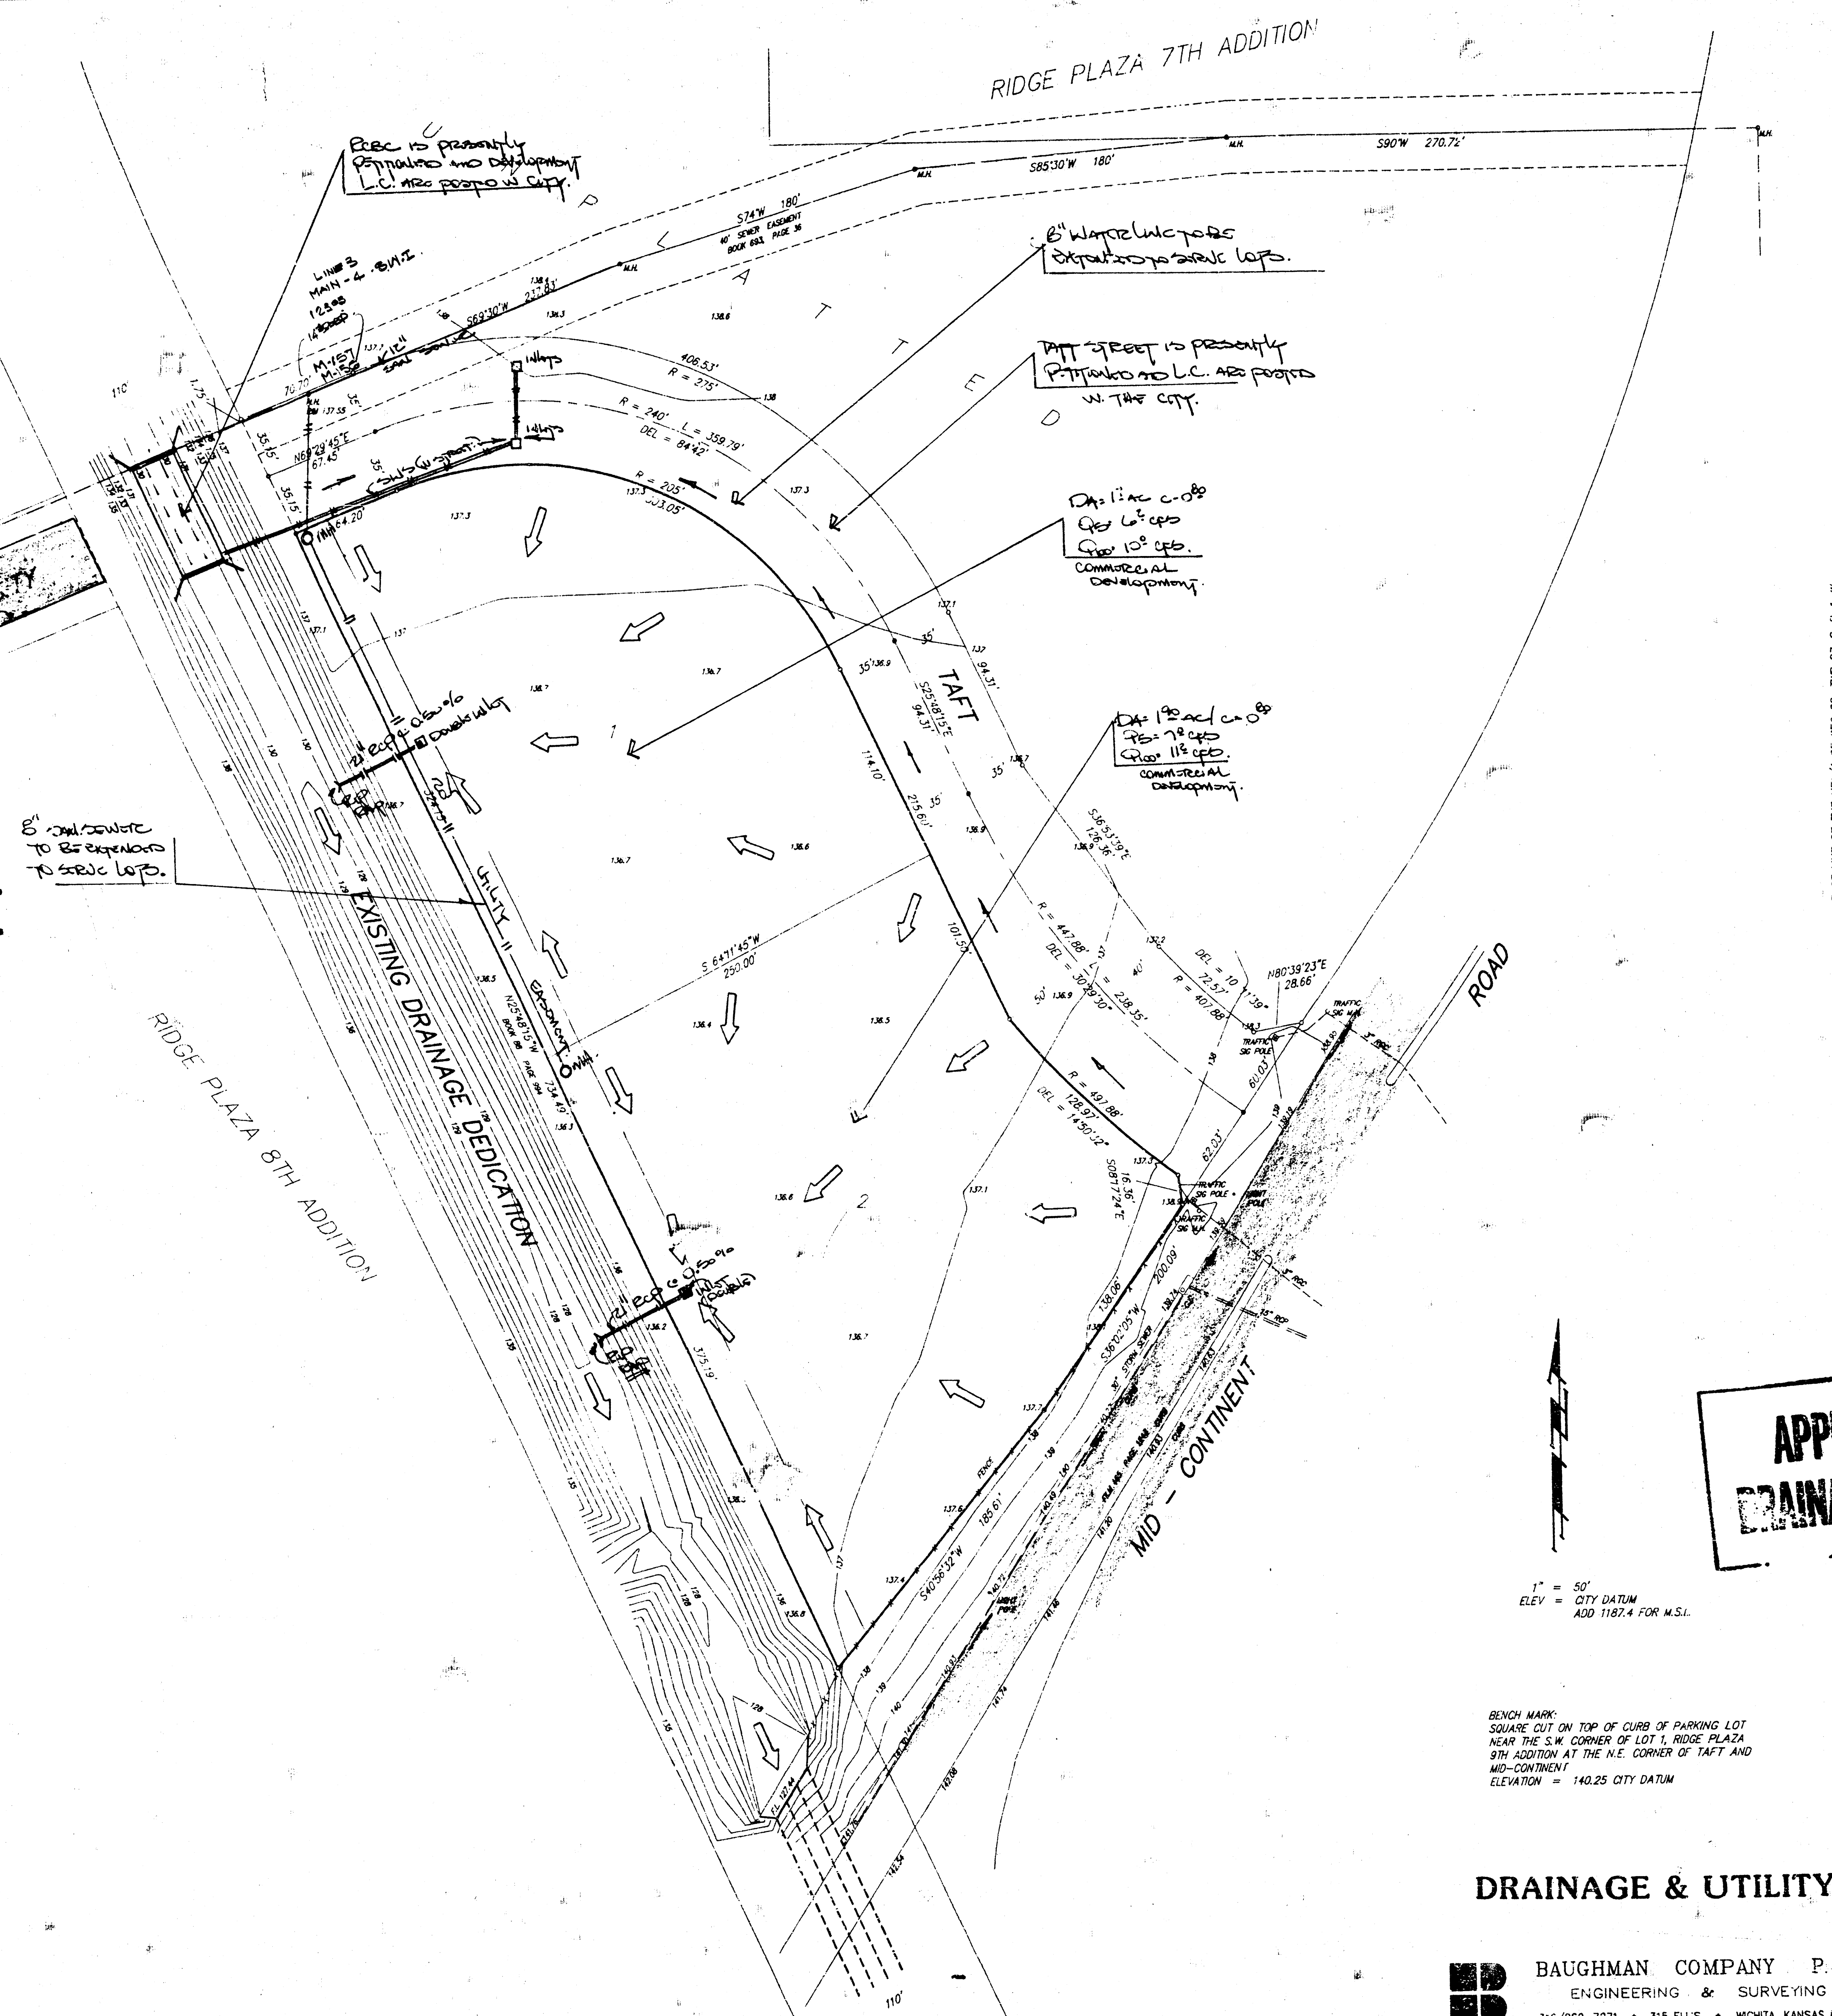

**APPROVED
DRAINAGE PLAN**

1" = 50'
ELEV = CITY DATUM
ADD 1187.4 FOR M.S.L.

BENCH MARK:
SQUARE CUT ON TOP OF CURB OF PARKING LOT
NEAR THE S.W. CORNER OF LOT 1, RIDGE PLAZA
9TH ADDITION AT THE N.E. CORNER OF TAFT AND
MID-CONTINENT
ELEVATION = 140.25 CITY DATUM

DRAINAGE & UTILITY PLAN



BAUGHMAN COMPANY P. A.
ENGINEERING & SURVEYING
316/262-7271 • 315 ELLIS • WICHITA, KANSAS 67211

1 MAR 91