



Schlotzsky

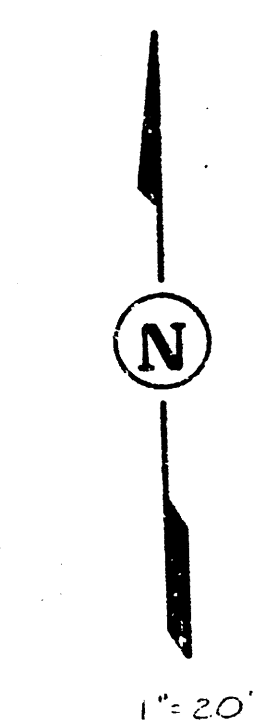

Bench Mark
Square cut top of curb
at west of NE property
corner
Elev. 105.27 City Datum

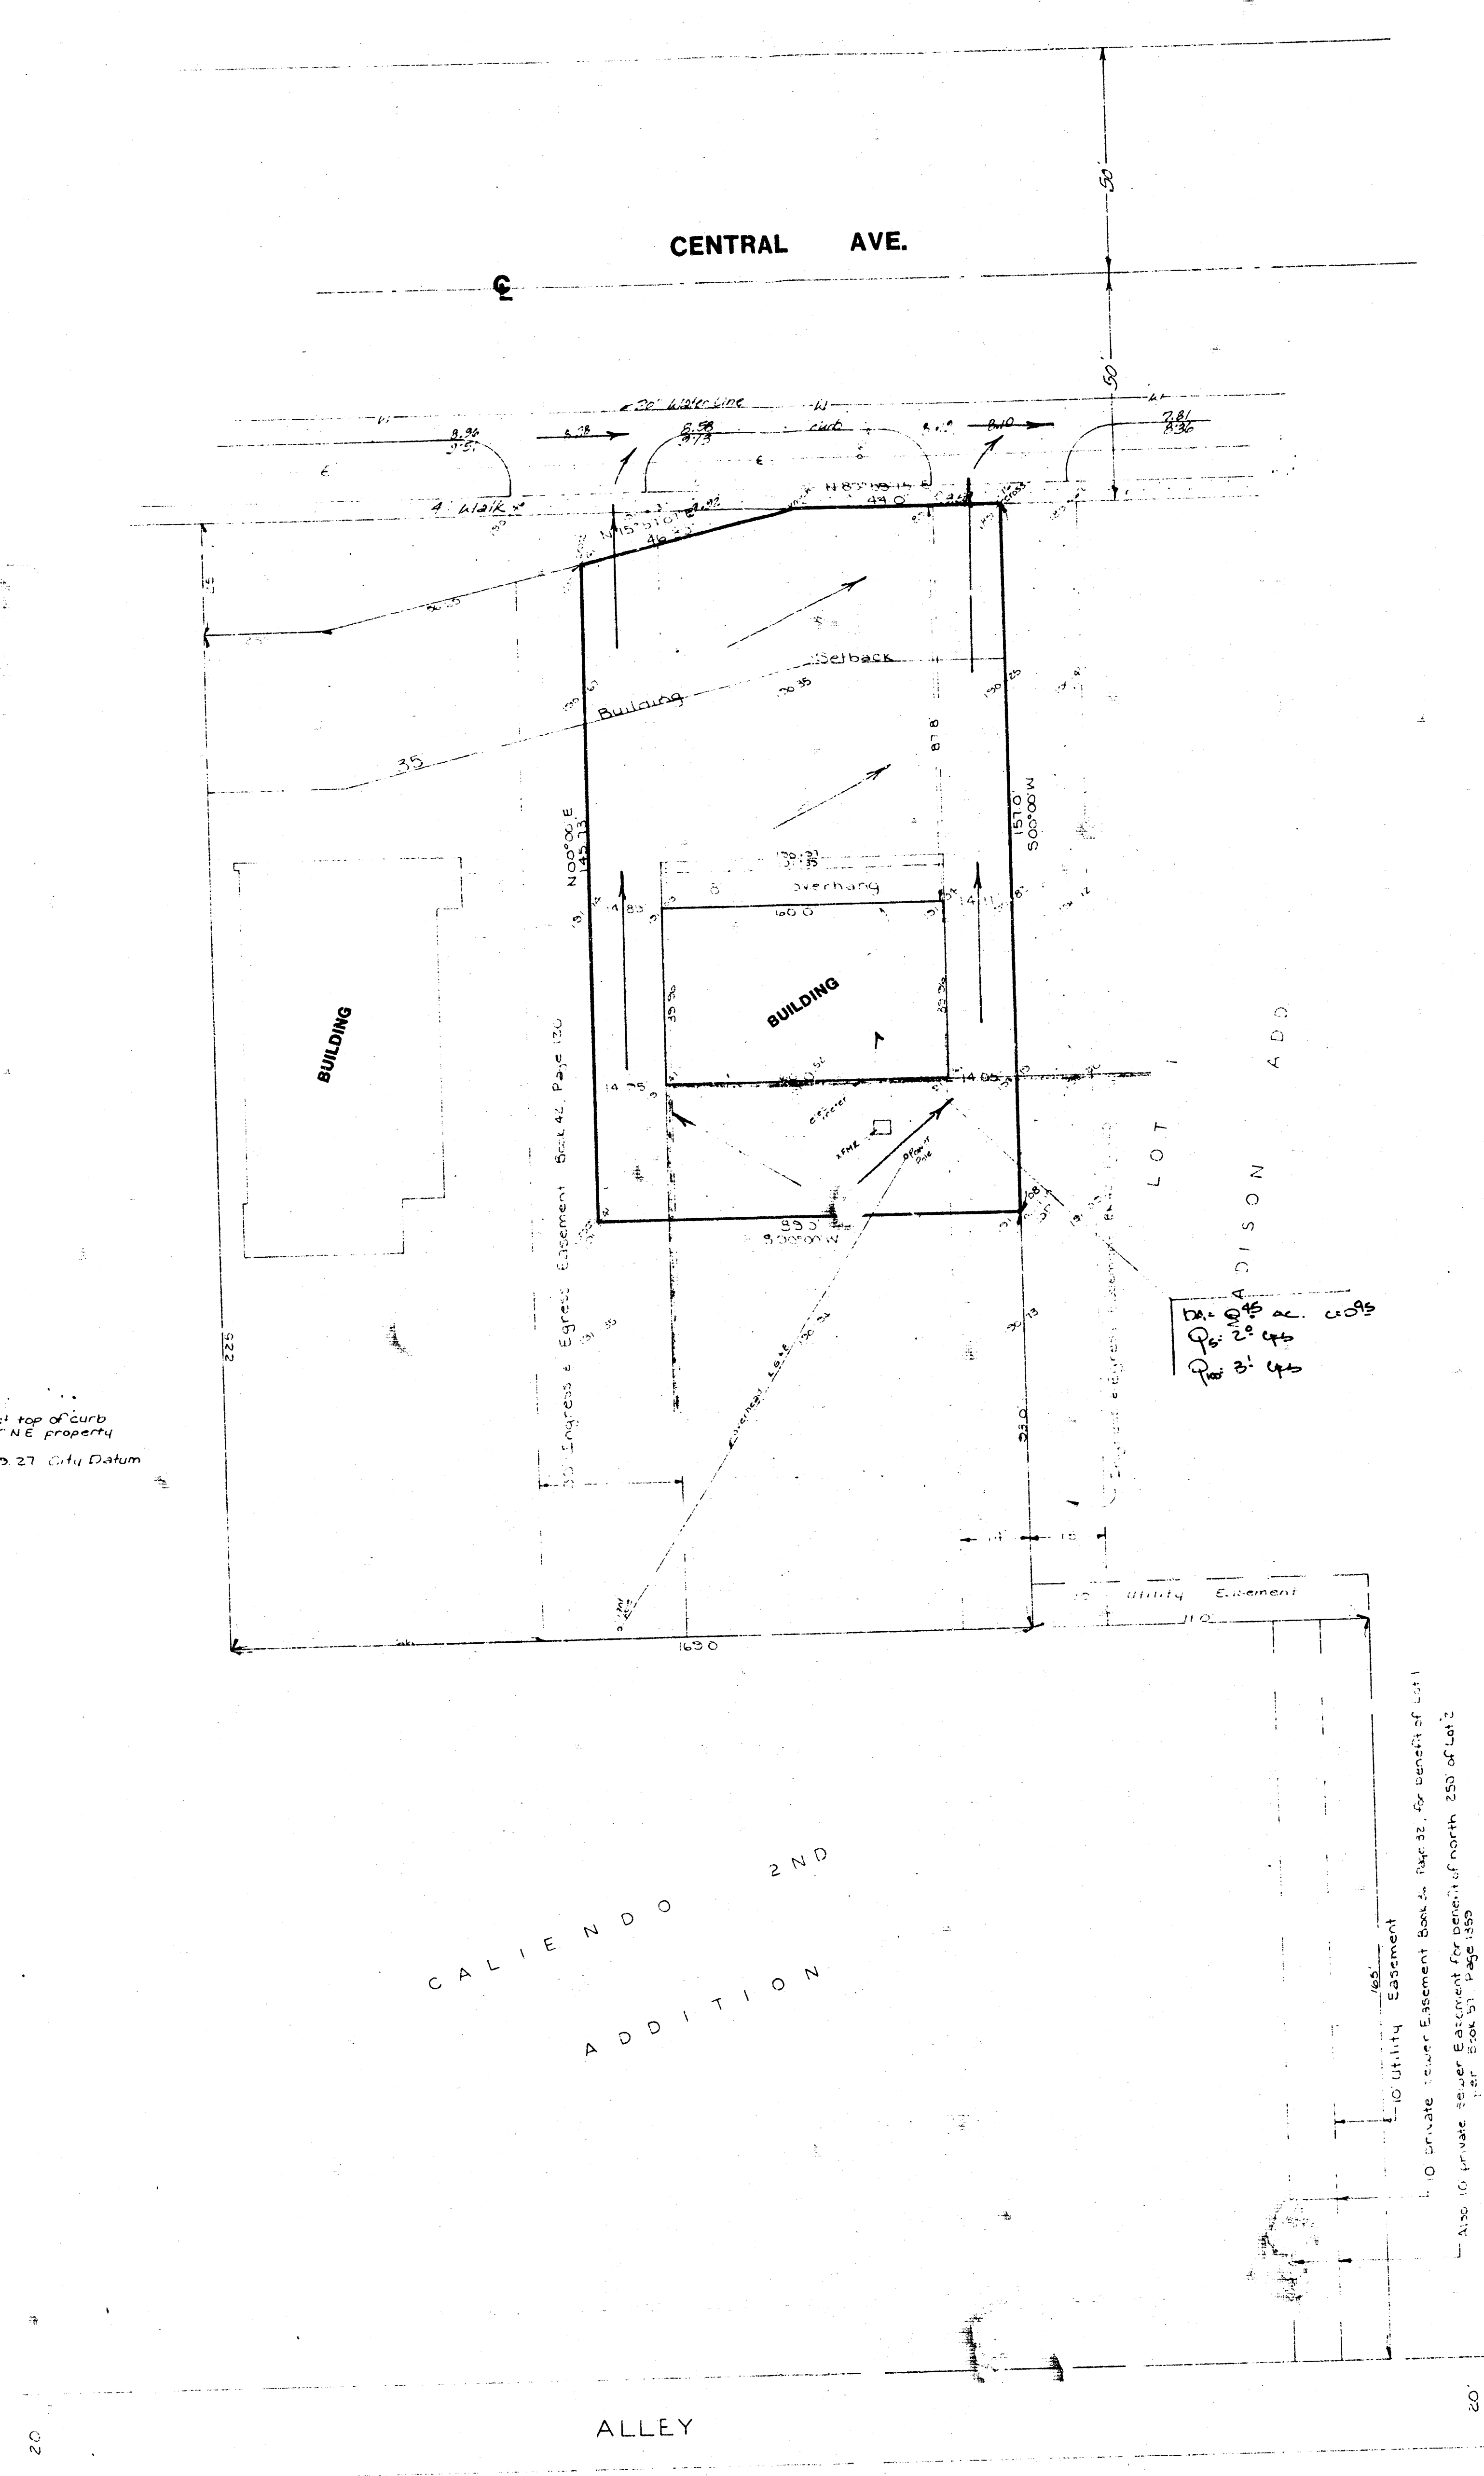

SKETCH PLAT

SCHLOTZSKY'S ADDITION

REPLAT OF PART OF LOT 2, MADISON ADDITION, WICHITA, KANSAS

OWNER: MICHAEL J. BOYD

DRAINAGE PLAN

BAUGHMAN COMPANY, P.A.
SURVEYING & ENGINEERING
316 265-7271 • 316 ELLIS • WICHITA, KANSAS 67211

April 21, 2011