



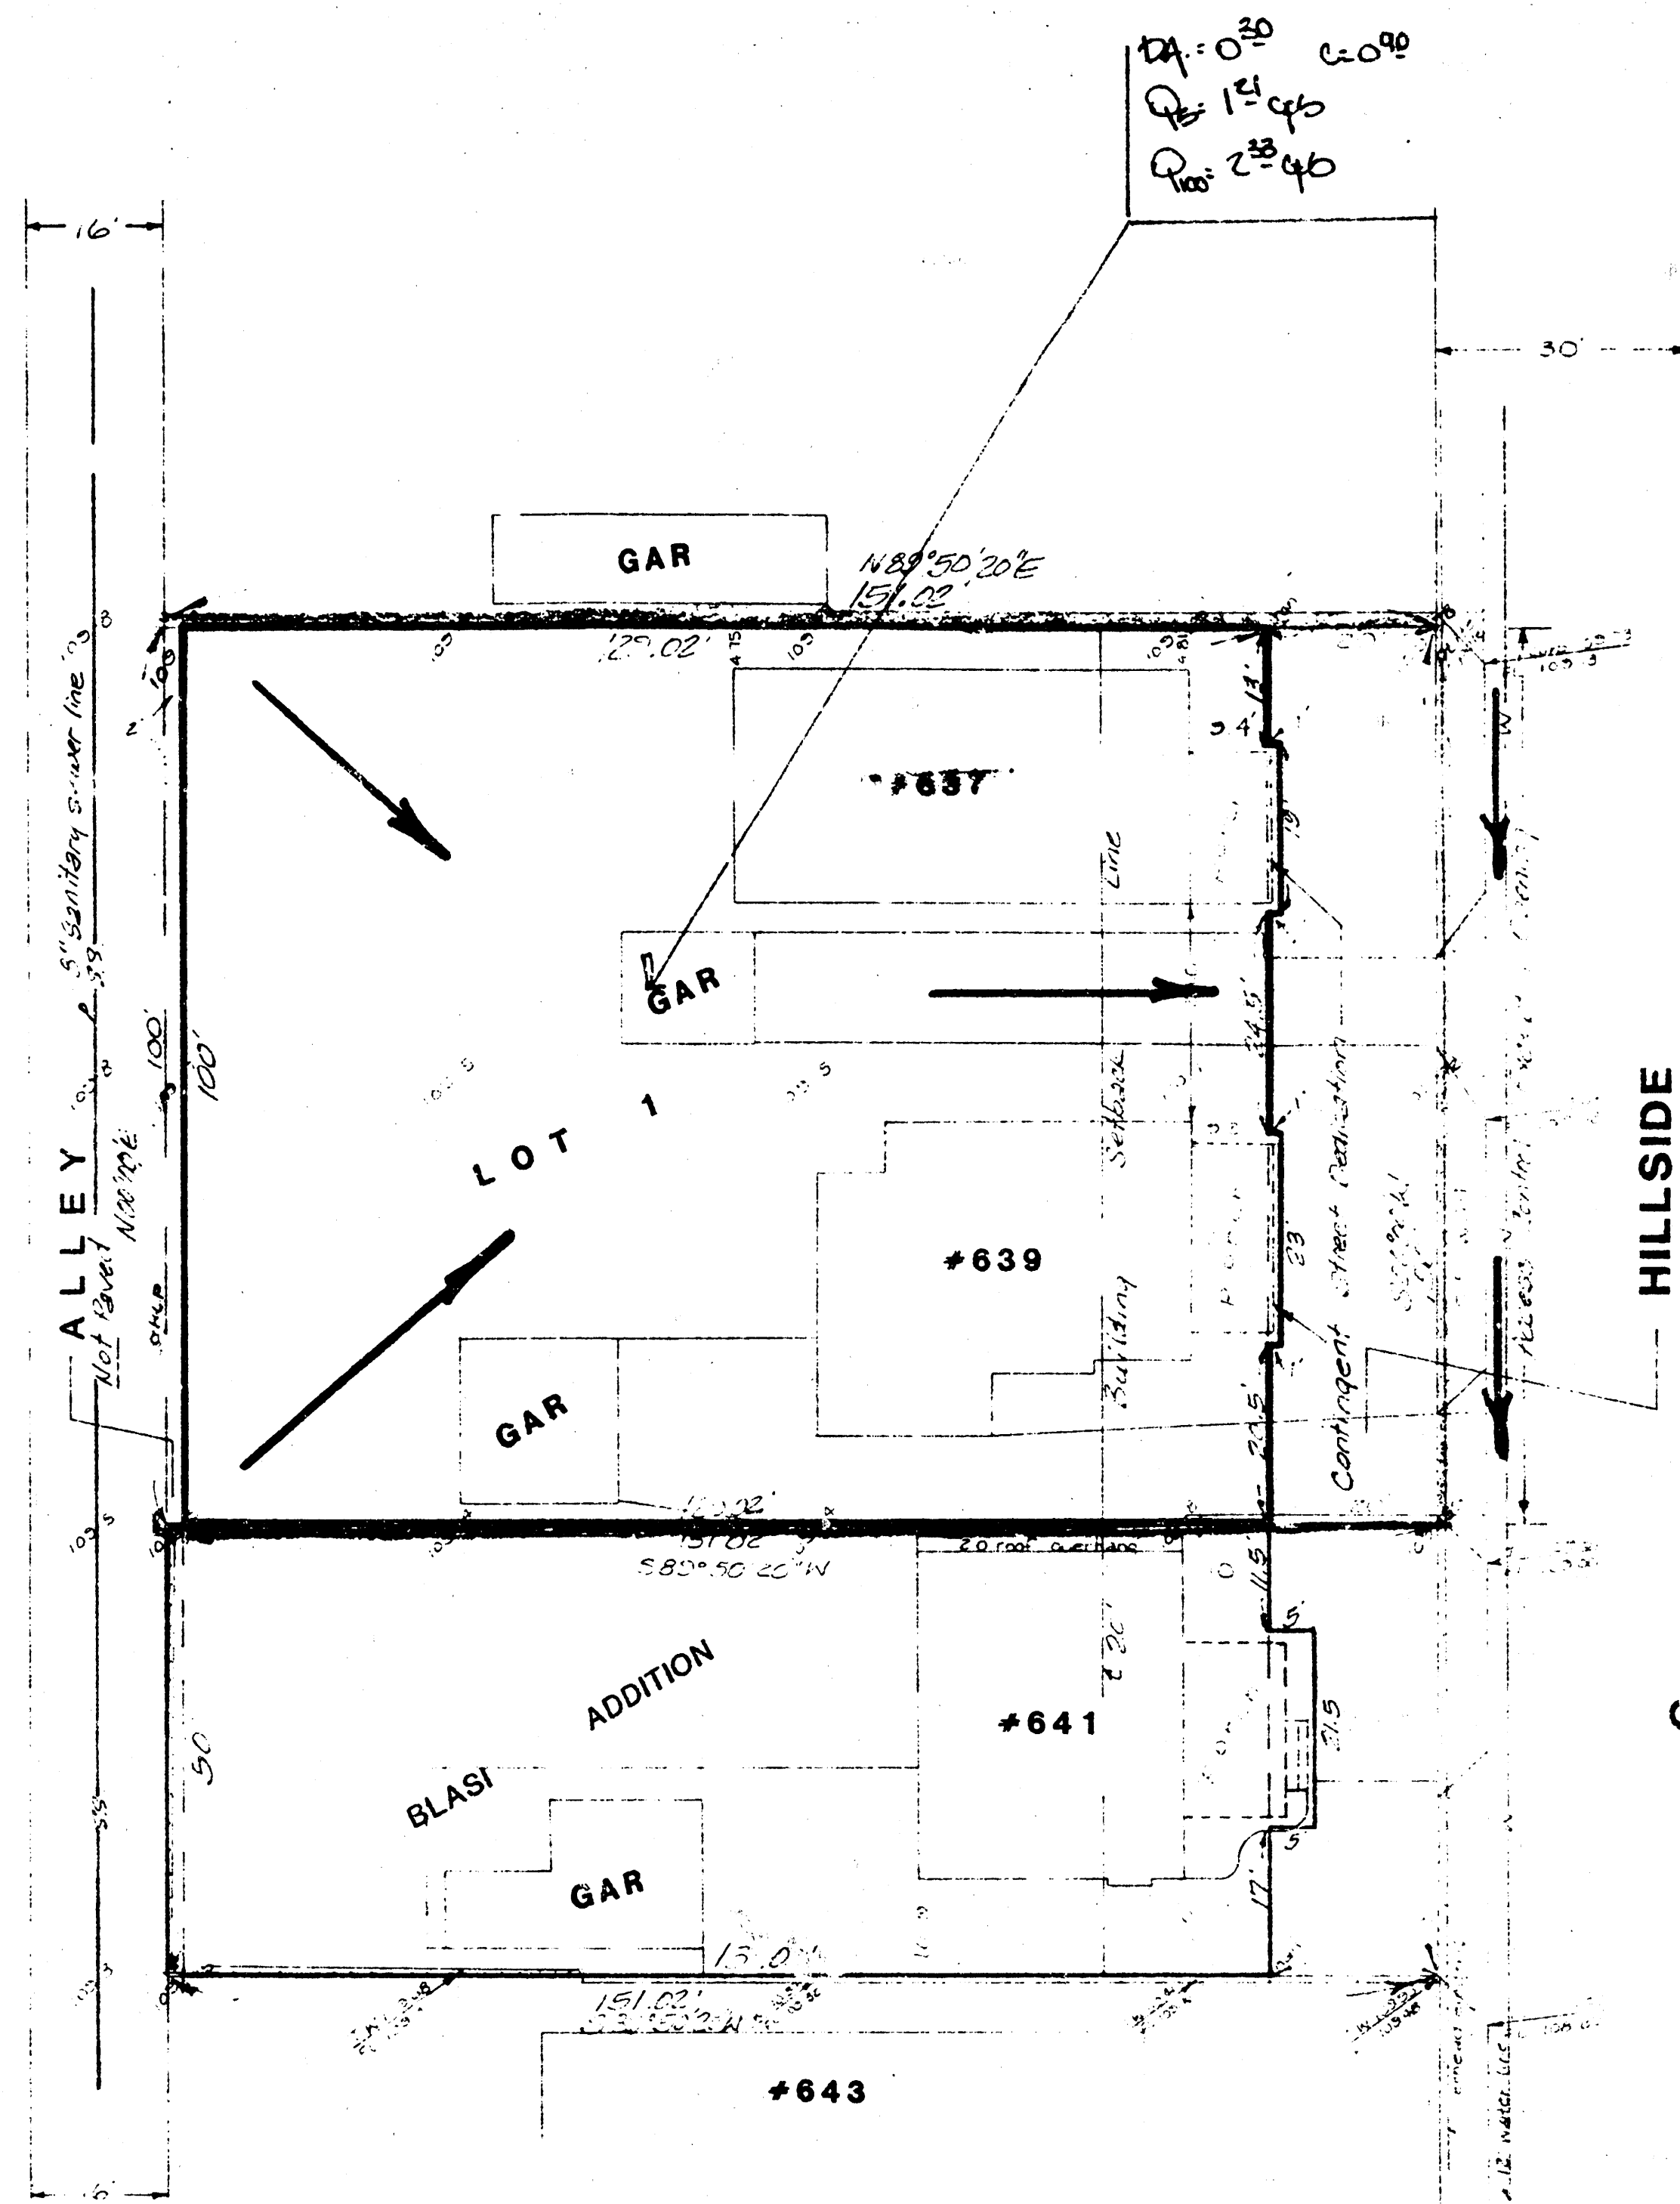

Bench Marks:
1. Cut on top of west curb on
south end of Hillside
43.1 feet south of 1st of Orme
Elev. 510.72 - 1st Datum

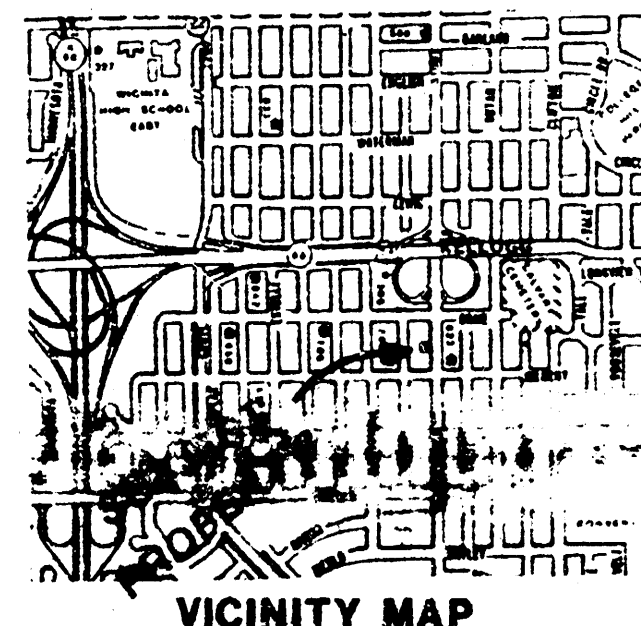

SKETCH PLAT

SCHUYLER ADDITION

LOTS 73, 75, 77, AND 79, BLOCK 8, SUNNY-SIDE ADDITION, WICHITA, KANSAS

OWNERS:

MARK W. AND ERIN S. SCHUYLER

**APPROVED
DRAINAGE PLAN**

DRAINAGE PLAN

BAUGHMAN COMPANY, P.A.
SURVEYING & ENGINEERING
316262-7271 • 315 ELLIS • WICHITA, KANSAS 67211