


DRAINAGE PLAN FOR SOUTH PARK 2ND. ADDITION

SOUTH PARK 2ND ADDITION
(Drainage)

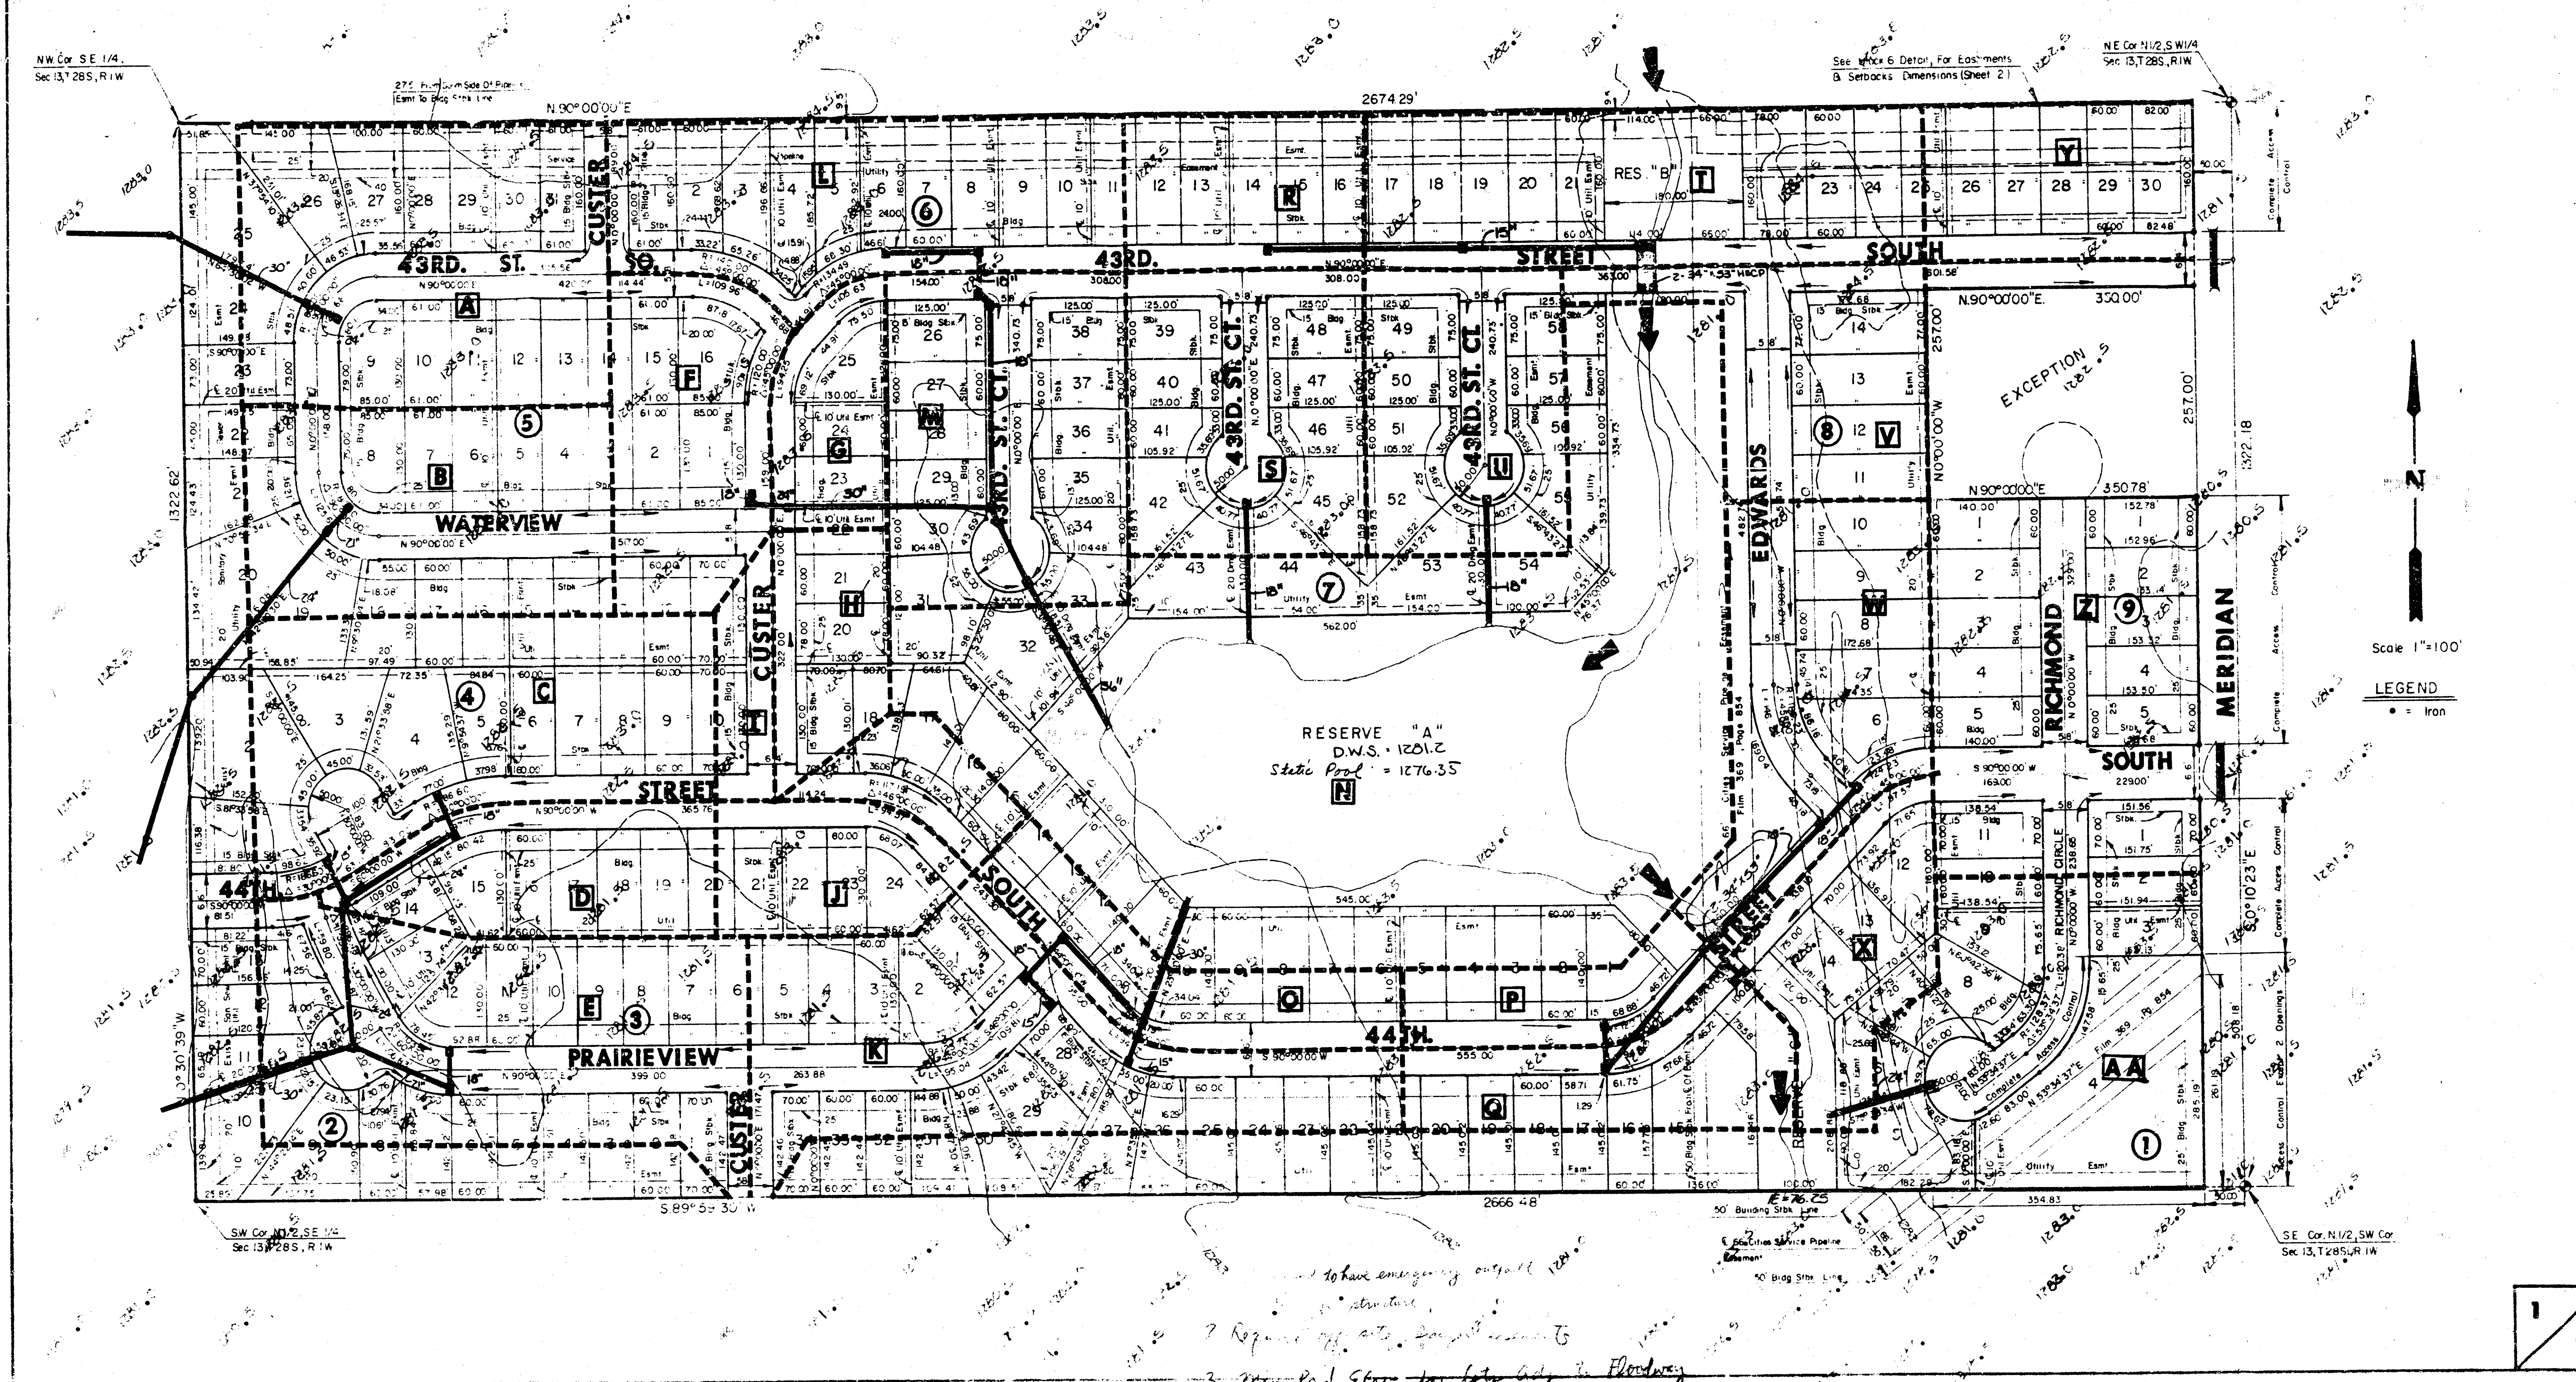


