


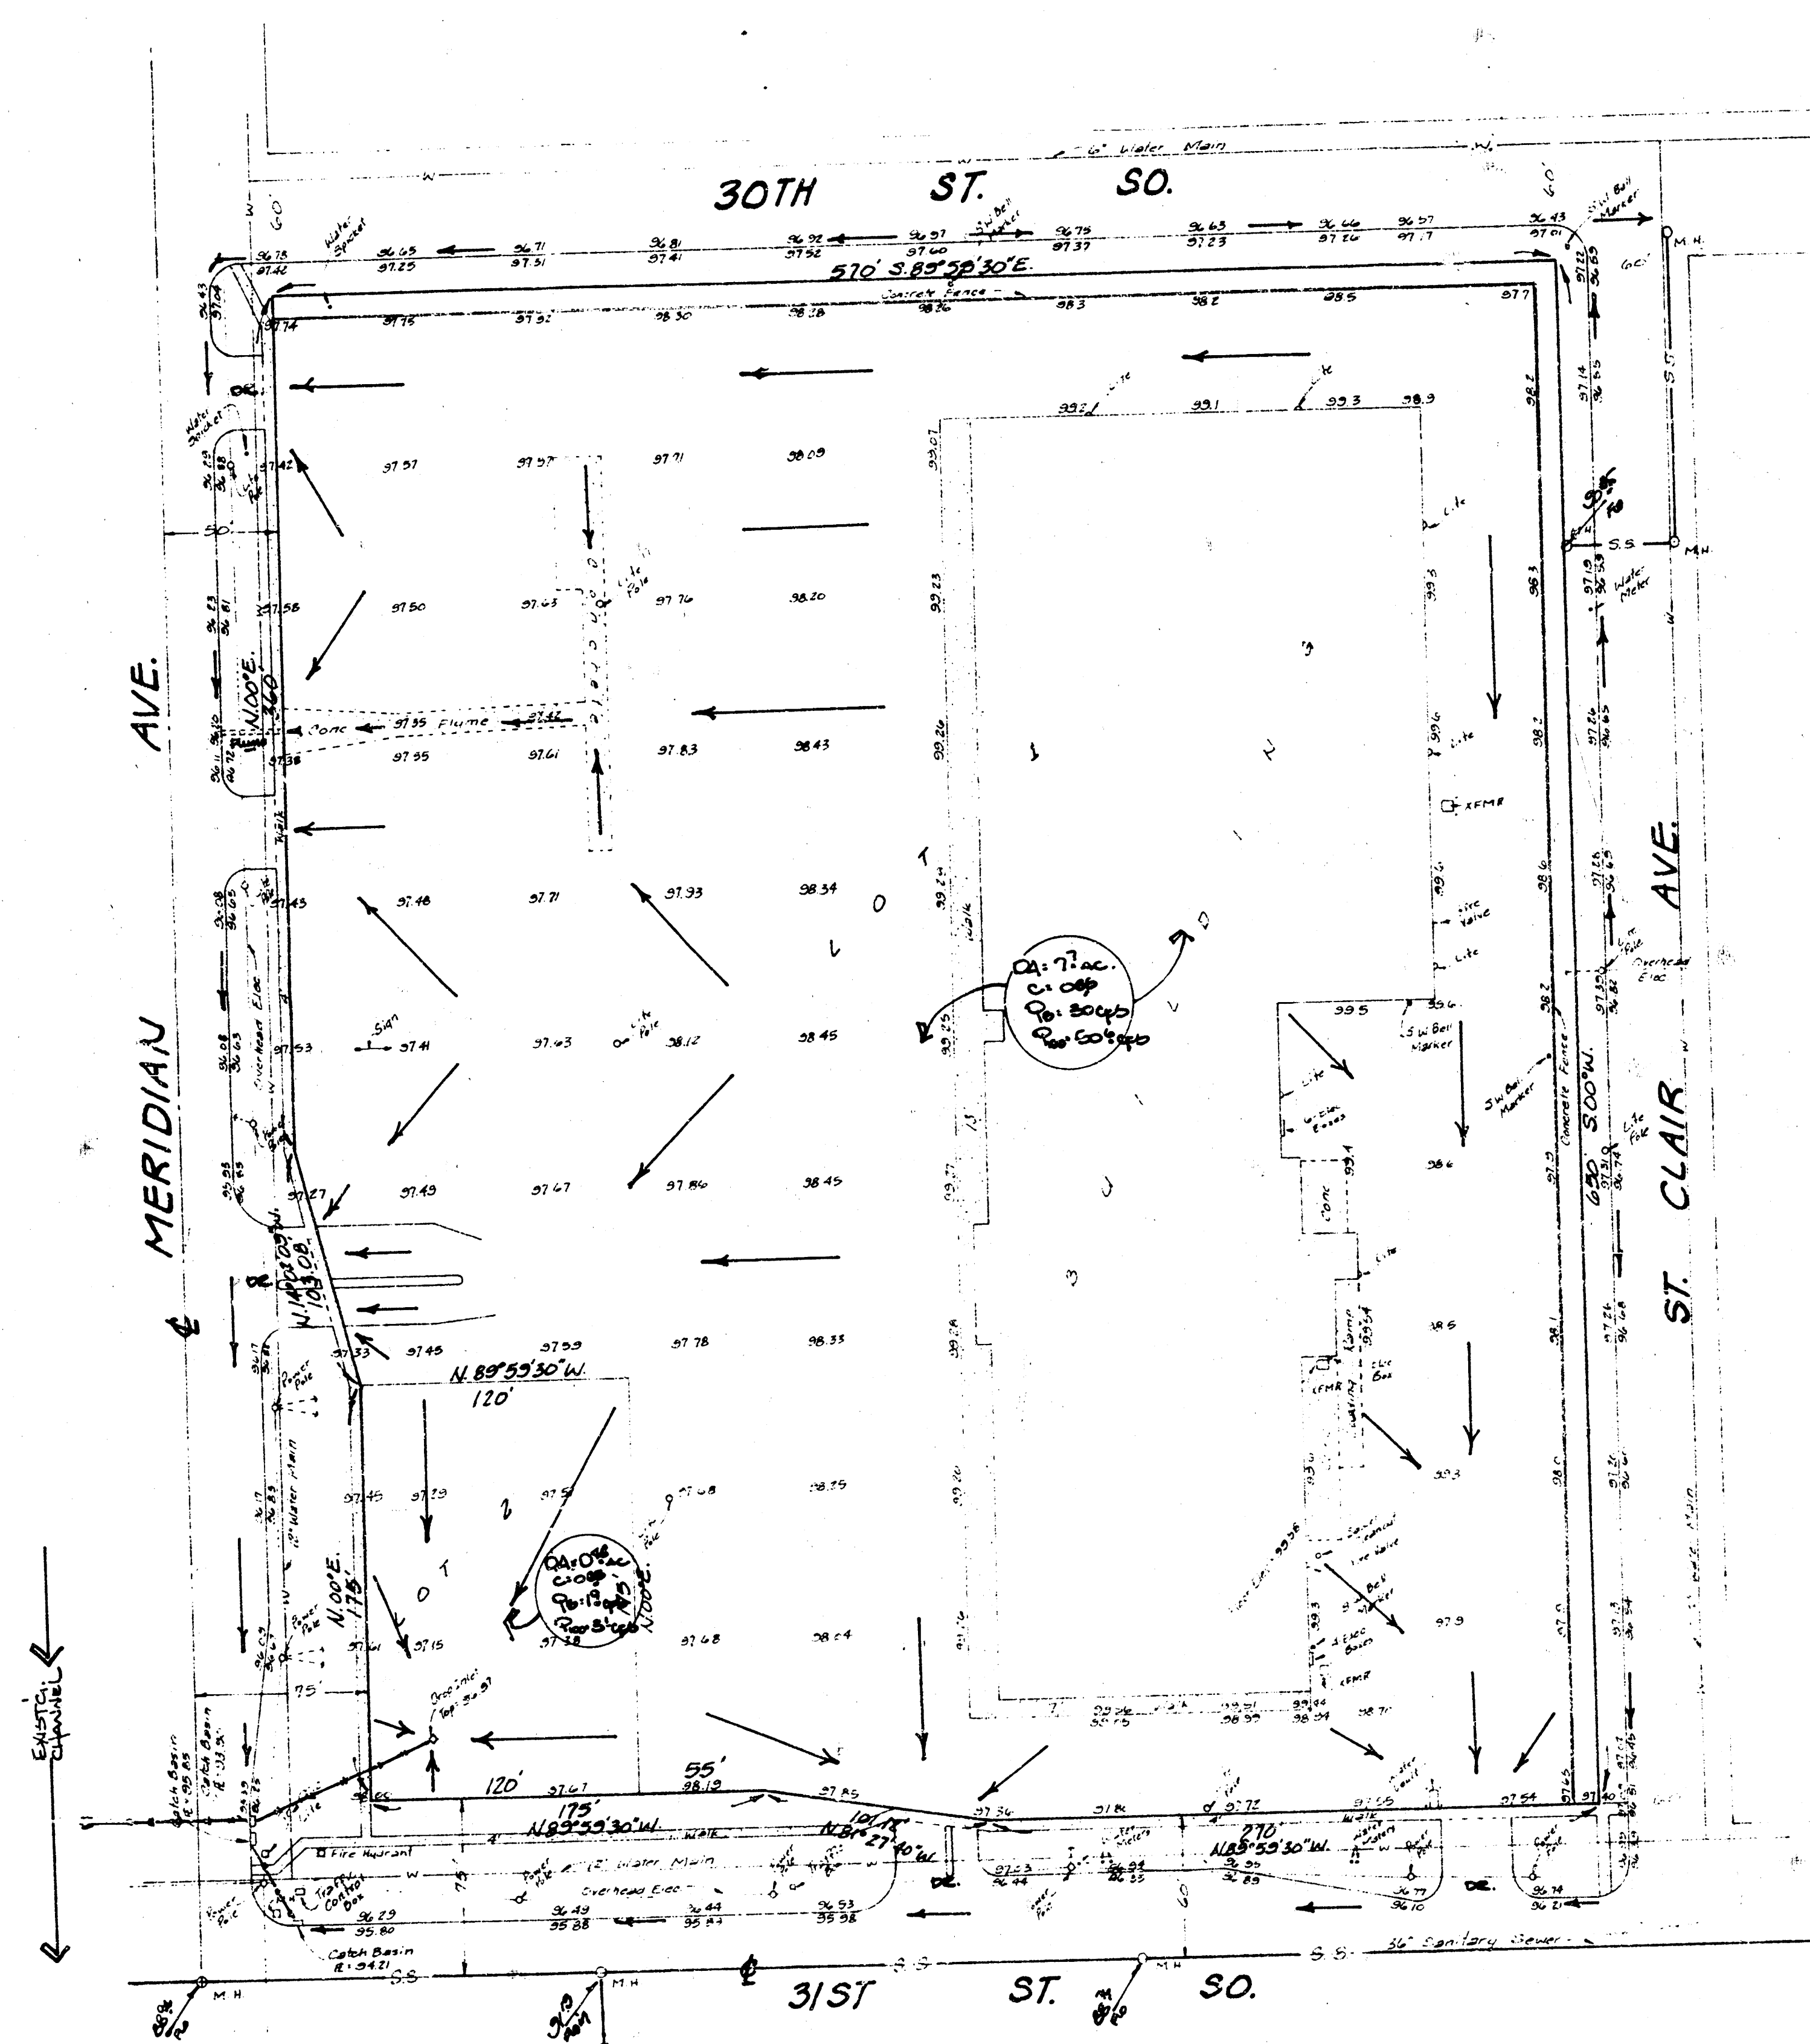

SKETCH PLAT

SOUTHWEST PLAZA 2ND

REPLAT OF LOT 1, SOUTHWEST PLAZA

OWNER: M. K. GENTRY % M. K. GENTRY CO.

DRAINAGE PLAN

FEB. 13, 1987

GENERAL NOTES

[illegible]

BAUGHMAN COMPANY, P.A.
SURVEYING & ENGINEERING
316-262-7271 • 315 ELLIS • WICHITA, KANSAS 67211



13 Feb 1987