


SUTHERLAND LUMBER NORTH ADDITION
(Drainage)

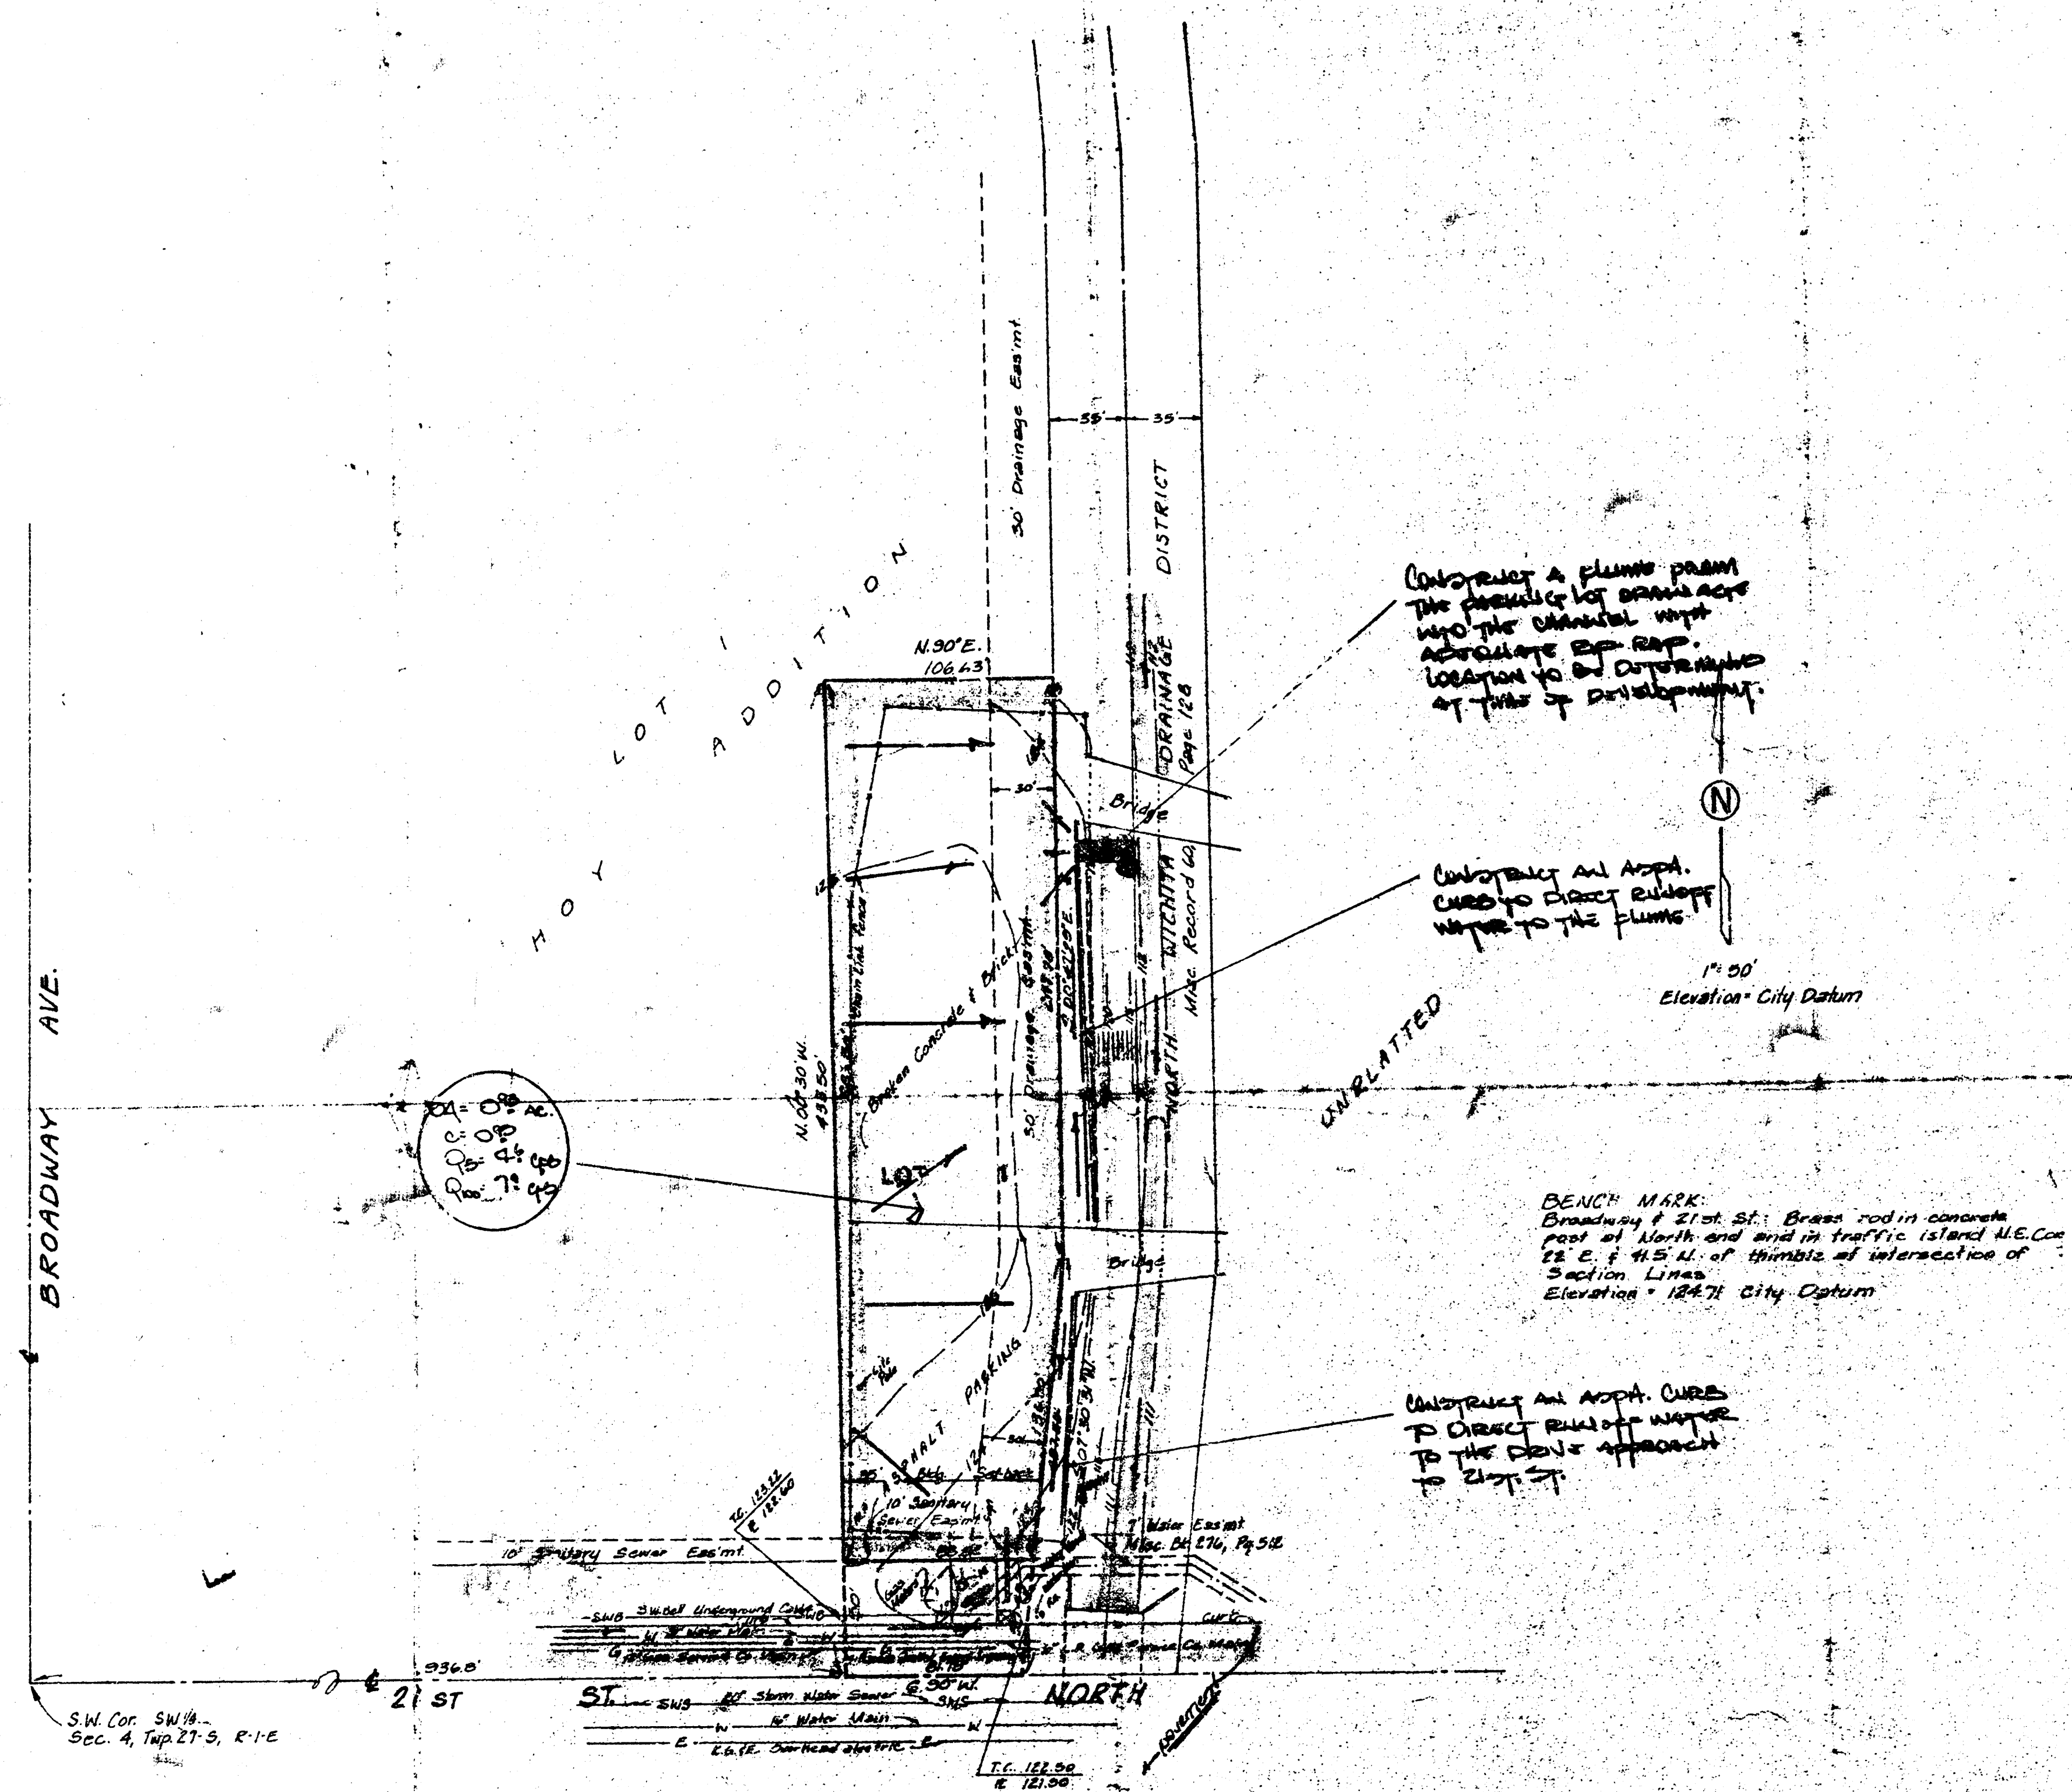

SKETCH PLAT

SUTHERLAND LUMBER NORTH

PART OF THE S 1/2 OF THE SW 1/4 OF THE SW 1/4 OF
SEC. 4, TWP. 27-S, R-1-E

SUTHERLAND LUMBER, A KANSAS LIMITED PARTNERSHIP

DRAINAGE PLAN

RECEIVED
DEC 4 1958
S.D.S. DIVISION

LAUGHMAN COMPANY, P.A.