
T-3 ADDITION
(Drainage)

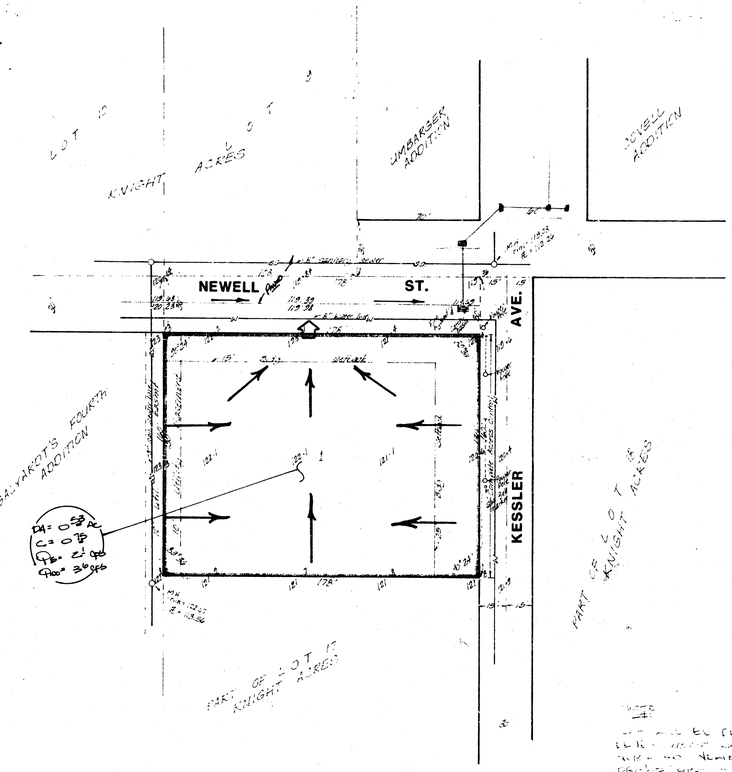

N

1"=30'

Benchmark:
R.R. spike in north side 24" H.C.P. at S.E. corner of Knight & St. Louis
Elev = 1104.45 City Datum

Drain against natural grade

SKETCH PLAT

T-S ADDITION

The north 160 feet of Lot 17, Knight Acres, Sedgwick County, Kansas, except the east 15 feet thereof for street

Owner:
Thomas N. Tuttle

DRAINAGE PLAN

BAUGHMAN COMPANY, P.A.
SURVEYING & ENGINEERING
316/262-7271 • 330 LAURA • WICHITA, KANSAS 67211

Aug 31 1996