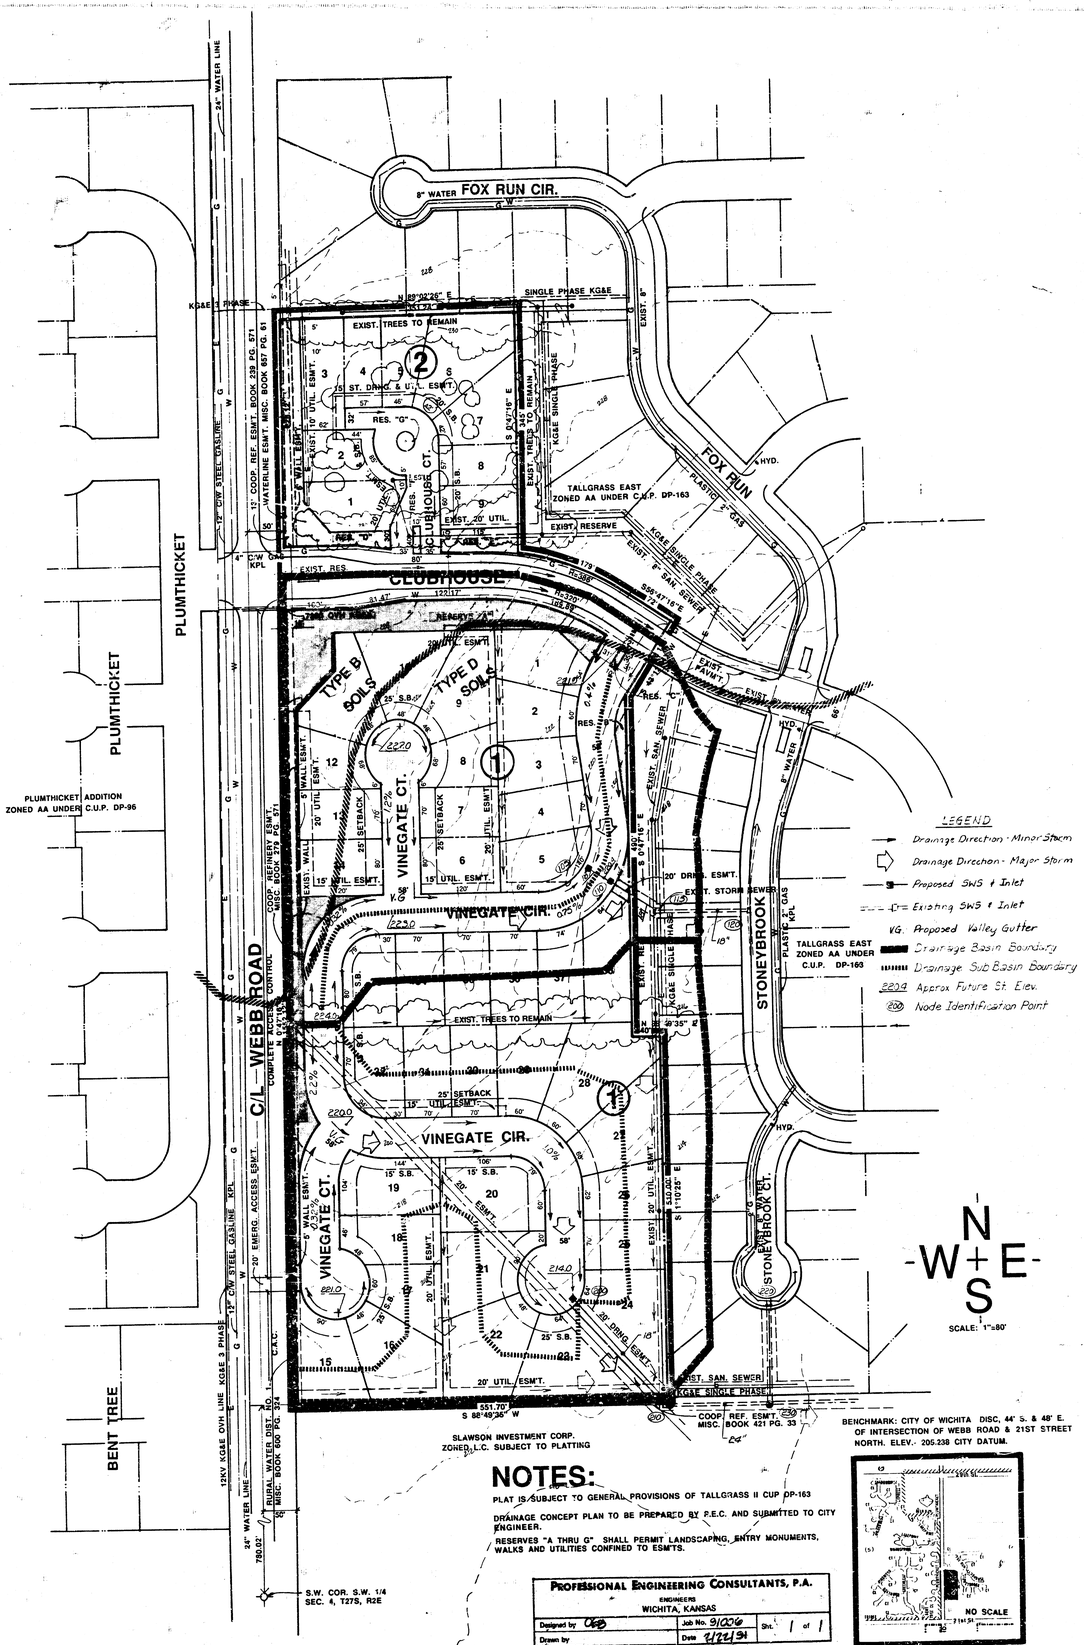


NOTES:

PLAT IS SUBJECT TO GENERAL PROVISIONS OF TALLGRASS II CUP DP-163

DRAINAGE CONCEPT PLAN TO BE PREPARED BY P.E.C. AND SUBMITTED TO CITY ENGINEER.

RESERVES "A THRU G" SHALL PERMIT LANDSCAPING, ENTRY MONUMENTS, WALKS AND UTILITIES CONFINED TO ESM'TS.

PROFESSIONAL ENGINEERING CONSULTANTS, P.A.
ENGINEERS
WICHITA, KANSAS

Designed by CEB	Job No. 91006	Sht. 1 of 1
Drawn by	Date 2/22/91	

LOCATION MAP

DRAINAGE PLAN 2/22/91

A REPLAT OF A PORTION OF TALLGRASS EAST ADDITION.

TALLGRASS EAST 5TH ADDITION


OWNER: RITCHIE ASSOCIATES, 8100 E. 22ND ST. NO. BLD. 1000, WICHITA, KANSAS 67226

CHARLES E. BROWN LICENSED 7581 KANSAS PROFESSIONAL ENGINEER

3.1.91

TALLGRASS EAST 5TH ADDITION

TO WICHITA, SEDGWICK COUNTY, KANSAS

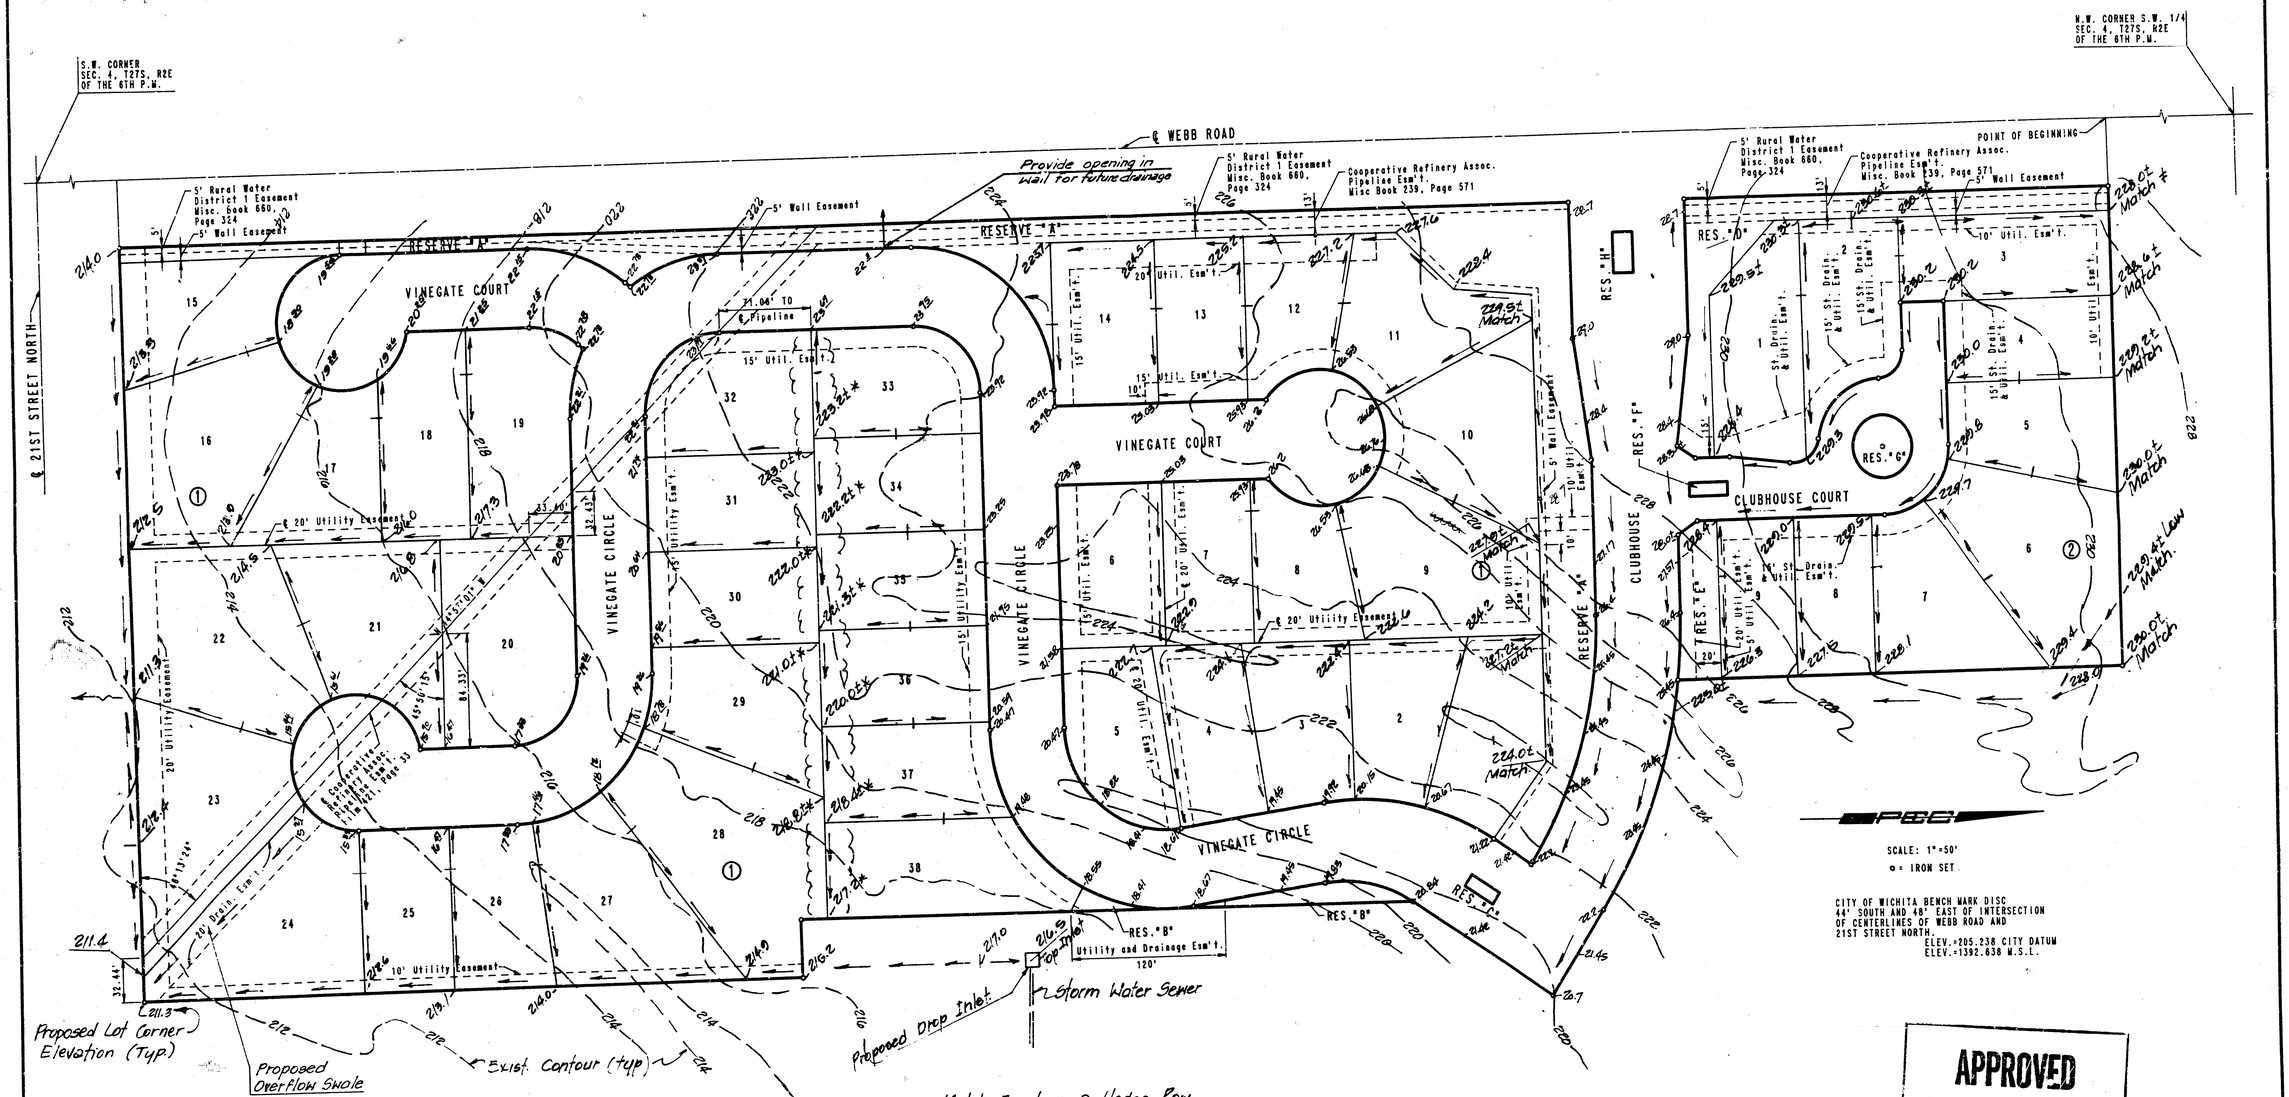

* Match Existing @ Hedge Row

≠ Provide Opening For drainage under wall

APPROVED DRAINAGE PLAN

164'E"

Nov. 14, 1991
July 23, 1991
Rev. May 15, 1991
April, 1991. DETAILED DRAINAGE PLAN