



*Final  
No Drainage  
Plan was found*

**PRELIMINARY PLAT**  
**TALLGRASS INN**

OWNER: TALLGRASS COMPANY, P.O. BOX 4040, WICHITA, KANSAS 67204

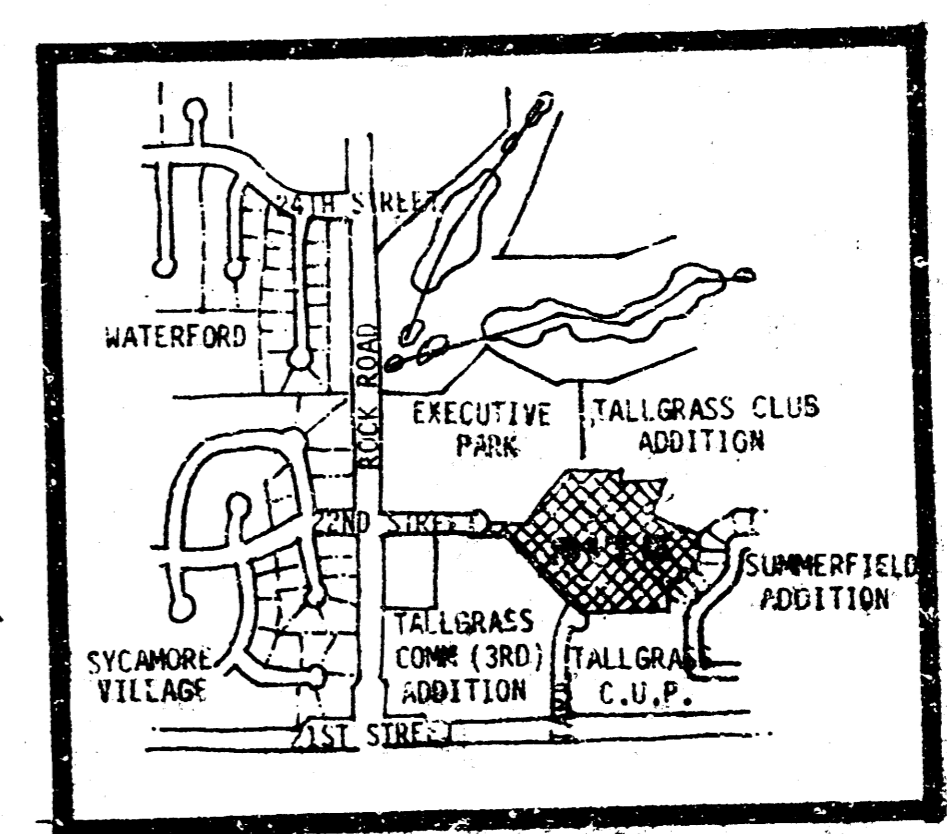

AREA MAP  
NO SCALE

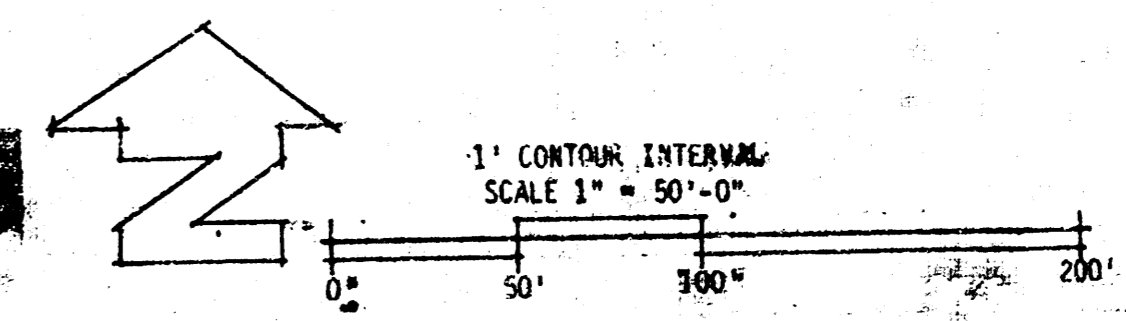

**BILL G. YUNG DESIGN**  
222 E. 35TH ST., NORTH, WICHITA, KS. 67208  
316-481-6437

date JUNE 24, 1993  
rev.

sheet title

project

sheet of