

Timber Chapel Addn

7

SKETCH PLAT


TIMBER CHAPEL ADDITION

WICHITA, SEDGWICK COUNTY, KANSAS.


Tract in the NW 1/4 of Sec. 12, Twp. 27-S, R-1-E of the 6th P.M.
Sedgwick County, Kansas.



Bench Mark:
Disc stamped 235, 1944, 36 feet
south and 35 feet west of the
centerlines of Oliver & 17th St. &
E. South of E.E. Signal light
Elev. = 221.08 City Datum

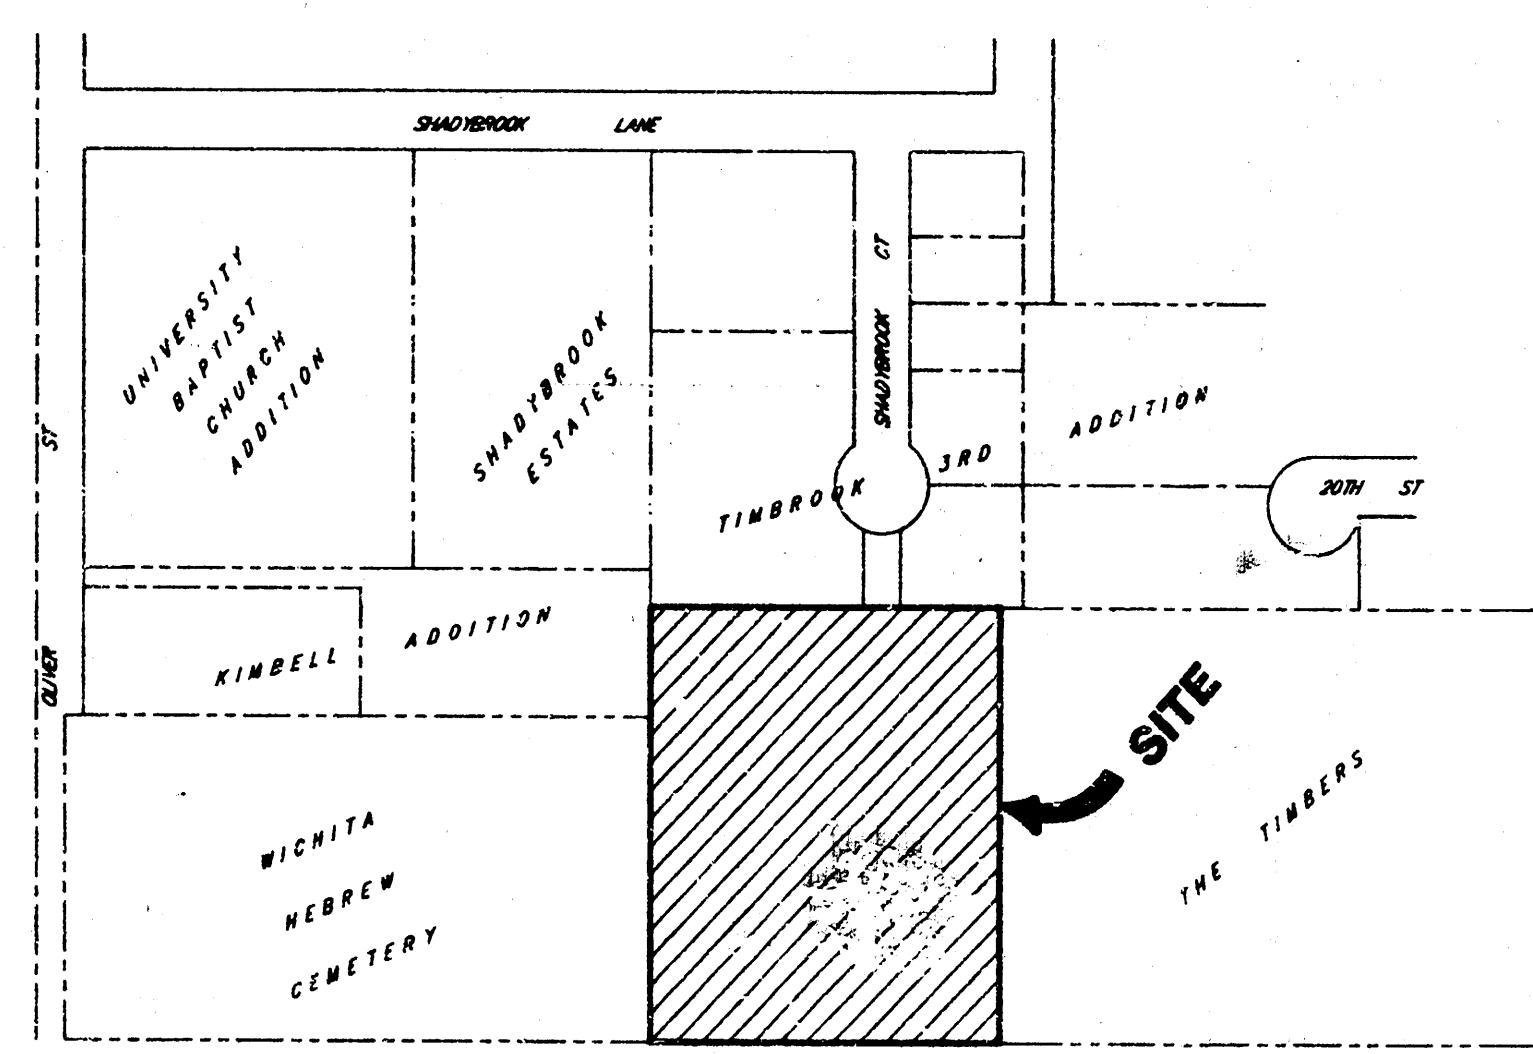

VICINITY MAP

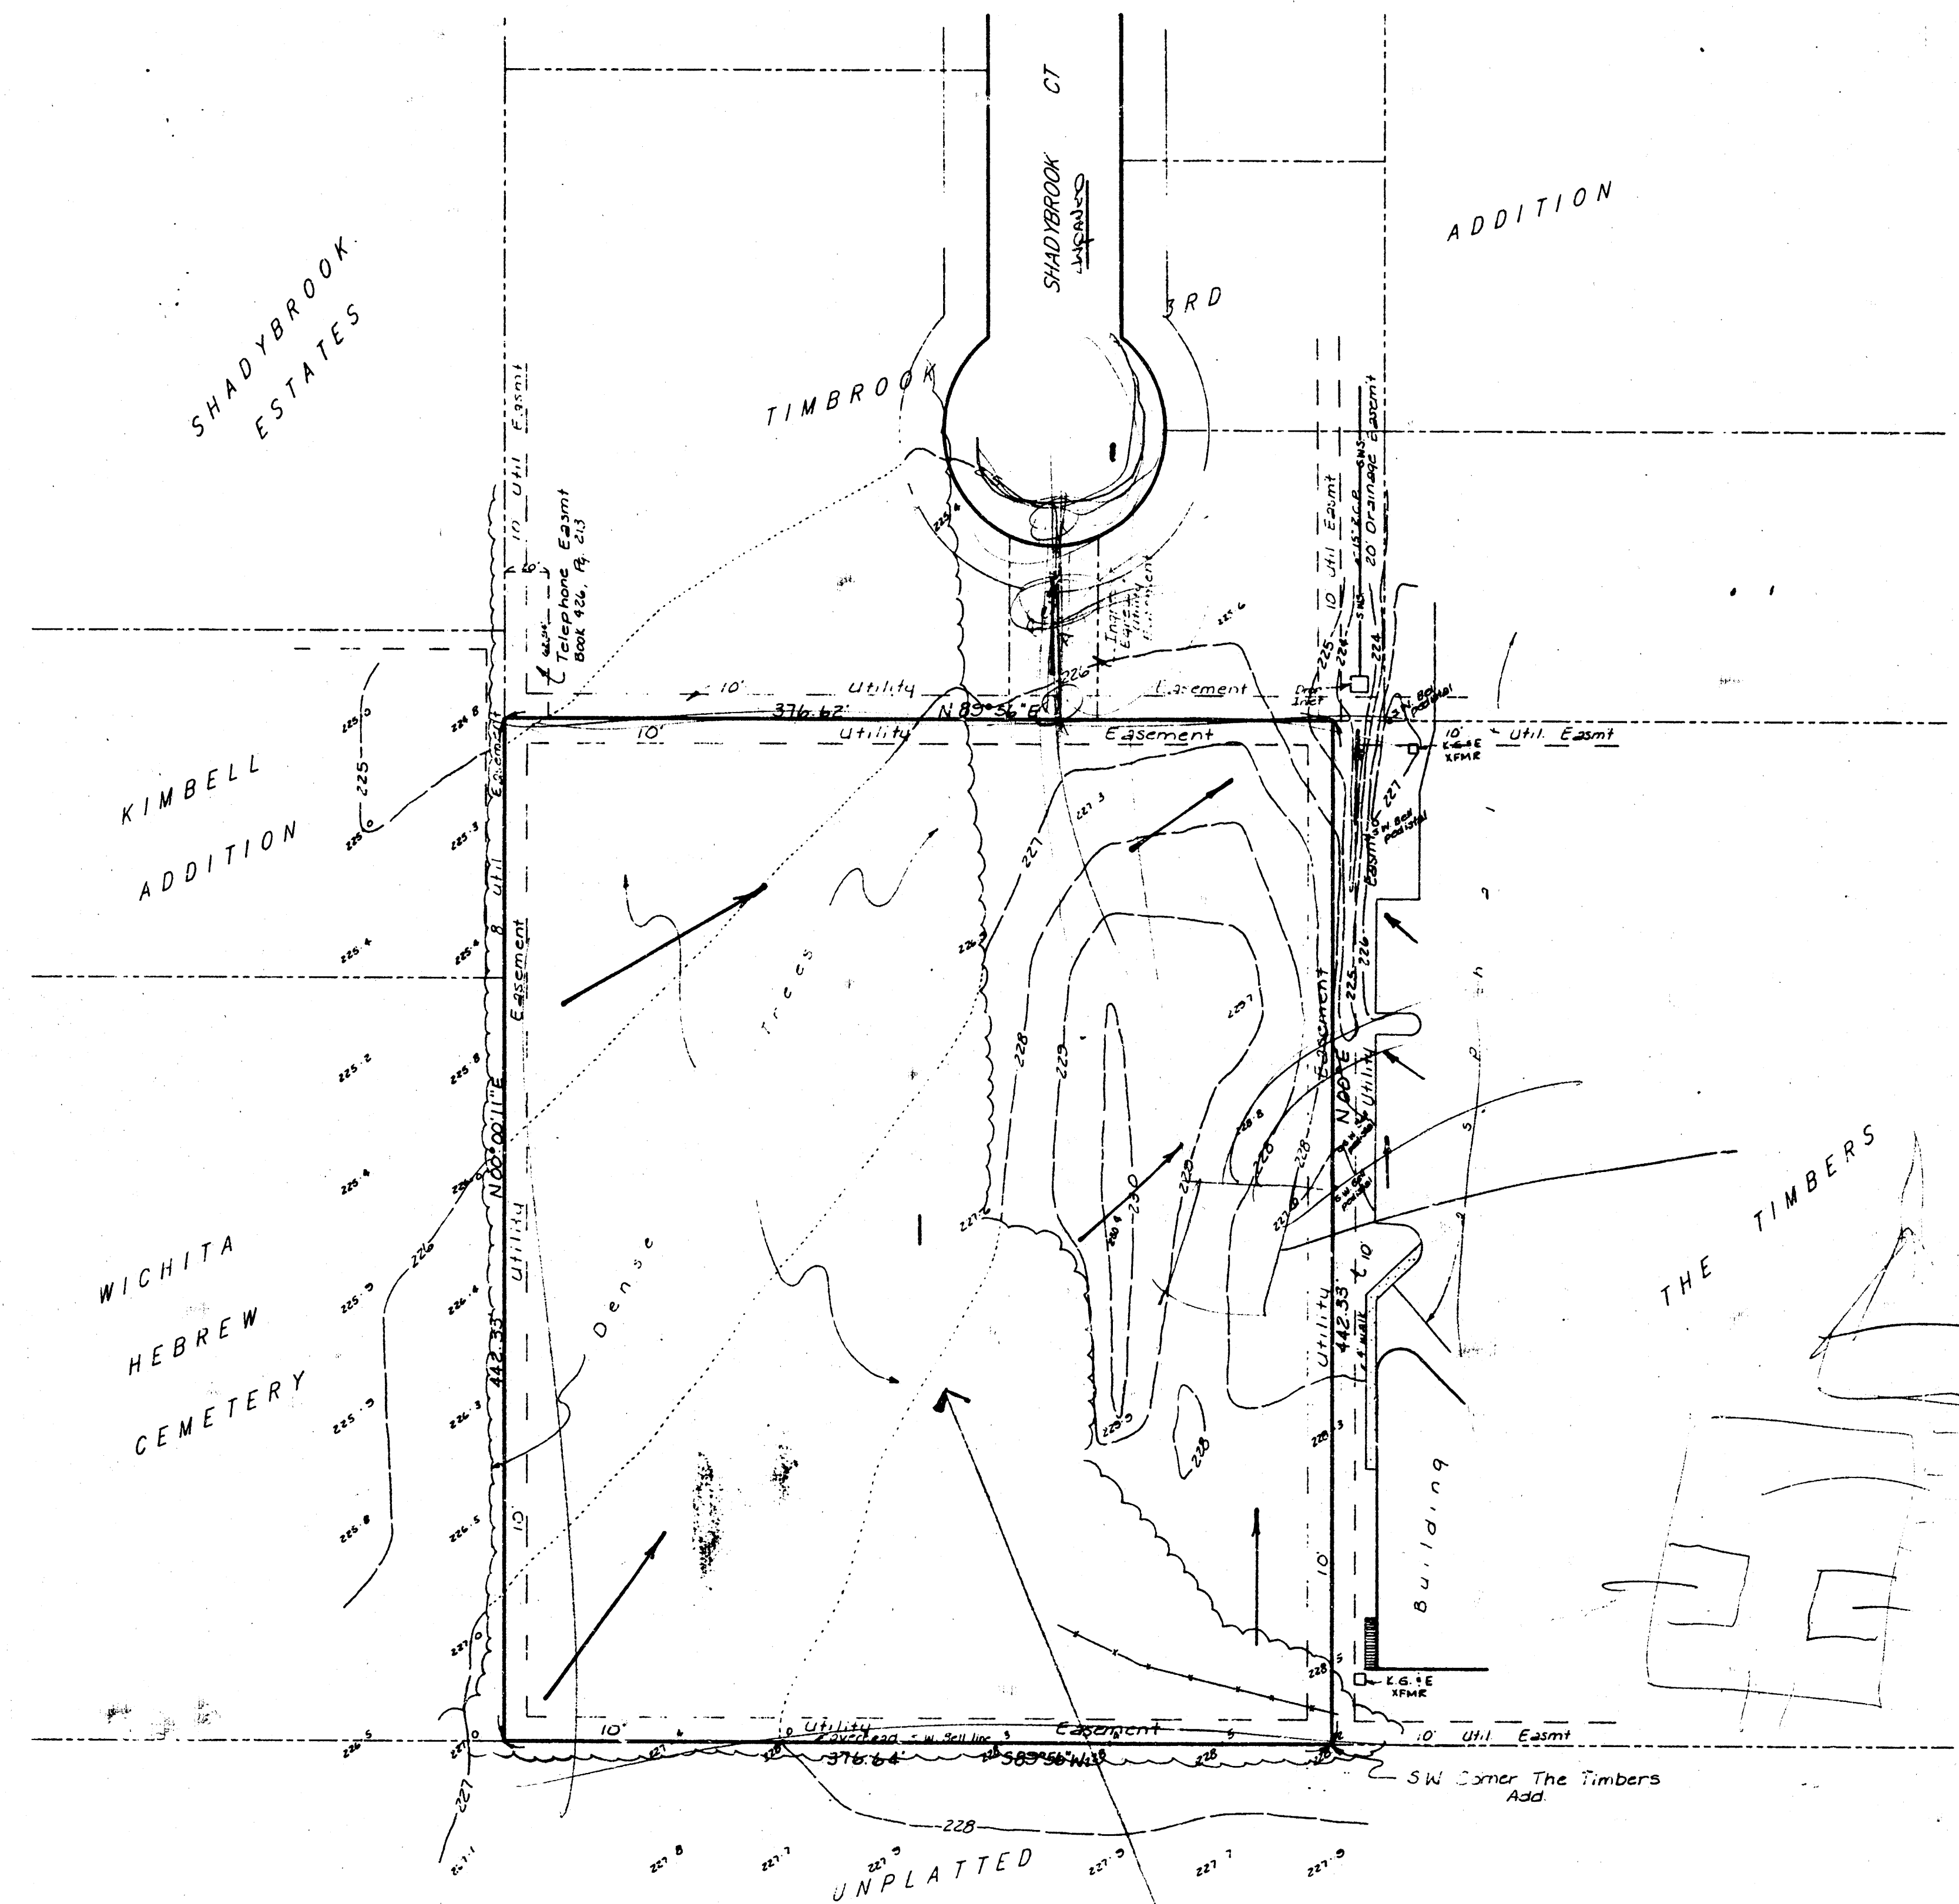

Note - This lot is to be developed as a small chapel
site - Very little of the area will be paved. Runoff
Runoff factor = 0.30. Runoff will be directed to the
center of lot to an existing storm sewer and drainage
into the city drainage system at the intersection.

DRAINAGE PLAN

BAUGHMAN COMPANY P. A.
SURVEYING & ENGINEERING
316/287-7271 • 315 ELLIS • WICHITA, KANSAS 67211