
THUNDERBIRD 3RD ADDITION
(Drainage)

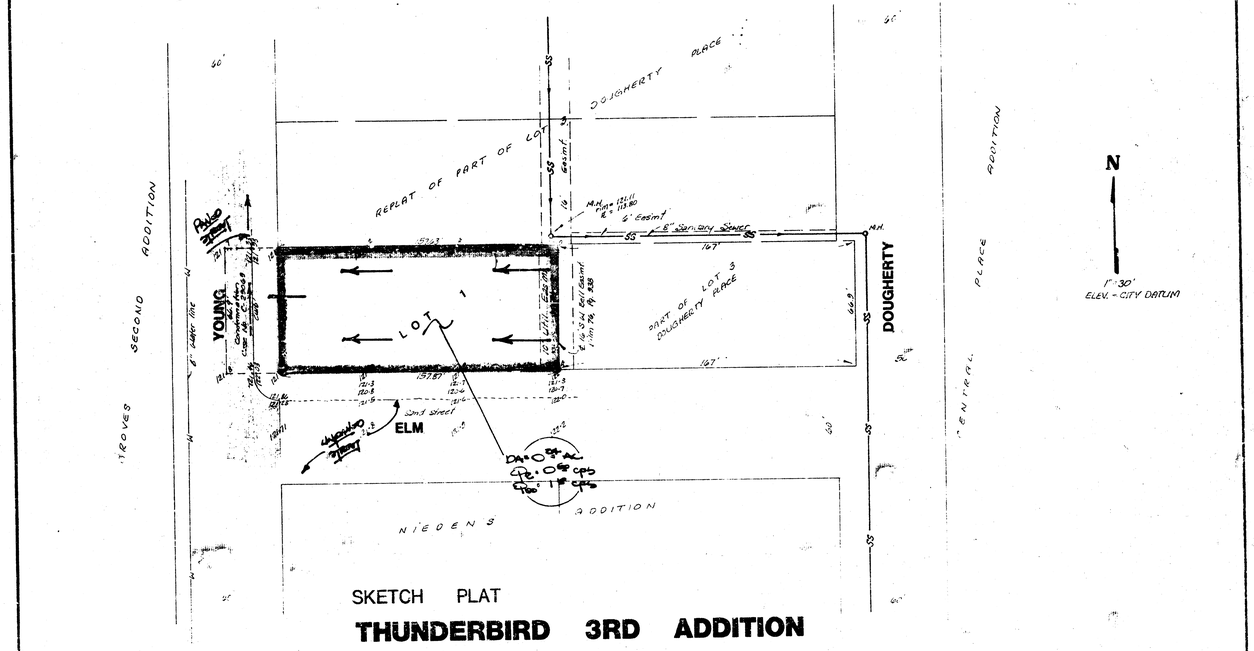

SKETCH PLAT

THUNDERBIRD 3RD ADDITION

PART OF LOT 3, DOUGHERTY PLACE, SEDGWICK COUNTY, KANSAS

EARL W. MILLER % DAVE ENTRIKEN

NOTE-
LOT WILL BE RESIDENTIAL WITH A RUNOFF FACTOR OF 0.60.
LOT WILL BE GRADED TO DRAIN WEST TO YOUNG STREET WITH THE DISCHARGE TO THE STREET THRU THE CURB.
STORM SEWERS EXIST ONE BLOCK WEST ON EMMA STREET.

DRAINAGE PLAN

BAUGHMAN COMPANY, P.A.
SURVEYING & ENGINEERING
316 262-7221 · 330 LAURA · WICHITA, KANSAS 67211