
THUNDERBIRD FOURTH ADDITION
(Drainage)

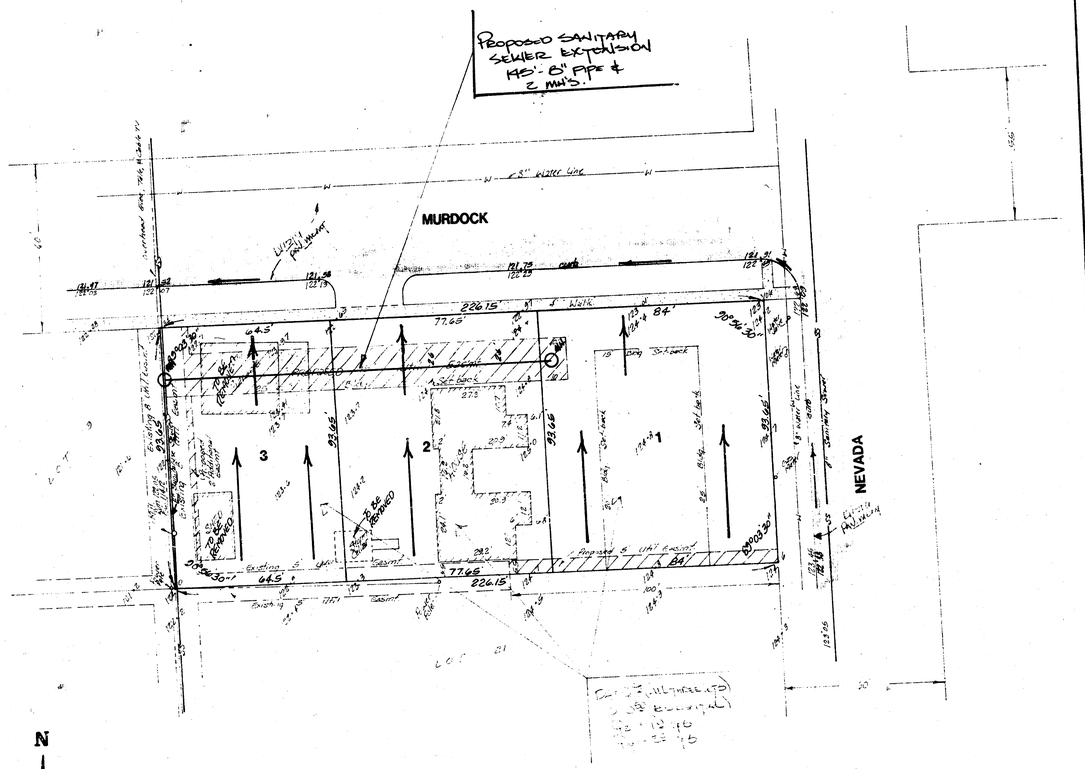

SKETCH PLAT

THUNDERBIRD 4TH ADDITION

LOT 22, REPLAT OF LOTS 3, 4, 5, 6, 7, 8, 9, CENTRAL PLACE ADDITION, SEDGWICK COUNTY, KANSAS.

OWNER: DAVID W. ENTRIKEN

DRAINAGE PLAN

1" = 20'
ELEV. = CITY DATUM

BENCH MARK:
Ctr. Standard Spec. 11 S 1 52 W of E west of E.S.H. 254
Elev. = 1283.89 City Datum

BENCH MARK: (Ctr)
"V" notch over iron at S.W. Cor. of Murdock & Nevada
Elev. = 1284.62 City Datum

GENERAL NOTES

The lots in this plat are to be residential lots with a runoff factor of 0.50 used in the calculations. The lots when developed will drain north to the pavement on Murdock which drains to the west. Discharge to the street will be thru driveways.

BAUGHMAN COMPANY, P.A.
SURVEYING & ENGINEERING
316 262-7271 • 330 LAURA • WICHITA, KANSAS 67211