


# DRAINAGE PLAN

## TIMBER GROVE LAKES COMMERCIAL ADDITION

### WICHITA, KANSAS

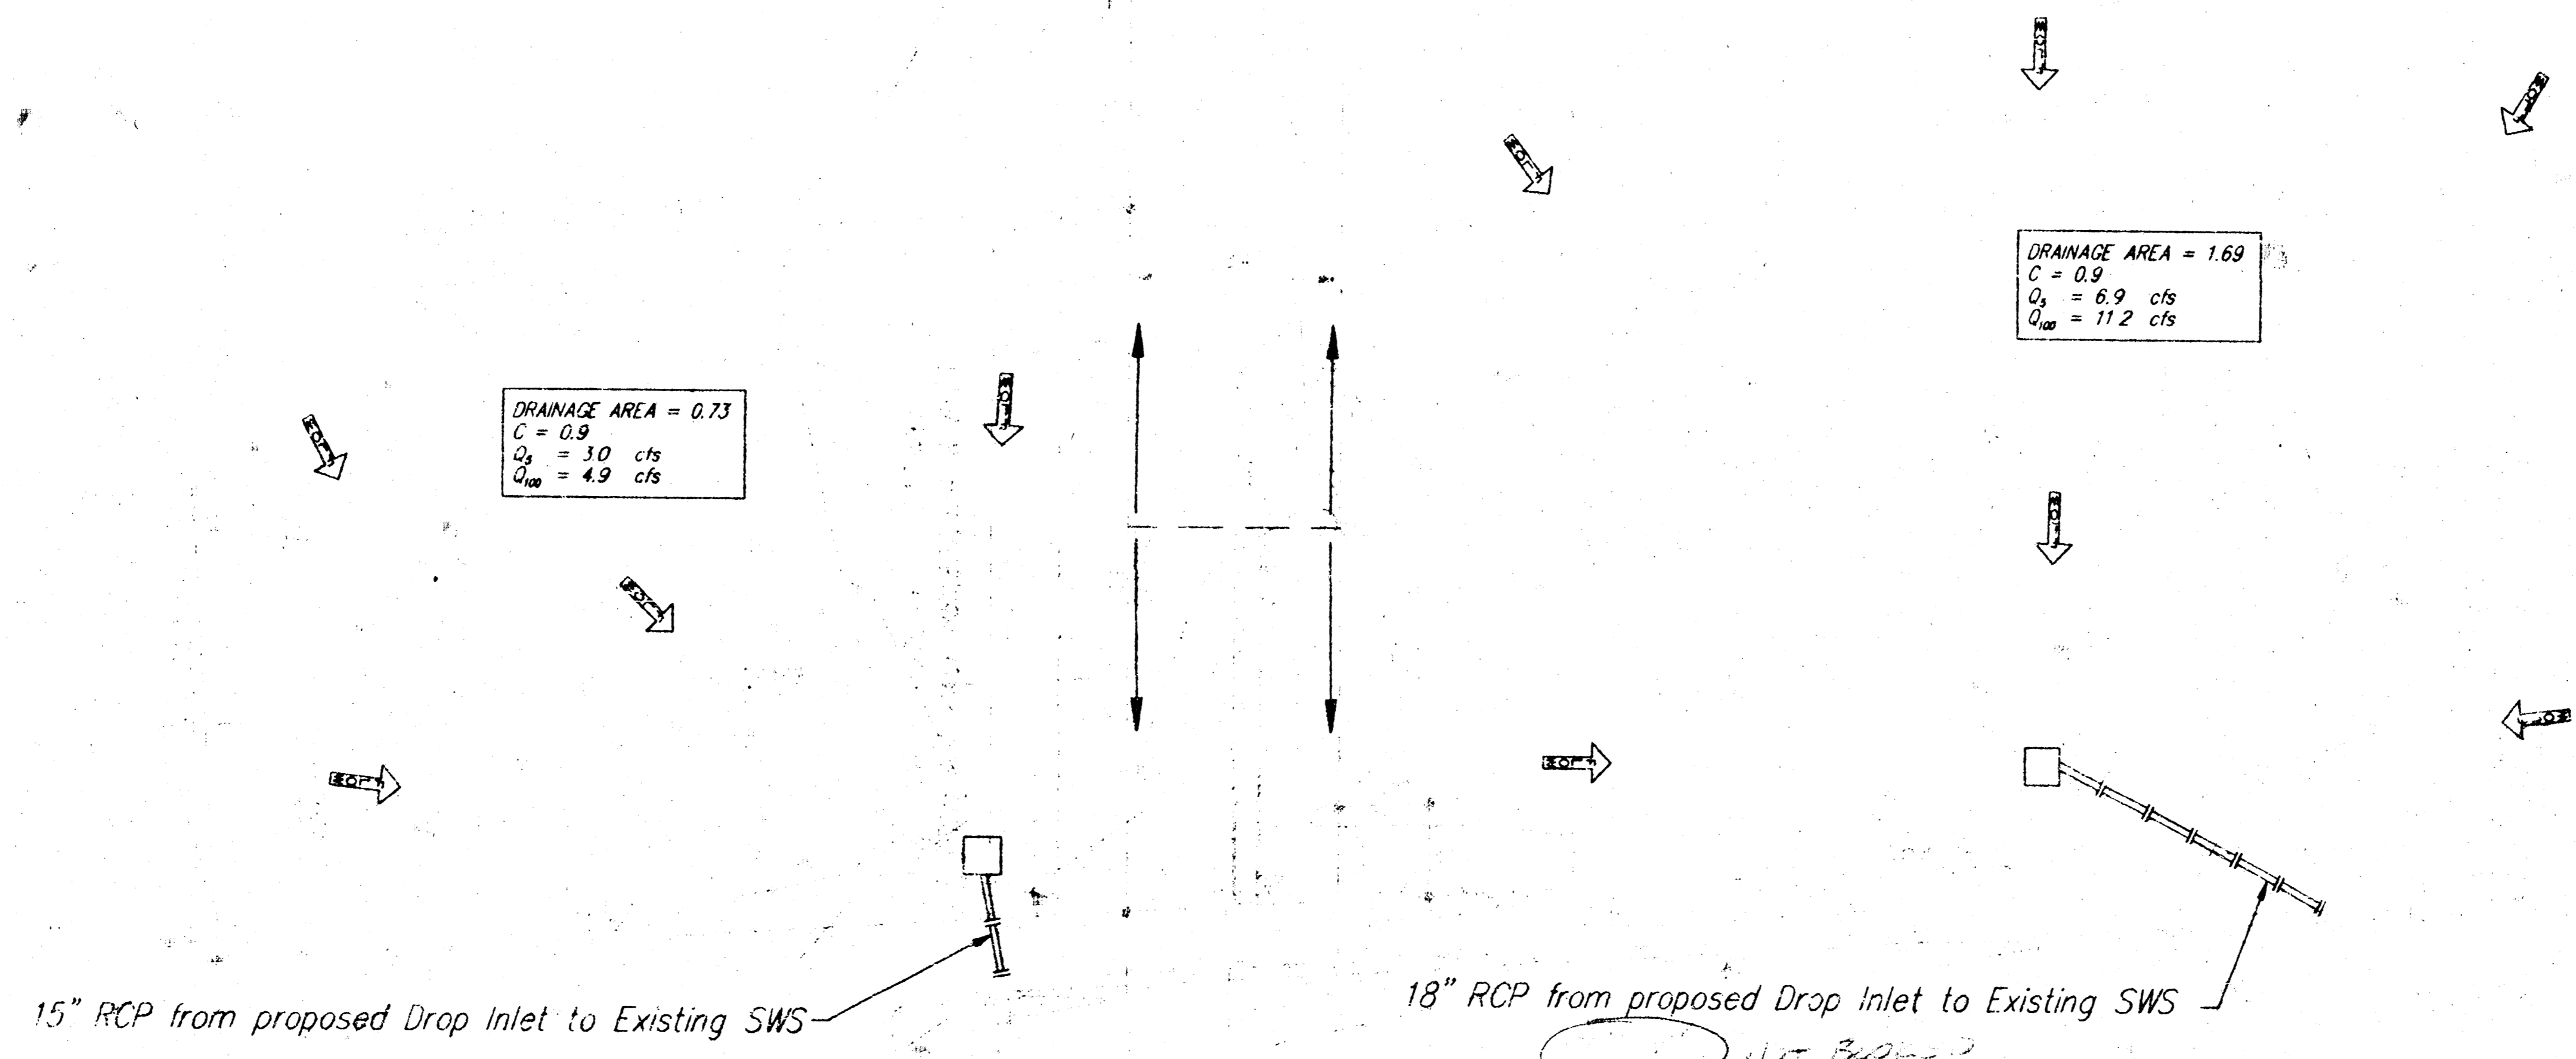

*Not Building  
on this area*

MINIMUM BUILDING PAD ELEVATIONS  
FOR LOWEST OPENING OF STRUCTURE

Lot & Block	Elevation	
	City Datum	M.S.L.
1 - BLK A	141.6	1329.0
2 - BLK A	141.6	1329.0

BENCH MARK: City disc located on the N.E. Corner of Central and Maize in island.  
Elev. - 146.00 (city datum)

- Scale: 1" = 30'
- = 1/2" REBAR W/ "BAUGHMAN" CAP (SET)
  - ⊗ = CROSS CUT (FOUND)
  - = 1/2" IRON (FOUND)

**TIMBER GROVE LAKES COMMERCIAL ADDITION**  
**DRAINAGE PLAN**

**BAUGHMAN+ COMPANY P.A.**  
ENGINEERING & SURVEYING  
316, 262 - 1271 • 315 ELLIS • WICHITA, KANSAS 67201

PROJECT NUMBER: \_\_\_\_\_ SHEET: **1** OF **1**

DESIGN: JES	DRAWN: JES	DATE: May 7, 1994	SCALE: 1" = 30'
-------------	------------	-------------------	-----------------