
DRAINAGE PLAN

TIMBER GROVE LAKES COMMERCIAL ADDITION

WICHITA, KANSAS

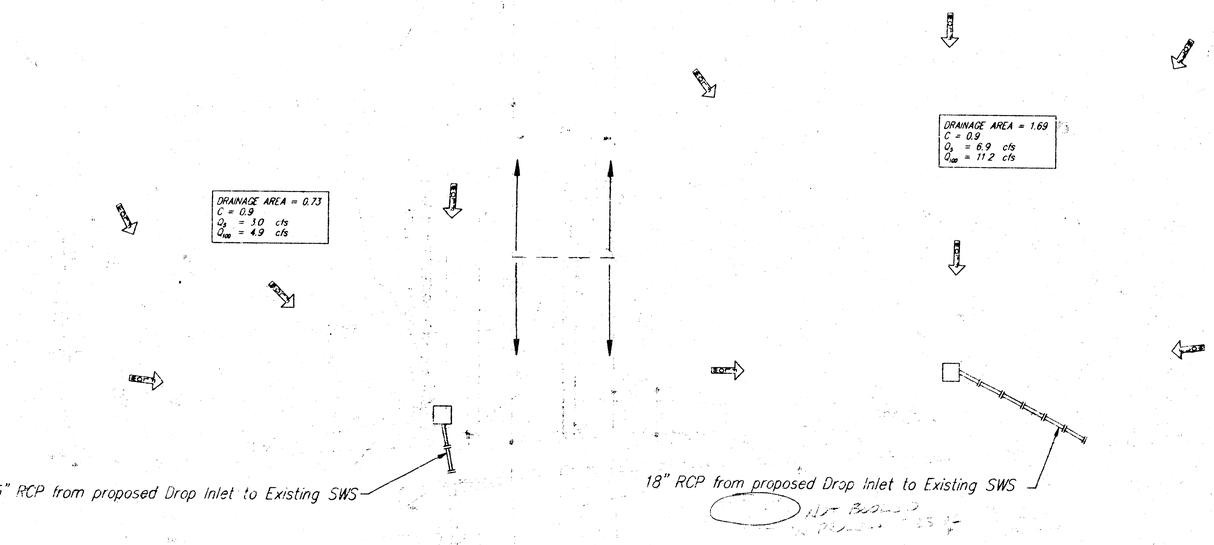

MINIMUM BUILDING PAD ELEVATIONS FOR LOWEST OPENING OF STRUCTURE

Lot & Block	Elevation	
	City Datum	M.S.L.
1 - BLK A	141.6	1329.0
2 - BLK A	141.6	1329.0

BENCH MARK: City disc located on the N.E. Corner of Central and Maize in island. Elev. – 146.00 (city datum)

Scale. 1" = 30'

- = 1/2" REBAR W/ "BAUGHMAN" CAP (SET)
- ⊗ = CROSS CUT (FOUND)
- ○ = 1/2" IRON (FOUND)

TIMBER GROVE LAKES COMMERCIAL ADDITION
DRAINAGE PLAN

BAUGHMAN+ COMPANY P A.
ENGINEERING & SURVEYING
316/262-7271 • 315 ELLIS • WICHITA, KANSAS 67211

PROJECT NUMBER

DESIGN	DRAWN	CHECKED	DATE	SCALE	SHEET	OF
JDS	JDS		May 7, 1994	1" = 30'	1	1