
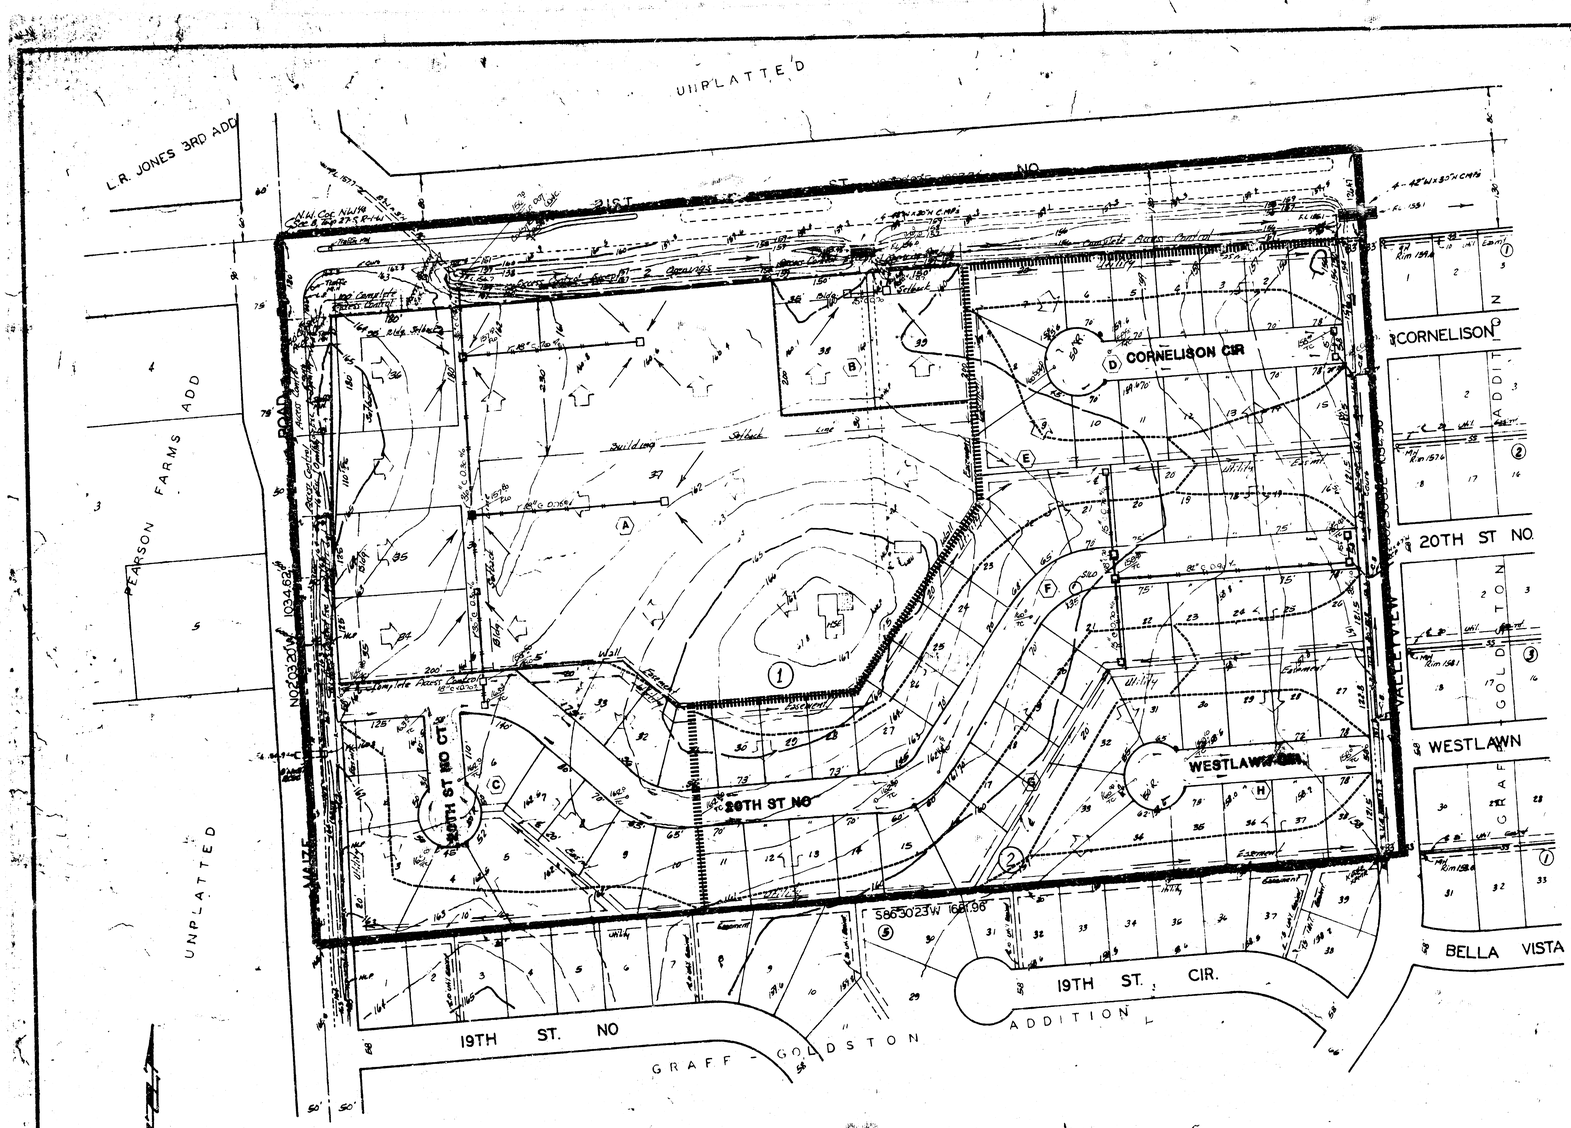



| AREA | SIZE Ac. | C | Q2 cfs | Q5 cfs | Q100 cfs |
|---|---|---|---|---|---|
| A | 11.3 | 0.9 | - | 46.4 | 75.0 |
| B | 1.4 | 0.9 | - | 5.7 | 9.3 |
| C | 4.2 | 0.5 | 8.0 | - | 15.3 |
| D | 3.0 | 0.5 | 5.7 | - | 11.0 |
| E | 1.5 | 0.5 | 3.0 | - | 5.5 |
| F | 6.3 | 0.5 | 12.0 | - | 23.2 |
| G | 1.5 | 0.5 | 3.0 | - | 5.5 |
| H | 2.5 | 0.5 | 4.9 | - | 9.2 |

1" = 100'
ELEV = CITY DATUM

BENCH MARK:
City Standard Disc. 64' E & 99' S
Sec. Cor @ Maize Rd & 21st St No
Elevation = 164.30 City Datum

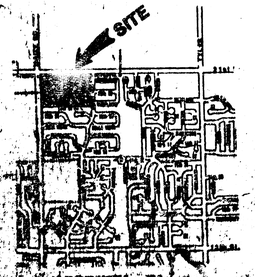


VICINITY PL

PRELIMINARY PLAT

~~GREYSTONE ESTATES~~
TimberRidge 2nd Add'n

MAT ECK

DRAINAGE PLAN 12/6/90

BAUGHMAN COMPANY, P.A.
SURVEYING & ENGINEERING
316/262-7271 • 315 ELLIS • WICHITA, KANSAS 67211

7-26-91
5-22-91
27 MAR 90

21ST ST NO

MAIZE ROAD

VALLEYVIEW

20TH ST NO

20TH ST NO CT

WESTLAWN CIR

1" = 60'

NOTE:

Proposed Garage floor elevations are shown on the plans. Variations from garage floor elevations must be approved by Baughman Company, P.A. Contractor to set finish floor elevation.

All street elevations shown on plans are for top of curb (full height).

Contour elevations shown are for graphic representation of drainage concept. Spot elevations shall take precedence over contour lines.

BENCHMARK:

City of Wichita Bench Mark Disc, 64' east and 99' south of the Centerline of Maize Road and 119th Street North.
Elev. = 164.30 City Datum

# SUBDIVISION GRADING PLAN
# TIMBER RIDGE 2ND ADD.


BAUGHMAN COMPANY P. A.
ENGINEERING & SURVEYING
316/262-7271 • 315 ELLIS • WICHITA, KANSAS 67211


| PROJECT NUMBER | | | | SHEET 1 OF 1 |
|---|---|---|---|---|
| DESIGN P.J.M. | DRAWN P.J.M. | NSW. | DATE OCT 8, 92 | SCALE 1"=60' |

92-09-E446

TR21GRADING