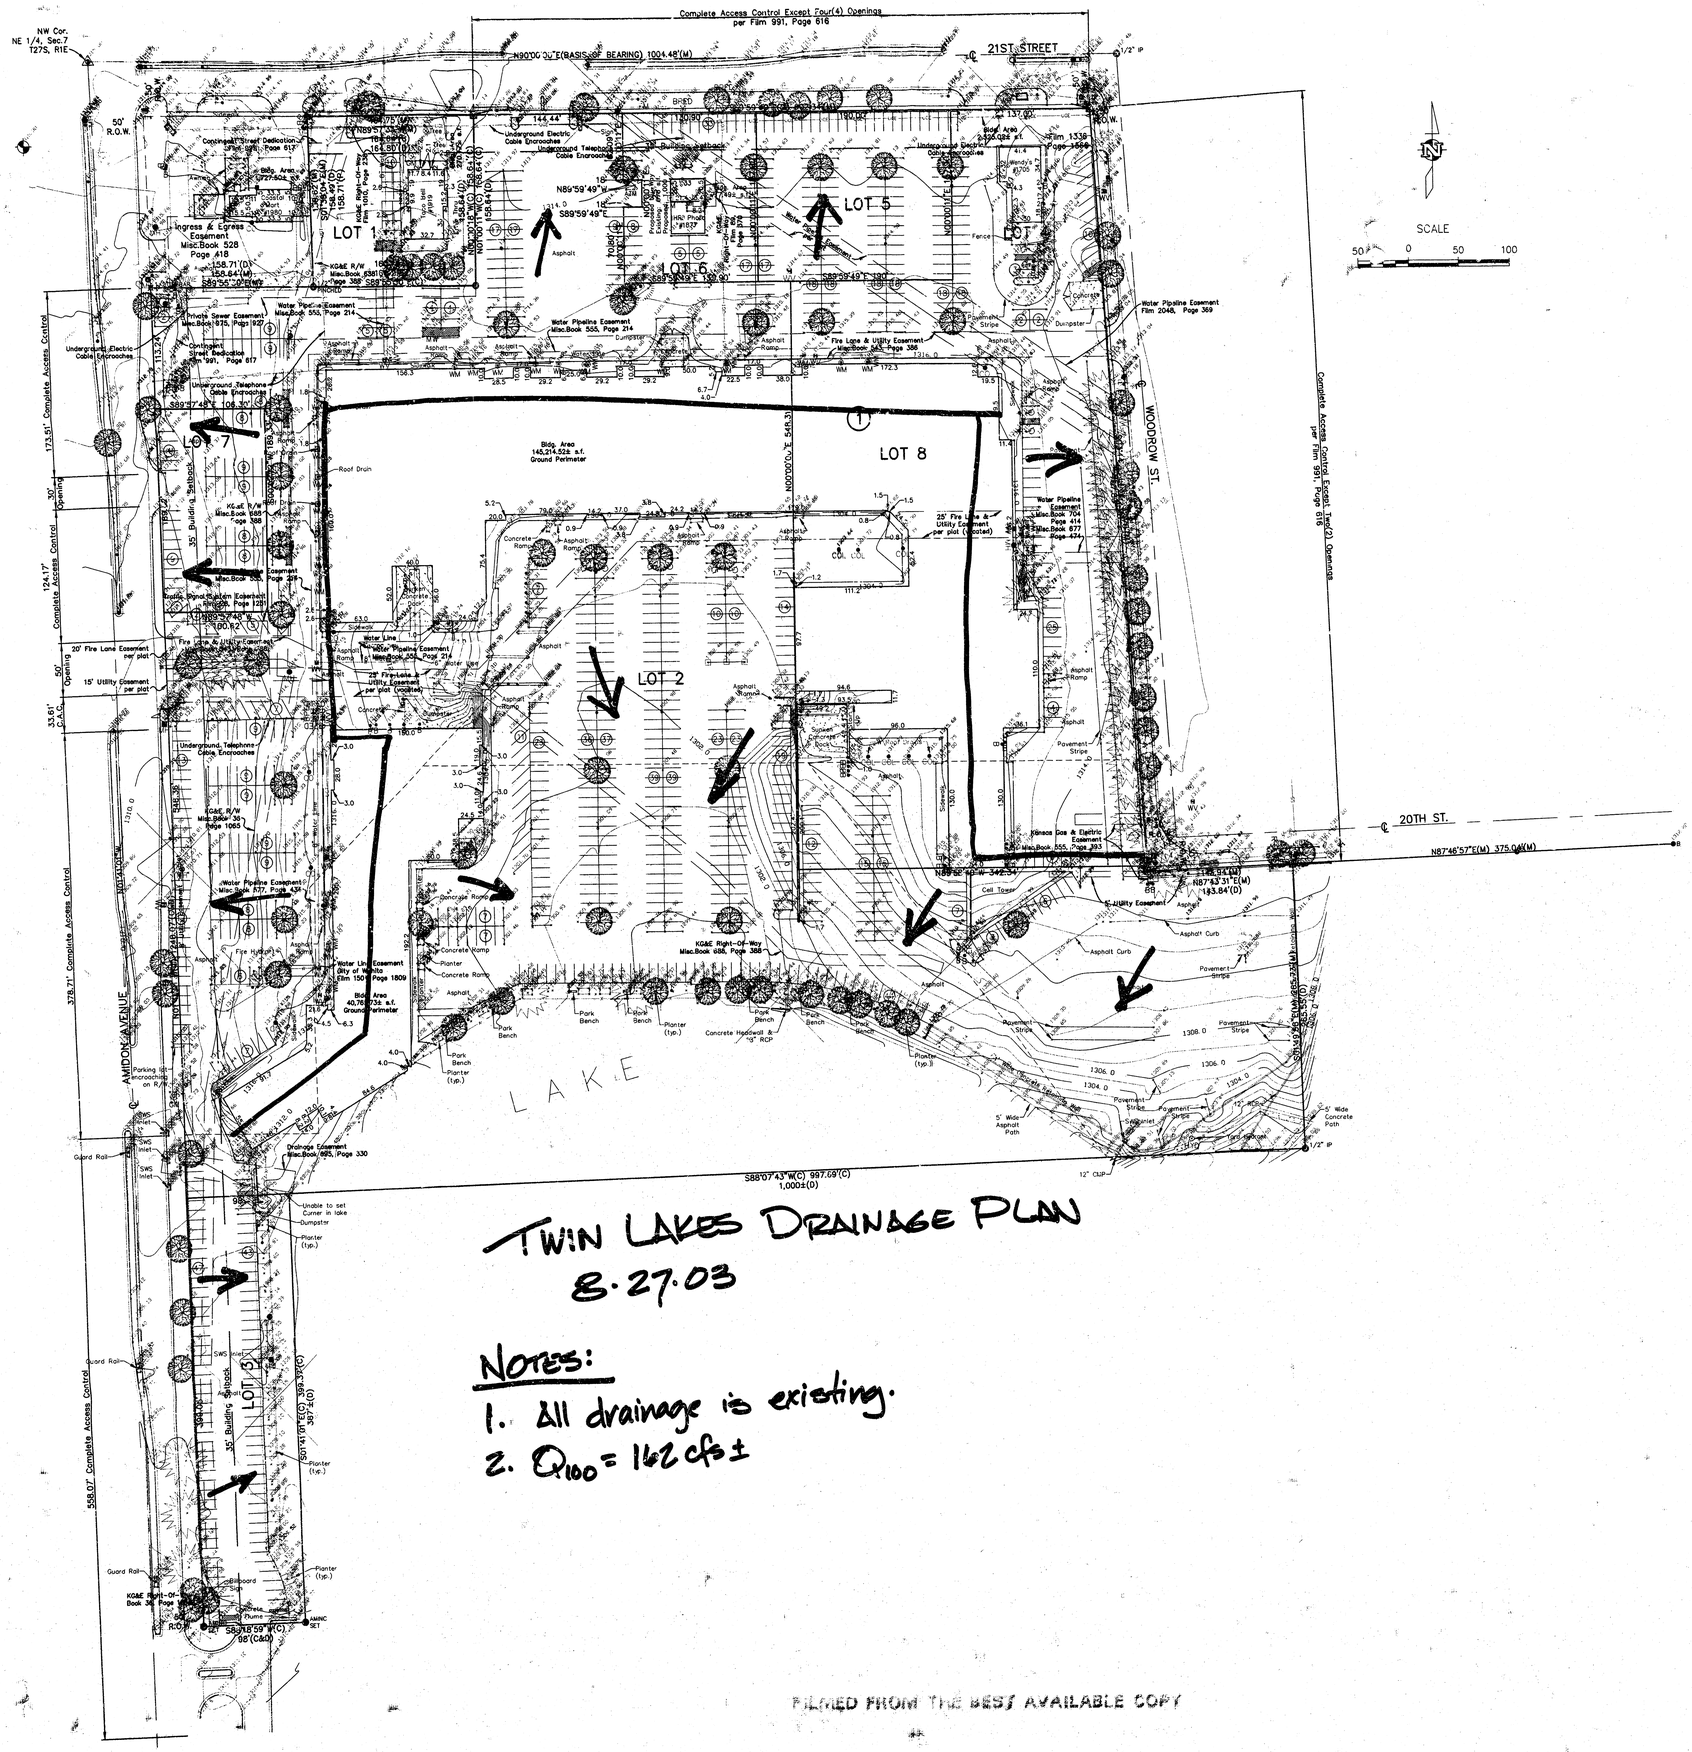


TWIN LAKES DRAINAGE PLAN

8.27.03

NOTES:

1. All drainage is existing.
2. Q_{100} = 162 cfs ±

FILMED FROM THE BEST AVAILABLE COPY