


DRAINAGE PLAN
U.N.B. 2ND ADDITION
WICHITA, SEDGWICK COUNTY, KANSAS

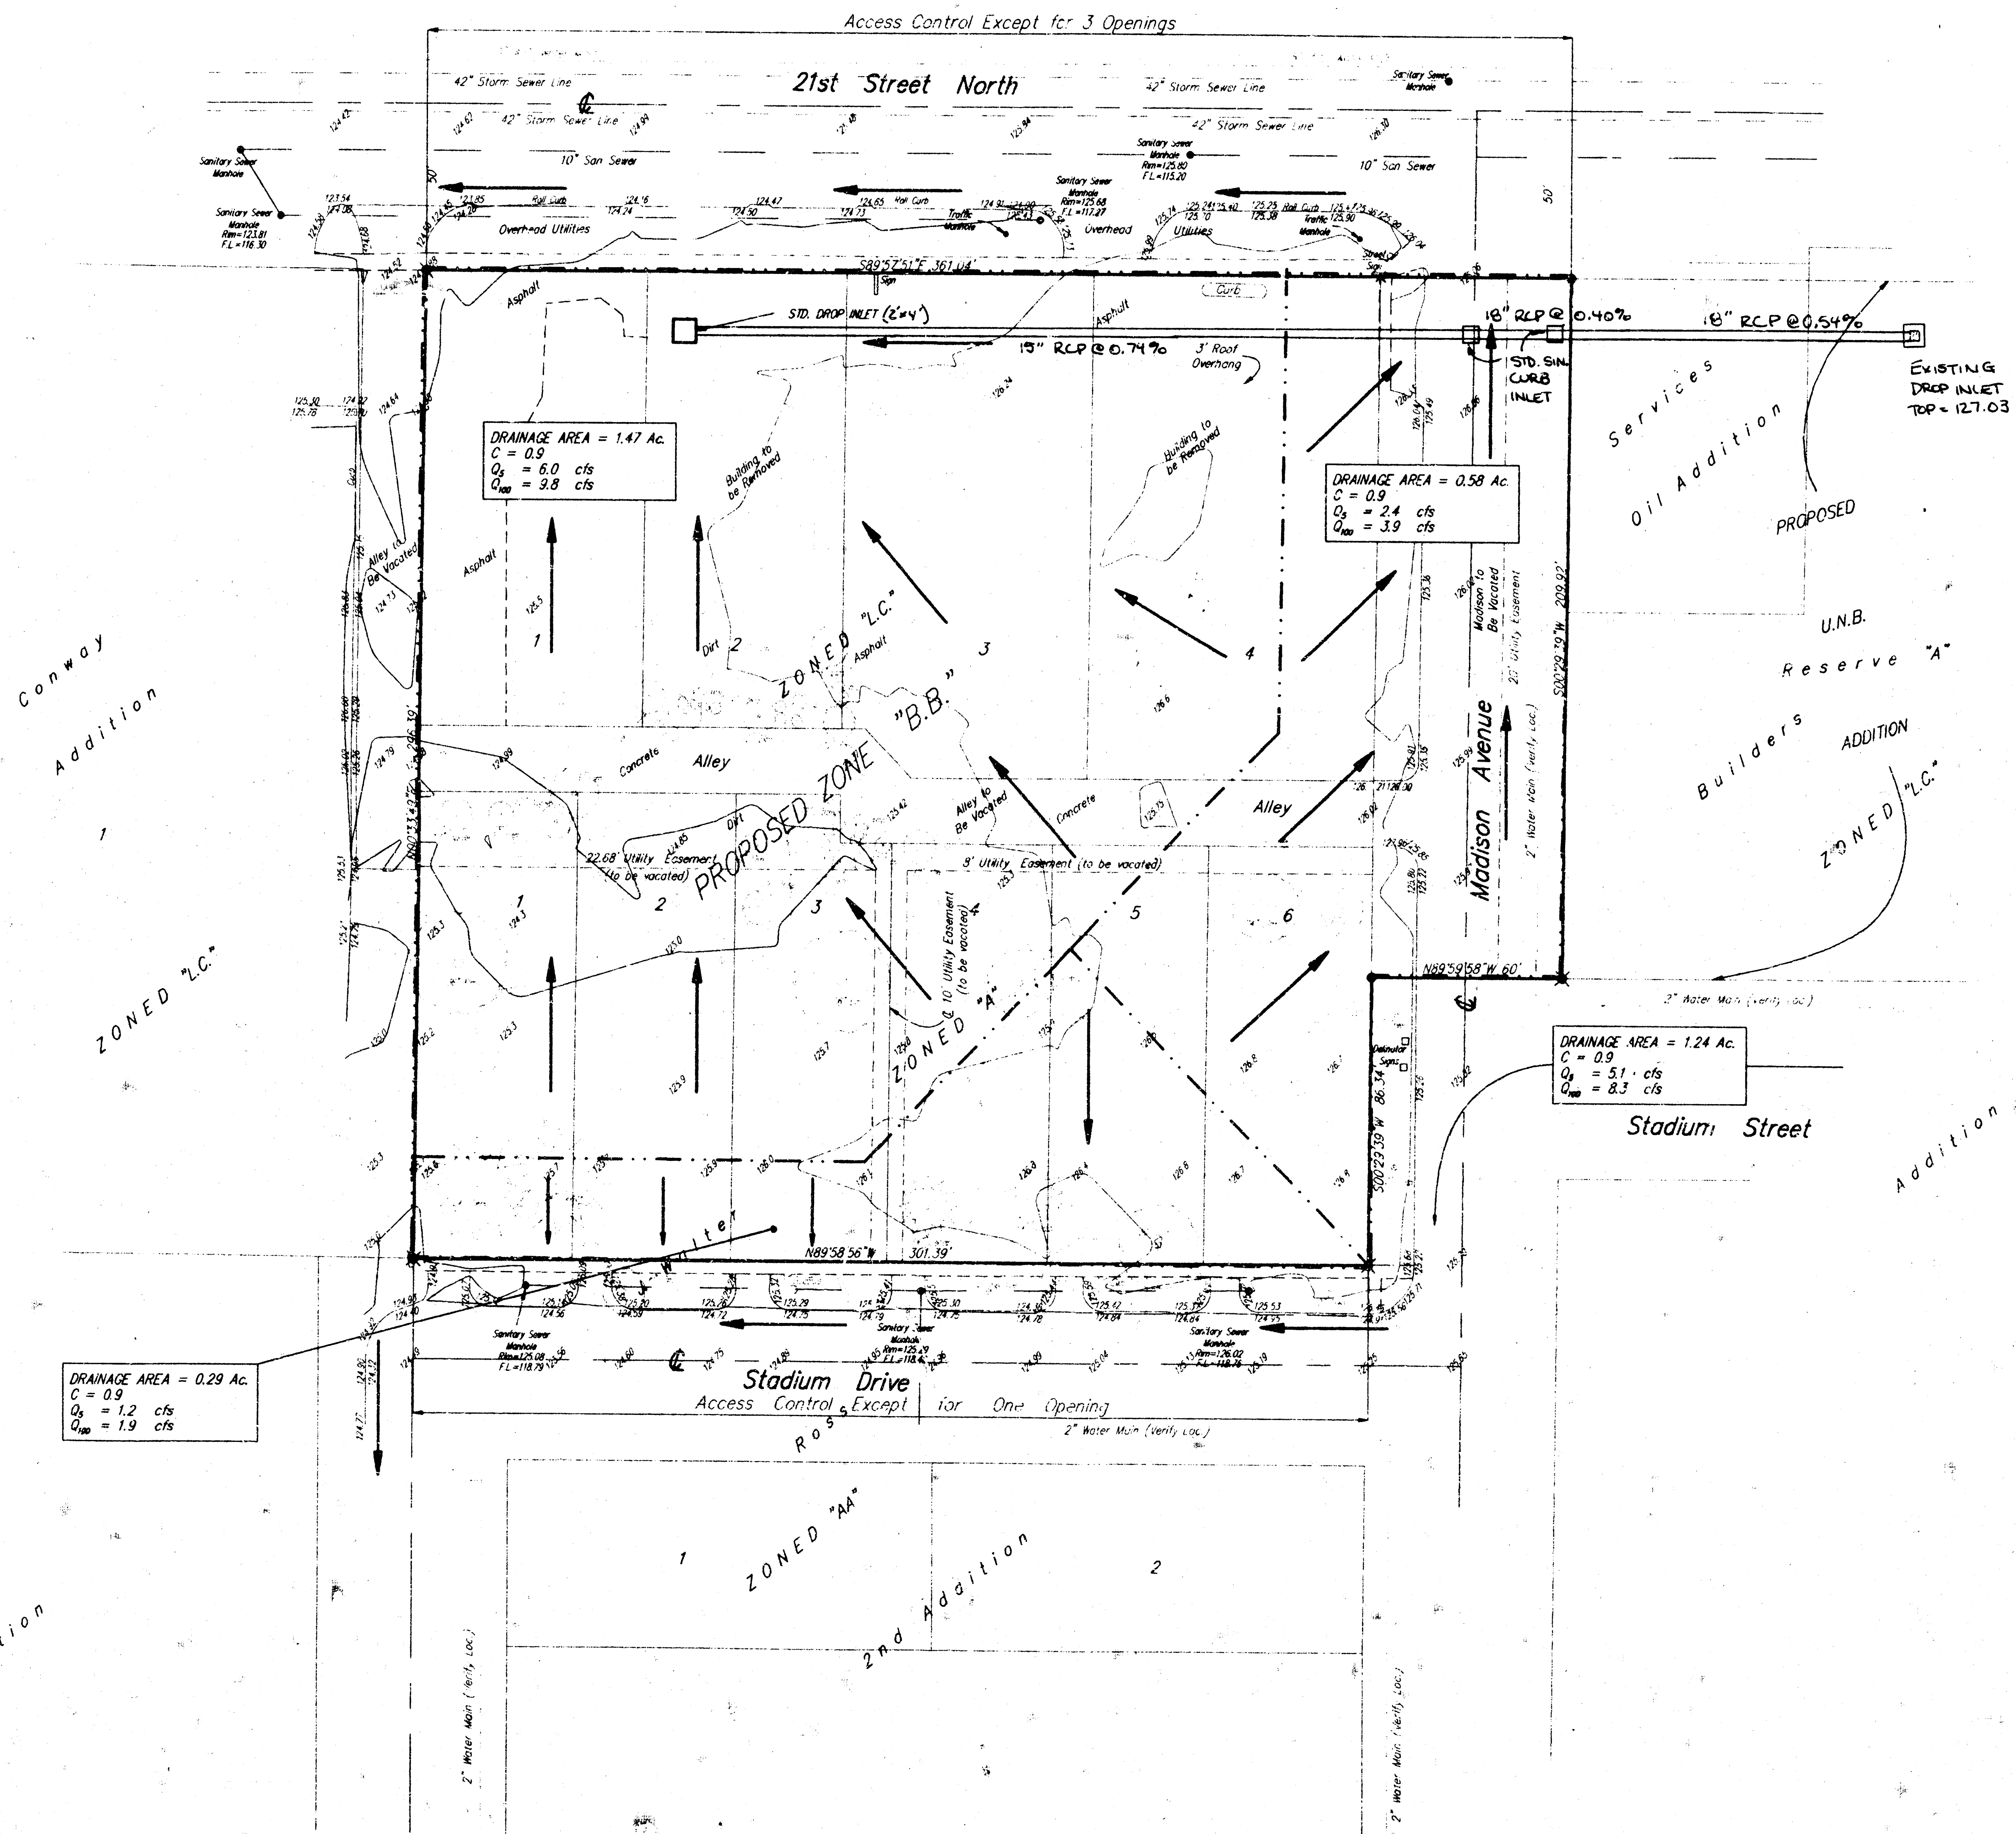

LEGEND


- = Baughman Rebar Set
- ✱ = 1/2" Iron Found
- ✱ = Iron Found

LEGAL DESCRIPTION

LEGAL DESCRIPTION

OWNER
City of Wichita
455 N. Main
Wichita, KS 67202

BENCHMARK
C.O.W. Brass Disc 41.08' South and 117.26' West of the
centerlines of 21st Street North and Grove Street
Elevation = 132.20' (City Datum)

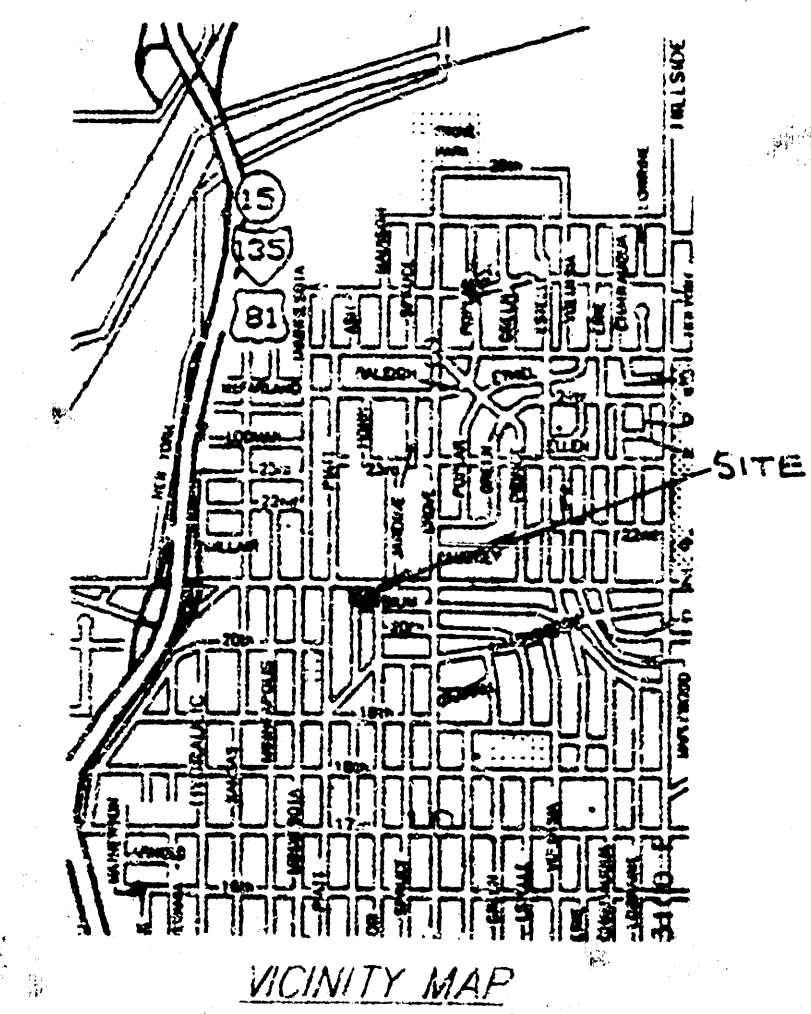

BAUGHMAN COMPANY P. A.
ENGINEERING, SURVEYING, & PLANNING
(316)-262-7271 • 315 E. 8th St. • Wichita, Kansas 67211

ENGINEERING, SURVEYING, & PLANNING
