


VENTURE PARK ADDITION
(Drainage)

SKETCH PLAT
VENTURE PARK ADDITION

PM, SEDGWICK COUNTY, KANSAS

FRANK L. CARNEY

drainage plan

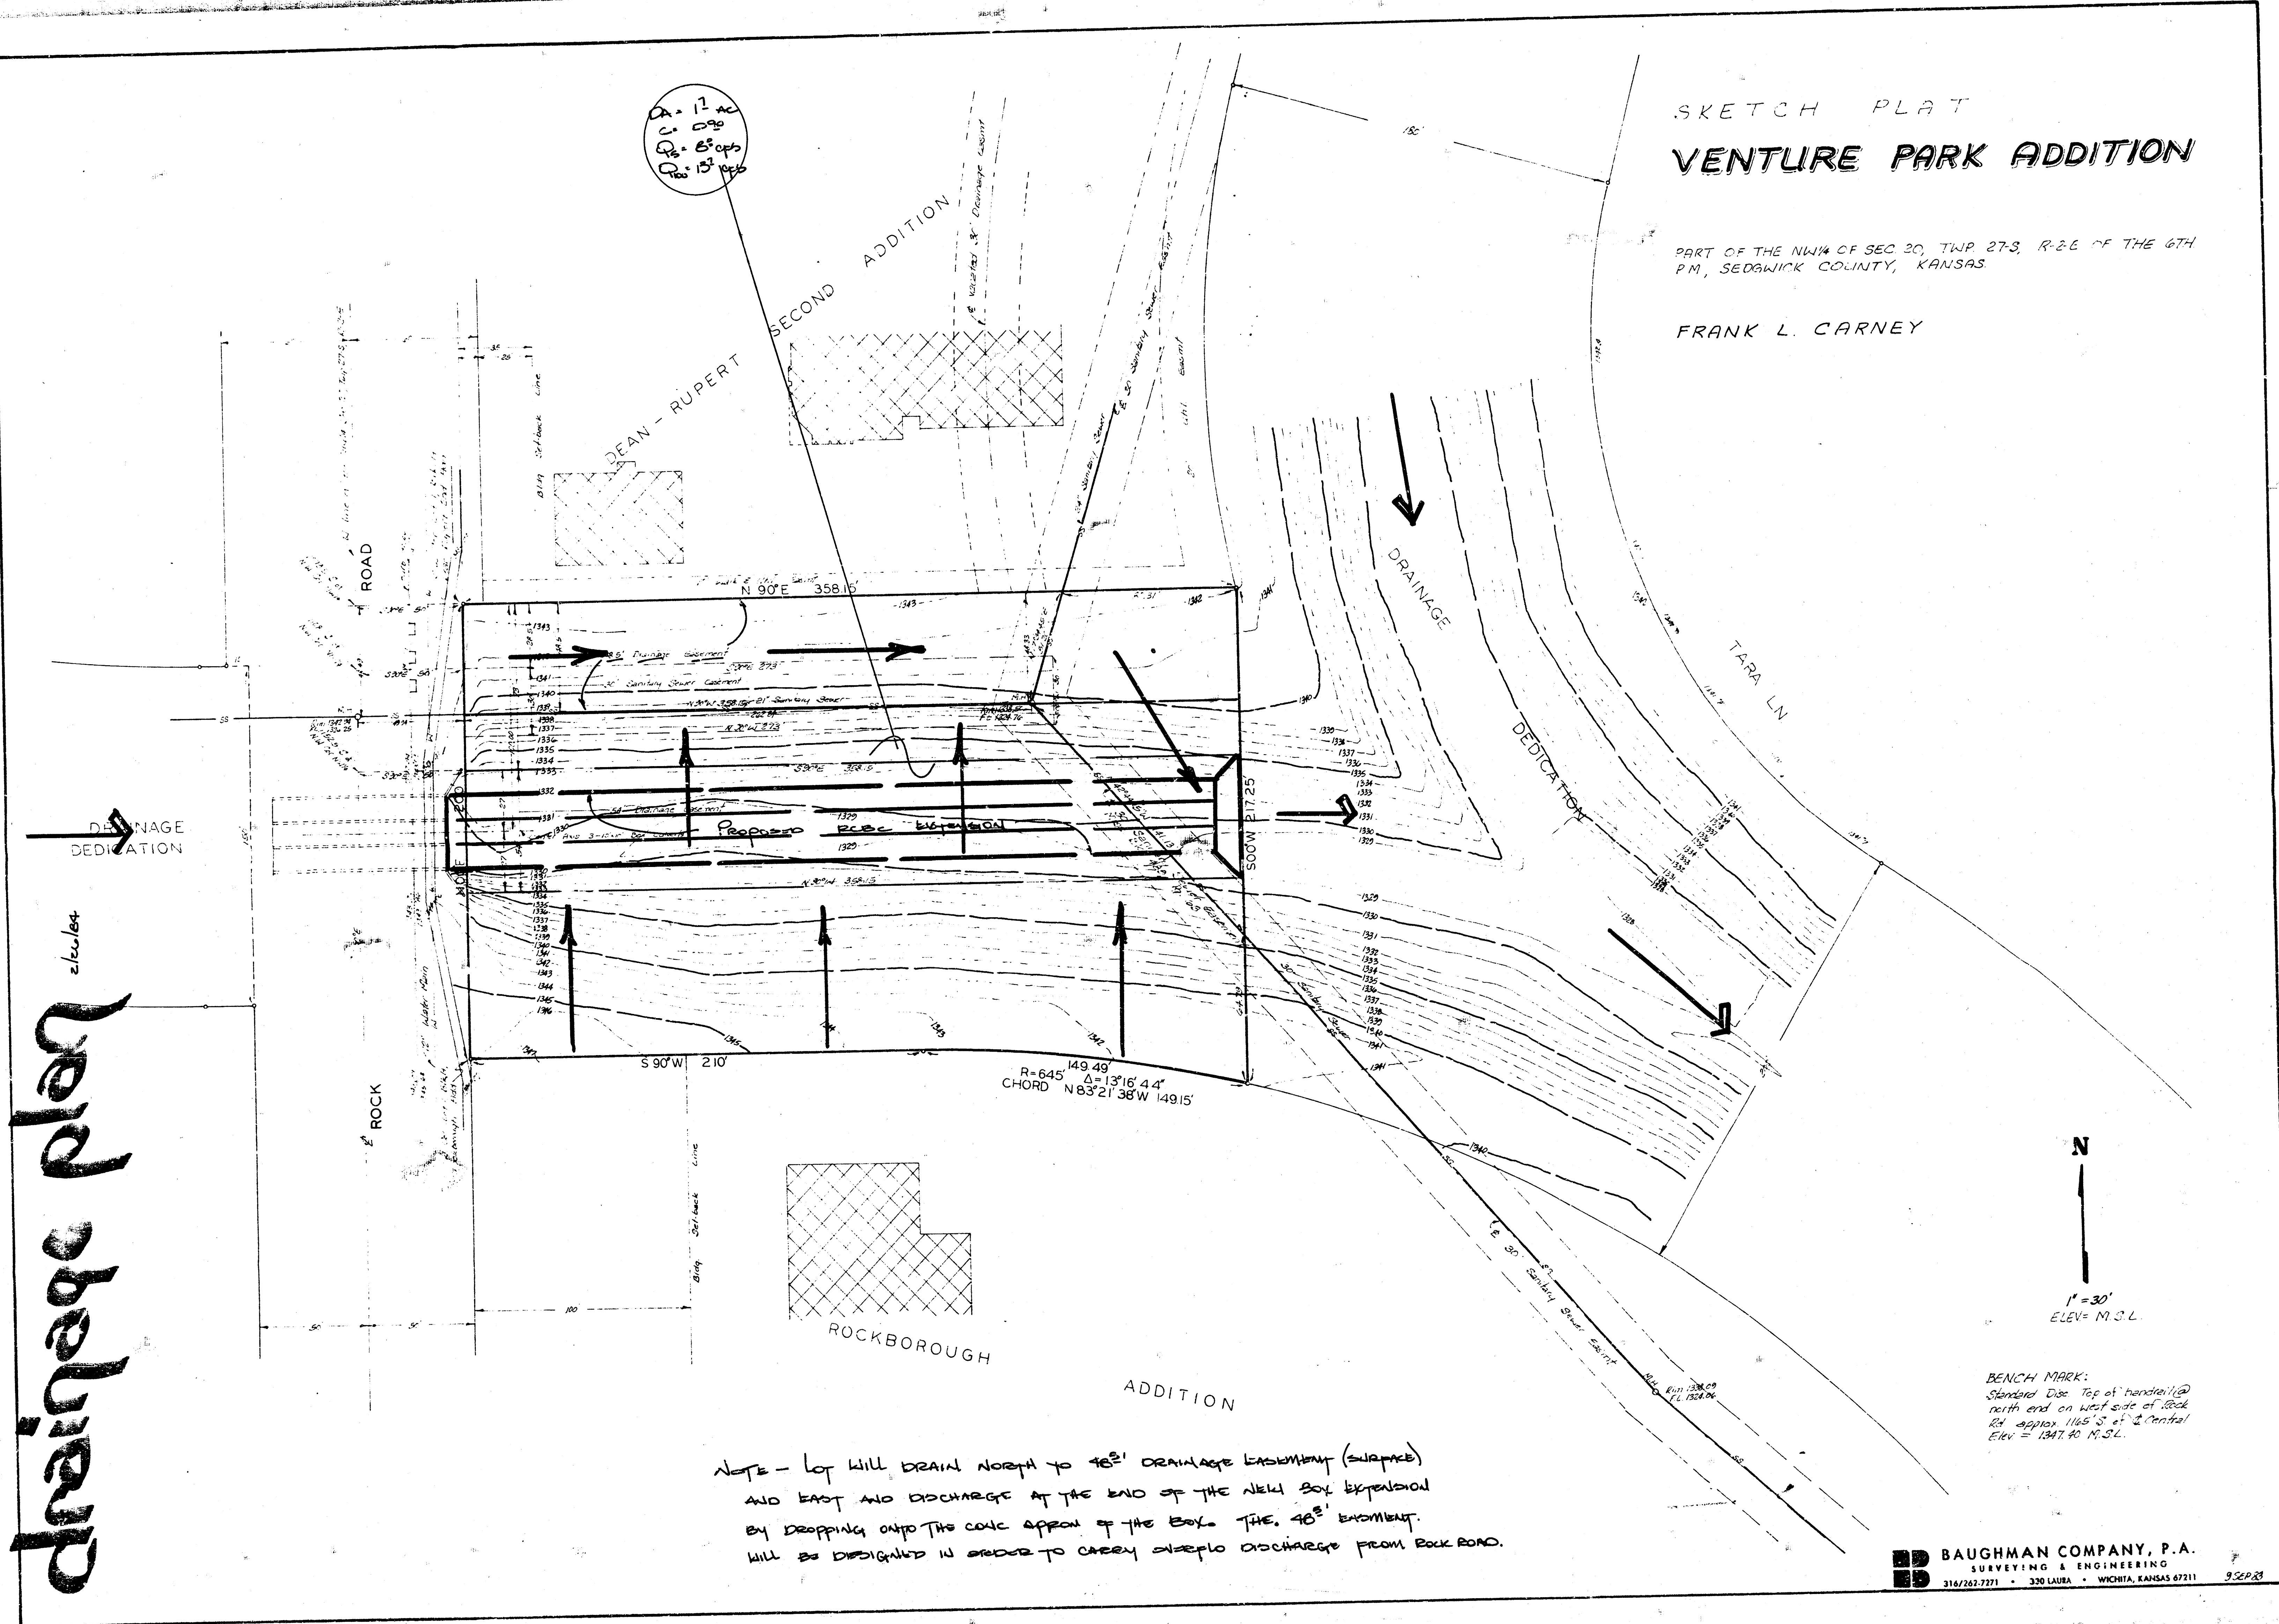

2. = 12 ac
C = 0.90
Q₂ = 65 cfs
Q₂₀ = 13 cfs

DEAN - RUPERT
SECOND ADDITION

ROCKBOROUGH
ADDITION

and east and discharge at the end of the new box expansion
by dropping onto the conc. apron of the box. The 40' easement
will be designed in order to carry overflow discharge from Rock Road.

BENCH MARK:
Standard Disc Top of benchmark @
north end on west side of Rock
Rd. approx 1165' S of 2' Central

BAUGHMAN COMPANY, P.A.
SURVEYING & ENGINEERING
316/262-7271 • 330 LAURA • WICHITA, KANSAS 67211 9 SEP 23