PRELIMINARY PLAT
VYNE ADDITION
WICHITA, SEDGWICK COUNTY, KANSAS

DRAINAGE PLAN

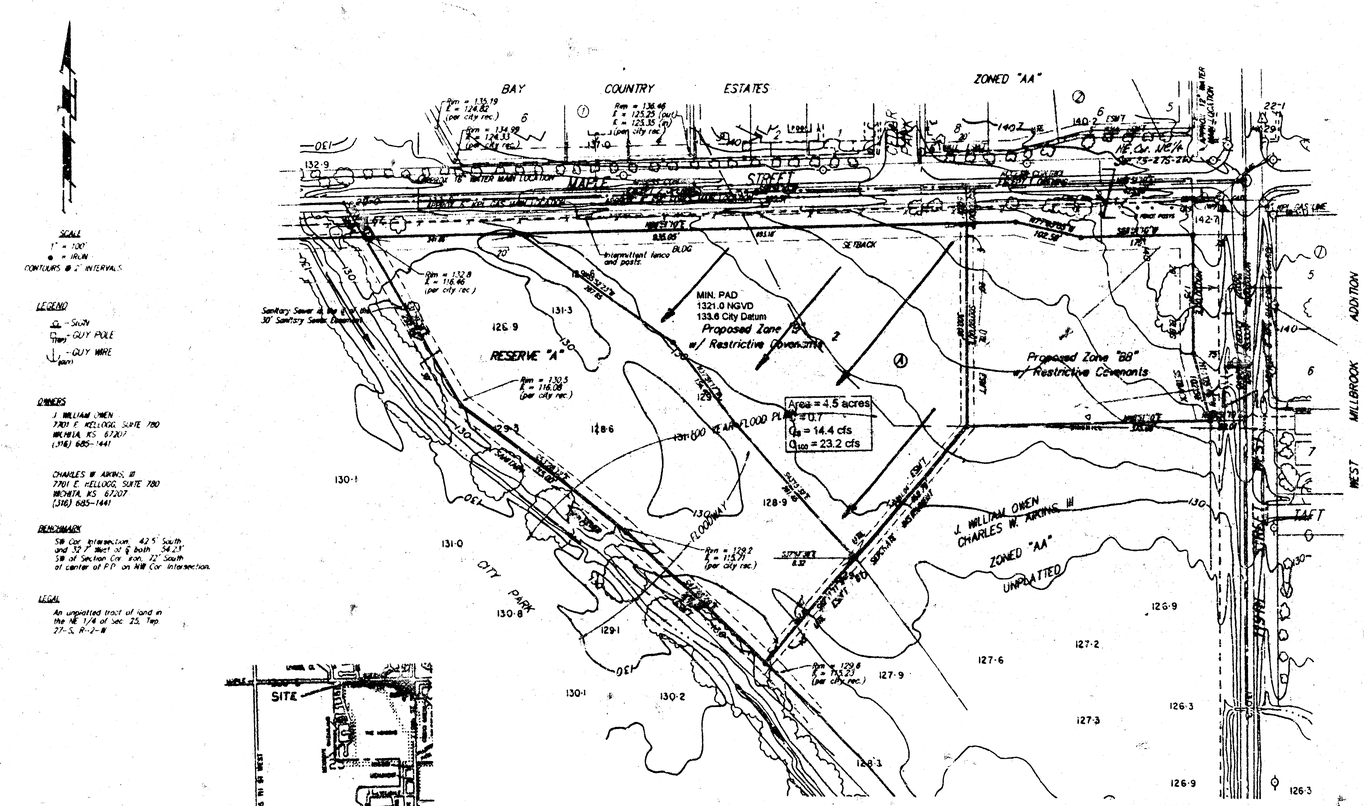

VICINITY MAP

21 AUG 1994
30 AUG 1994
29 AUGUST 1994

BAUGHMAN COMPANY P.A.
ENGINEERING & SURVEYING
316/262-7271 • 315 ELLIS • WICHITA, KANSAS 67211