
DRAINAGE PLAN 4/95

WESLEY WEST ADDITION

TO WICHITA, SEDGWICK COUNTY, KANSAS

OWNER: HCA HEALTH SERVICES OF KANSAS INC.
c/o COLUMBIA/HCA
c/o THOMAS W. HULME
P.O. BOX 550
NASHVILLE, TENNESSEE 37202-0550

ENGINEER: PROFESSIONAL ENGINEERING CONSULTANTS, P.A.
303 S. TOPEKA
WICHITA, KANSAS 67202

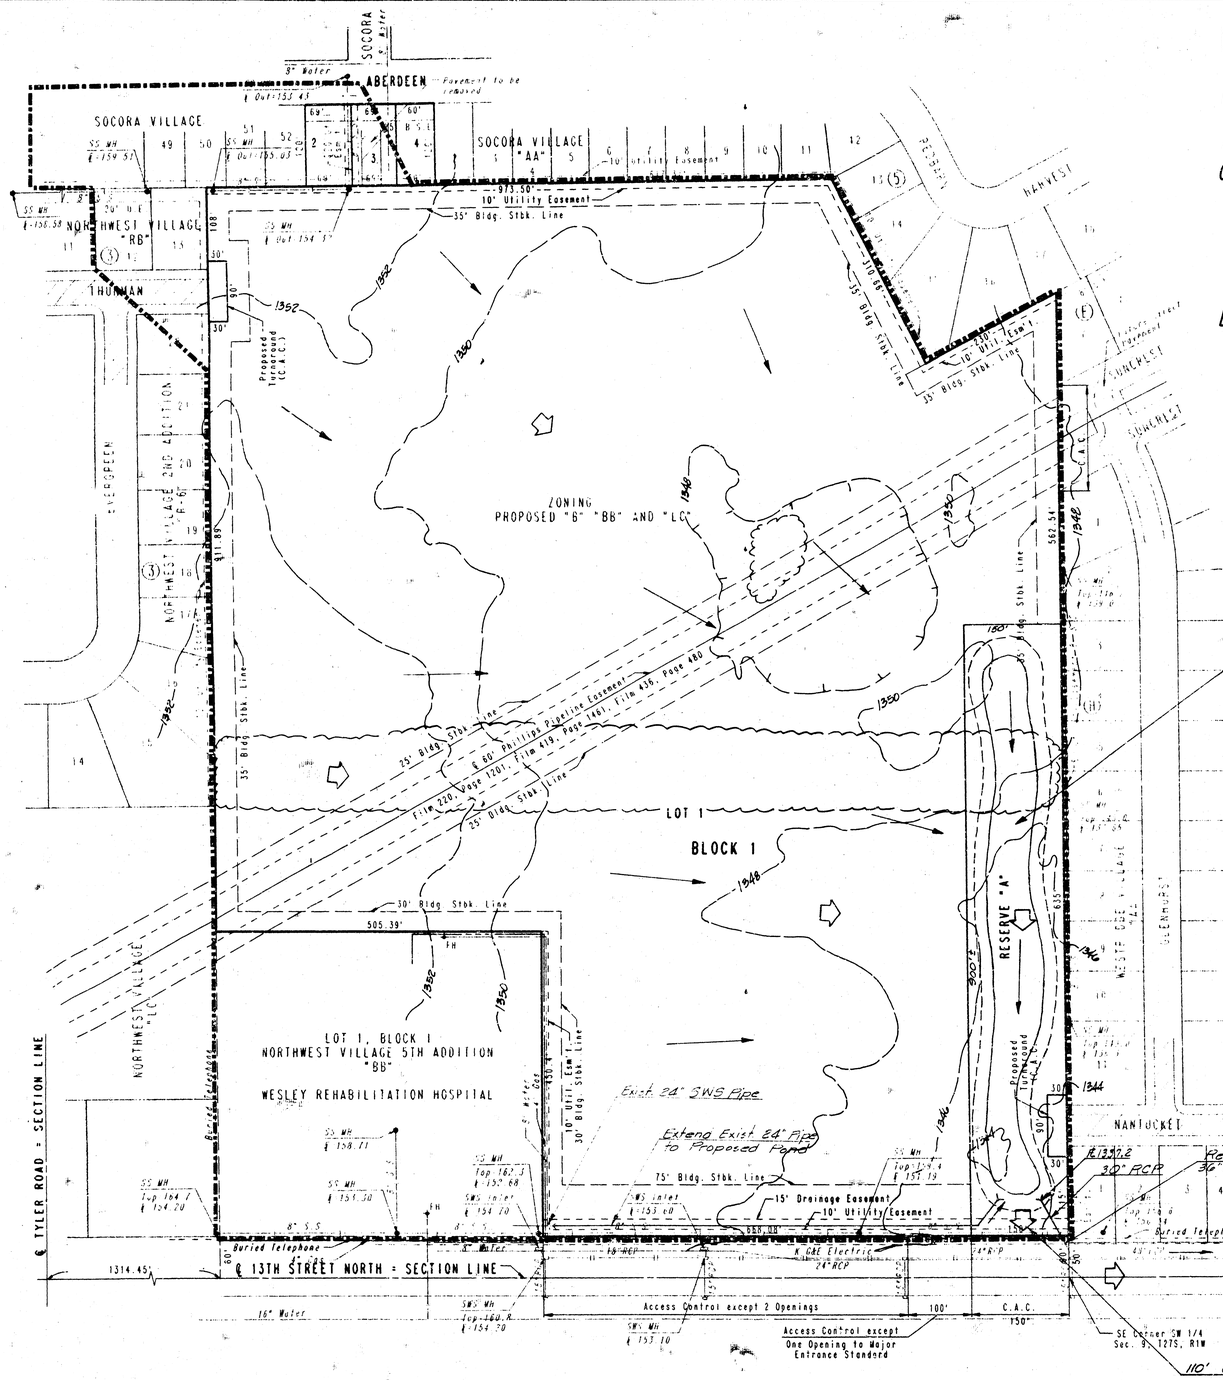

LEGEND

- Direction of Minor Flow
- Direction of Major Flow
- Drainage Basin Boundary

SCALE: 1"=100'
FEBRUARY, 1995

C.A.C. = COMPLETE ACCESS CONTROL

EXISTING STREET PAVEMENT

B.M. - CITY OF WICHITA DISC 48 FEET EAST AND 48 FEET NORTH OF THE INTERSECTION OF THE CENTERLINES OF 13TH STREET NORTH AND TYLER ROAD.
ELEV. 169.929 CITY DATUM

TOPOGRAPHY DATE: NOVEMBER, 1979

NOTE: CONTOUR ELEVATION DATA = M.S.L. ELEVATIONS OF SANITARY SEWER MANHOLES AND STORM SEWER INLETS = CITY DATUM.

RESERVE "A" SHALL BE UTILIZED FOR A STORM WATER RETENTION/DETENTION SYSTEM, UTILITIES CONFINED TO EASEMENTS, LANDSCAPING AND PEDESTRIAN IMPROVEMENTS.

FOR ADDITIONAL BUILDING SETBACKS SEE CUP DP-217 ON FILE WITH THE WICHITA-SEDGWICK COUNTY METROPOLITAN AREA PLANNING DEPARTMENT.

Note: All site drainage to be carried overland or in storm sewer to proposed detention basin in Reserve "A".

251