
WESTLINK VILLAGE 22ND ADDITION
(Drainage)

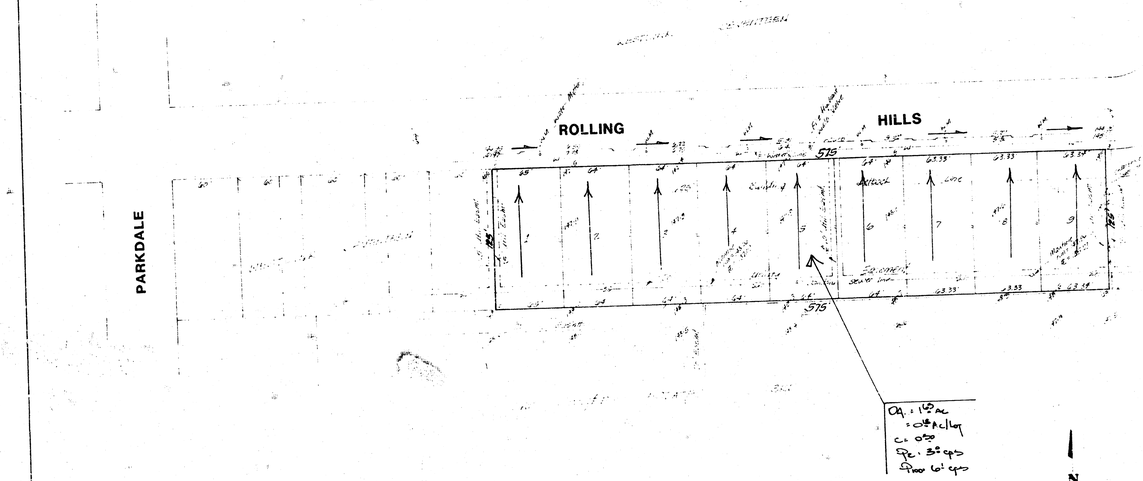

SKETCH PLAT

WESTLINK VILLAGE 22ND ADDITION

BEING A REPLAT OF LOTS 25-26-27-28-29-& 30, BLOCK 5, WESTLINK SEVENTEEN

OWNER: FIDELITY SAVINGS ASSOCIATION

DRAINAGE NOTES

The proposed lots are being replatted from 6 single family lots into 9 single family lots. The lots will drain north to the paved street as indicated on the plan. Rollings Hills Dr. drains east to storm sewers as indicated.

DRAINAGE PLAN

BAUGHMAN COMPANY, P.A.
SURVEYING & ENGINEERING
316 262-7271 • 315 ELLIS • WICHITA, KANSAS 67211