


WILLHITE ADDITION
(Draft)

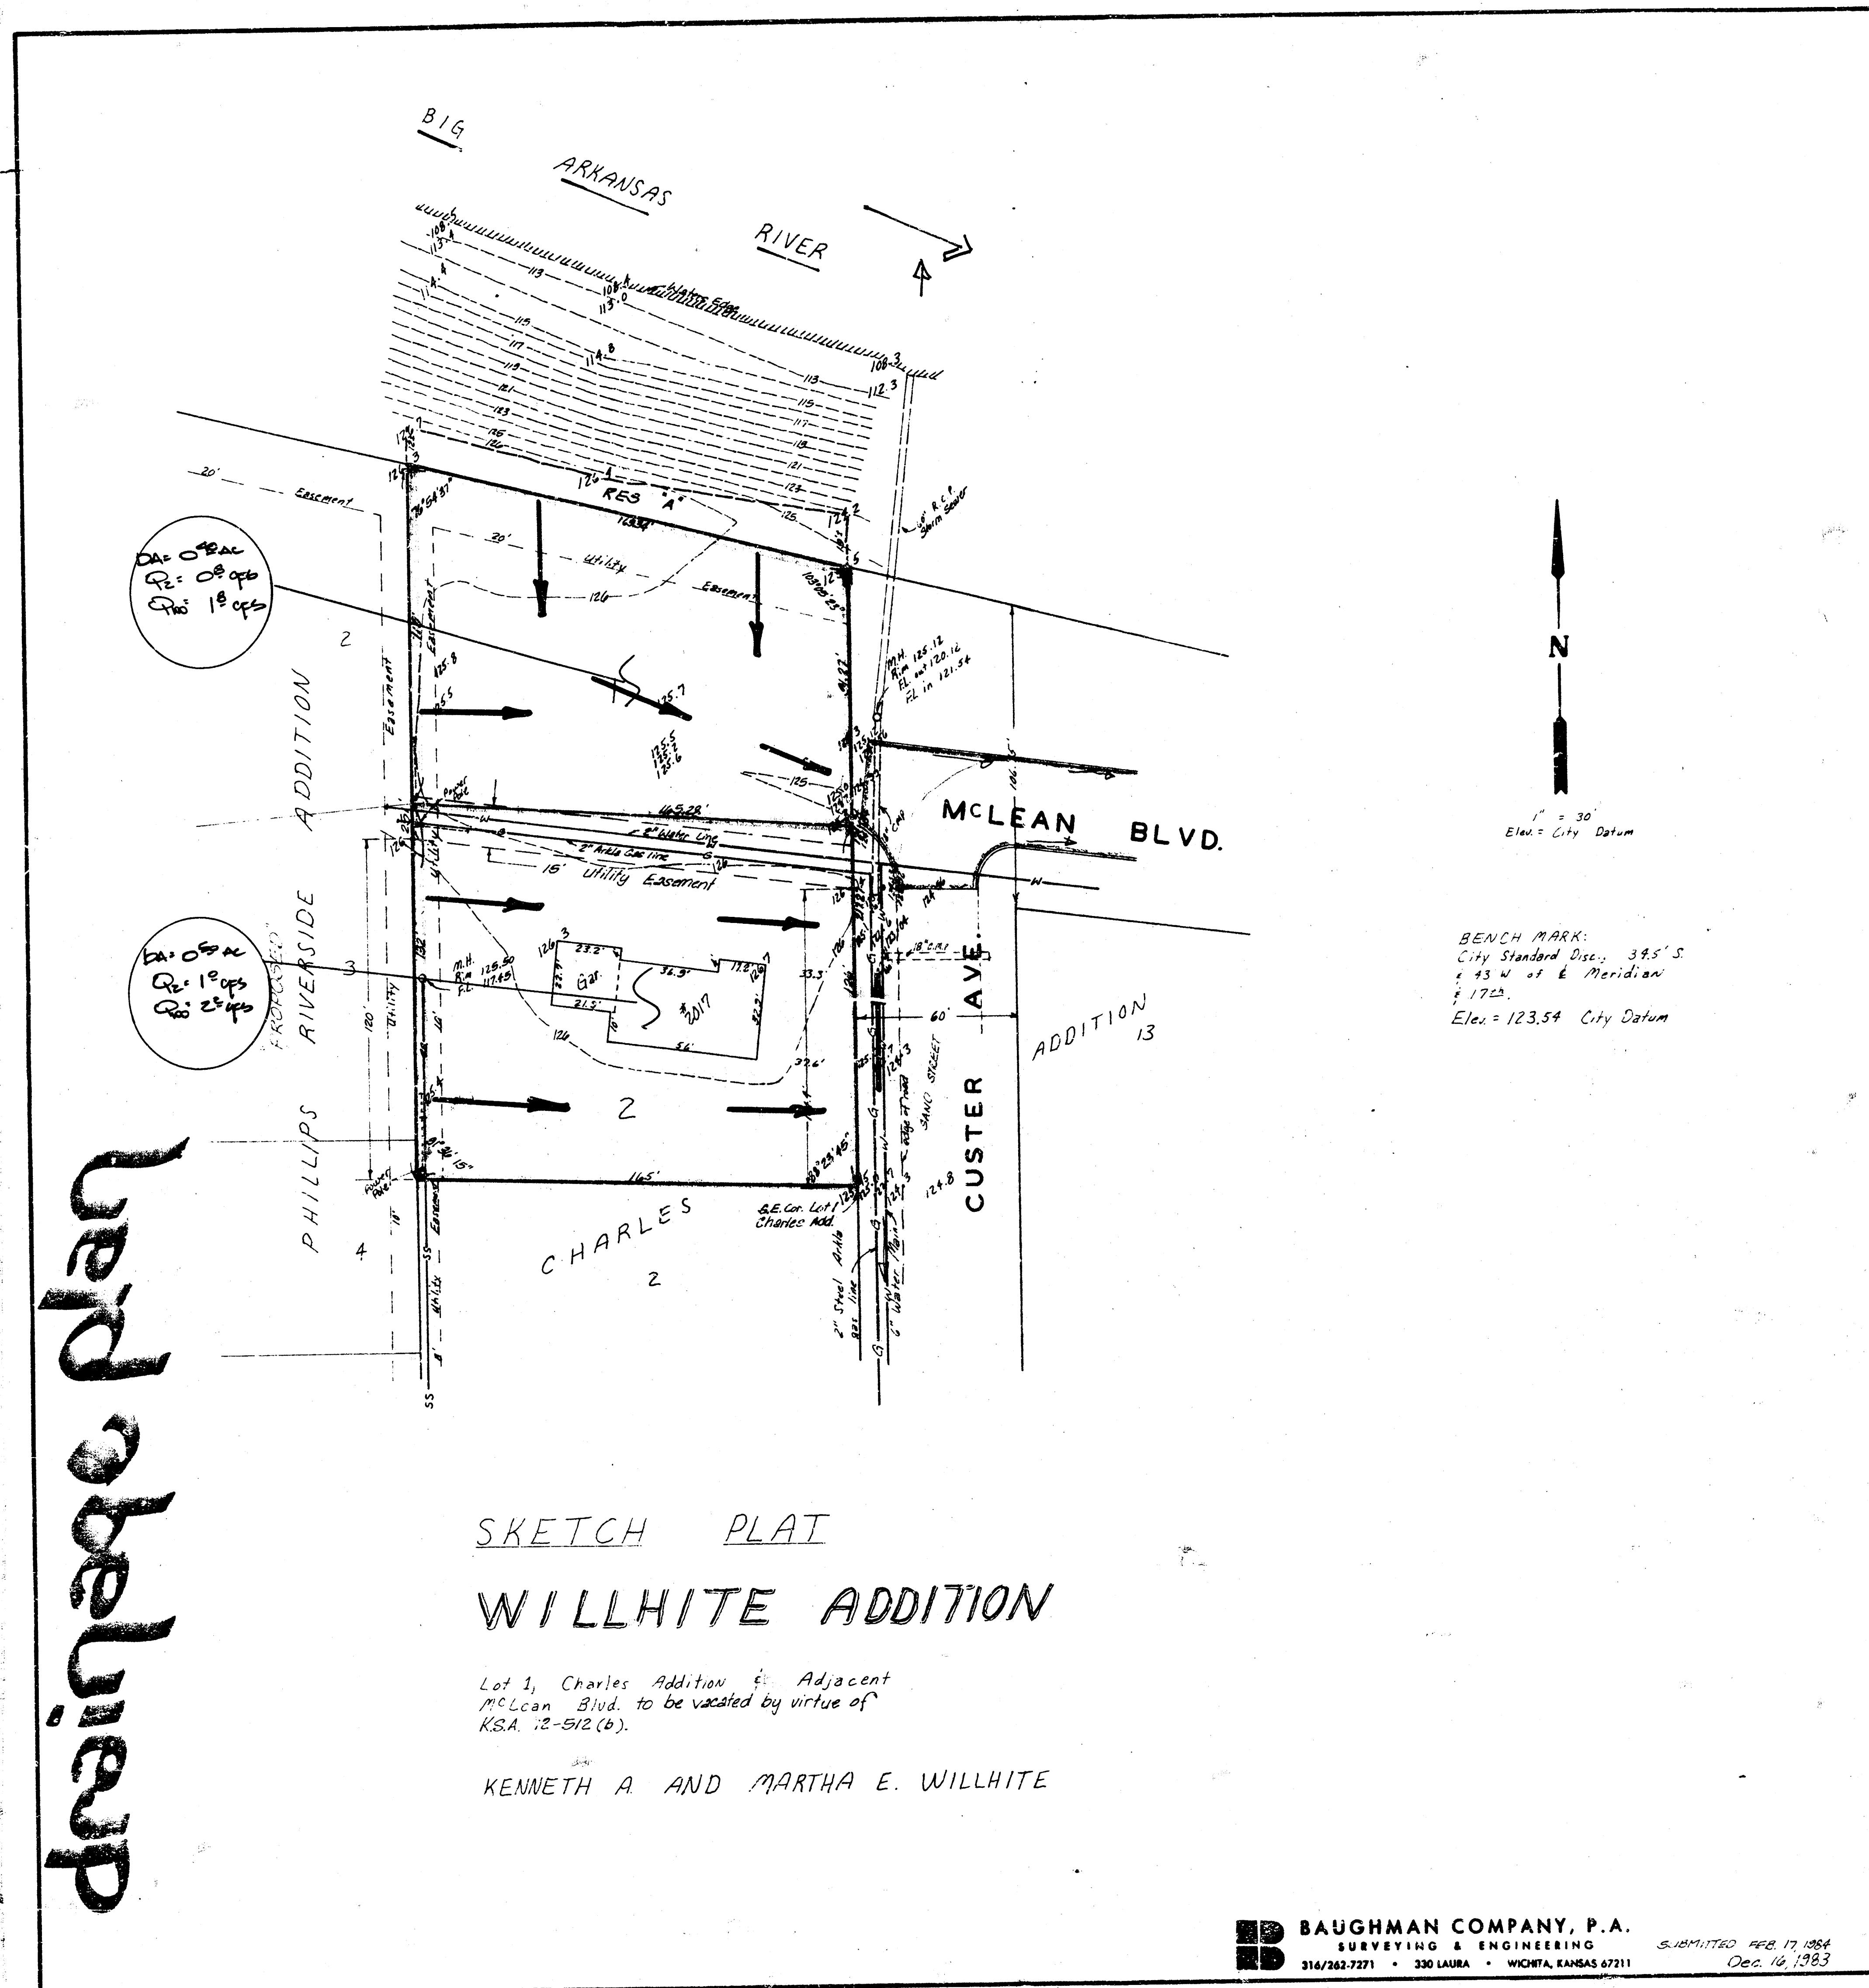

Drainage Plan

SKETCH PLAT
WILLHITE ADDITION

Lot 1, Charles Addition & Adjacent
McLean Blvd. to be vacated by virtue of
KSA 12-512(b).

KENNETH A. AND MARTHA E. WILLHITE

BAUGHMAN COMPANY, P.A.
SURVEYING & ENGINEERING
316/262-7271 • 330 LAURA • WICHITA, KANSAS 67211
SUBMITTED FEB. 17, 1984
Dec. 16, 1983