
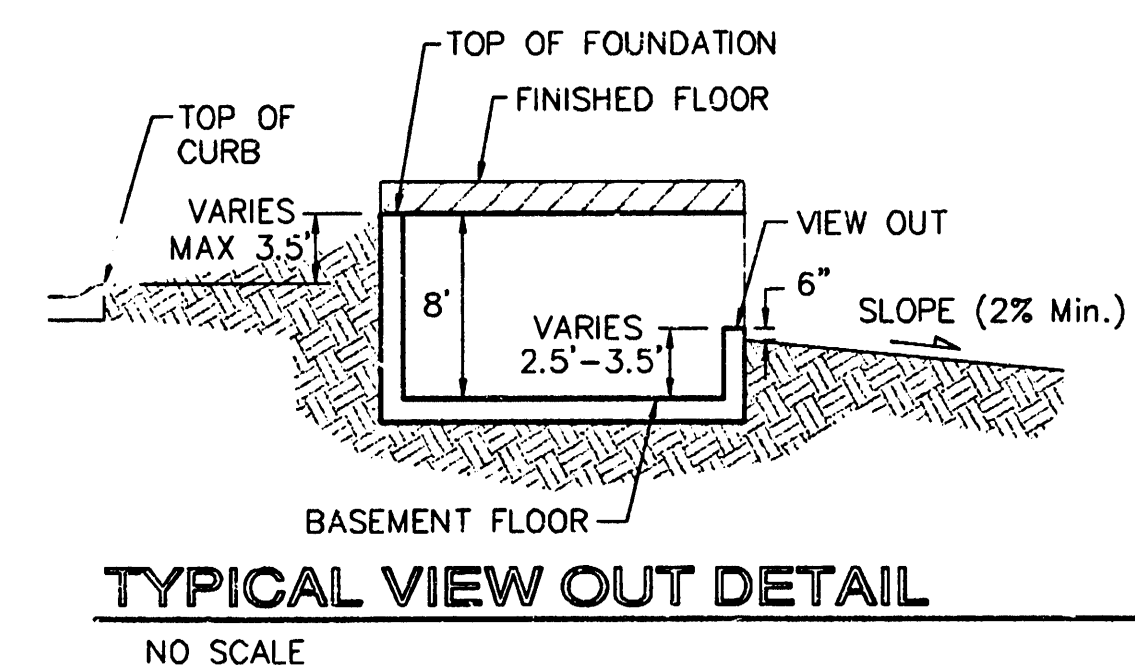
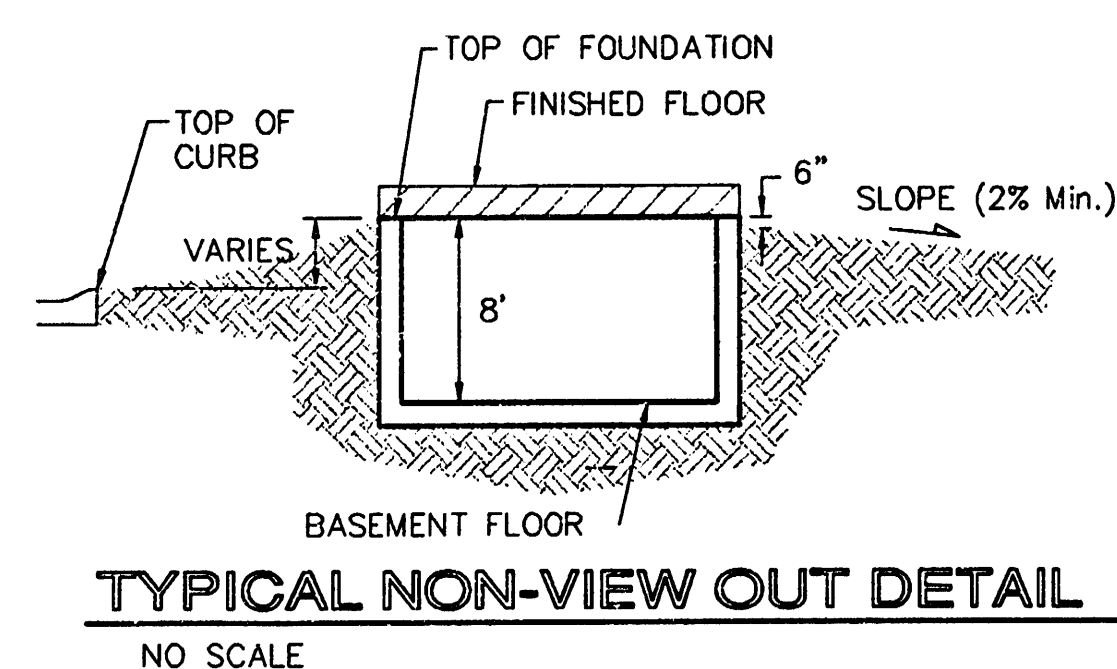
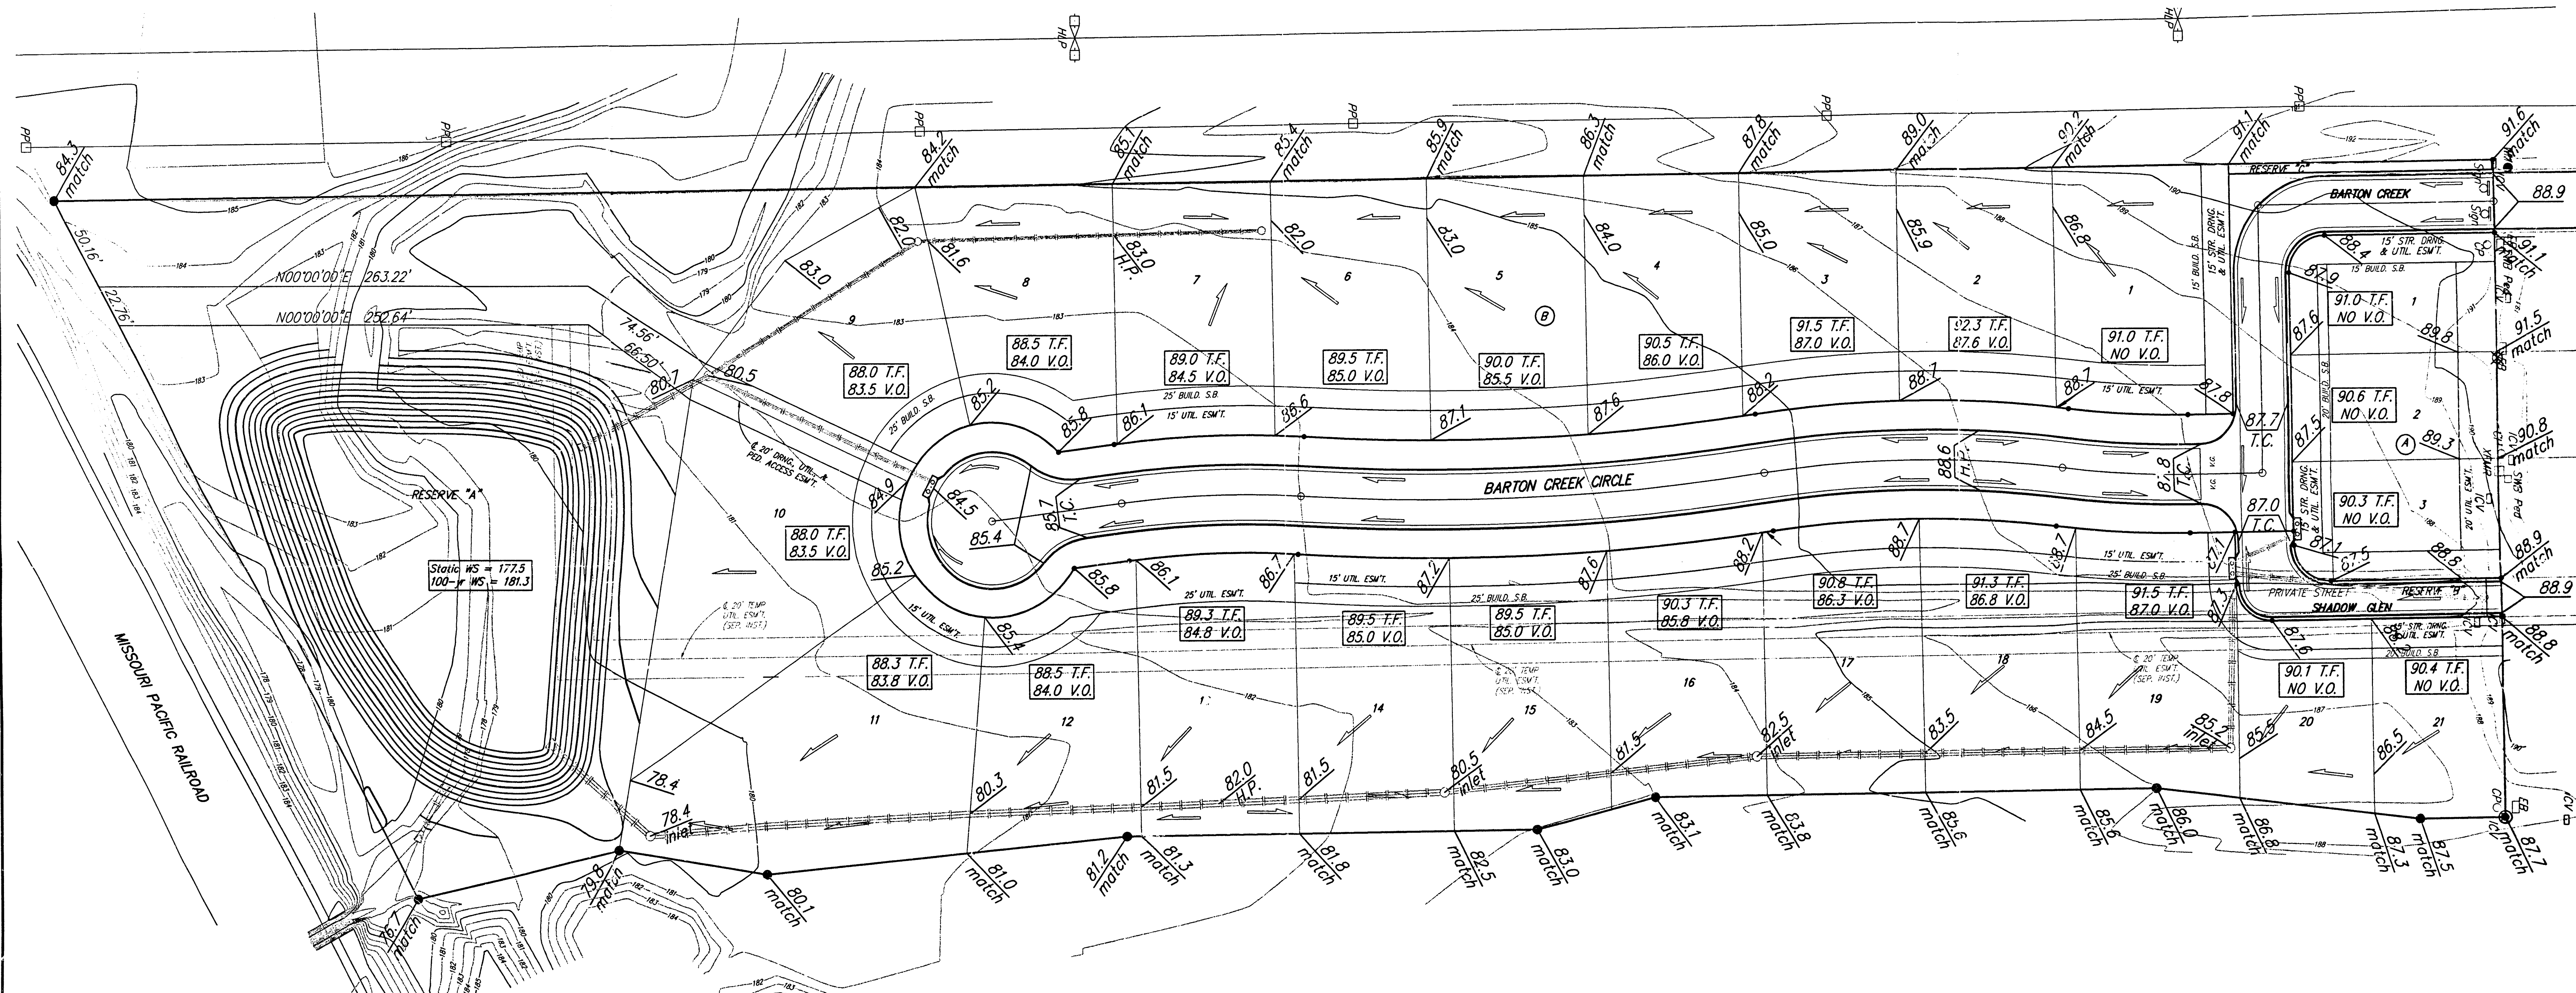


BENCHMARK:
 "□" Top of Curb, ENE Curb return,
 Barton Creek & Castle Pines St.,
 Elev. = 196.79 City Datum
 (1384.19 NGVD29)

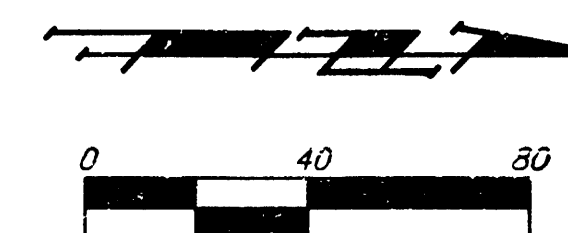

NOTES:
 Proposed Top of Foundation Elevations Are Shown On Plans. Contractor to Set Finished Floor Elevations.
 All Street Elevations Shown on Plans Are for Top of Curb (Full-Height).

This Grading Plan is Designed with View-Outs.
 Elevations Shown at Rear of House (XX.X V.O.)
 Lot dimensions have been omitted on this plan, refer to the recorded plat for this information.

**APPROVED
 DRAINAGE PLAN**

Revised T.F. Lots 2-3, Block A 9/29/03 by AEG

WILLOWBEND NORTH ESTATES 2ND ADD.			
GRADING PLAN			
WICHITA, KANSAS			
BAUGHMAN COMPANY P.A.			
ENGINEERING, SURVEYING, & PLANNING			
316-262-7271 • 315 ELLIS • WICHITA, KANSAS 67211			
PROJECT NUMBER		SHEET	
DESIGN BLG/NBW		1	
DRAWN BLG/SMD		1	
APPROVED		SCALE	
DATE 04-21-03		NOTED	