


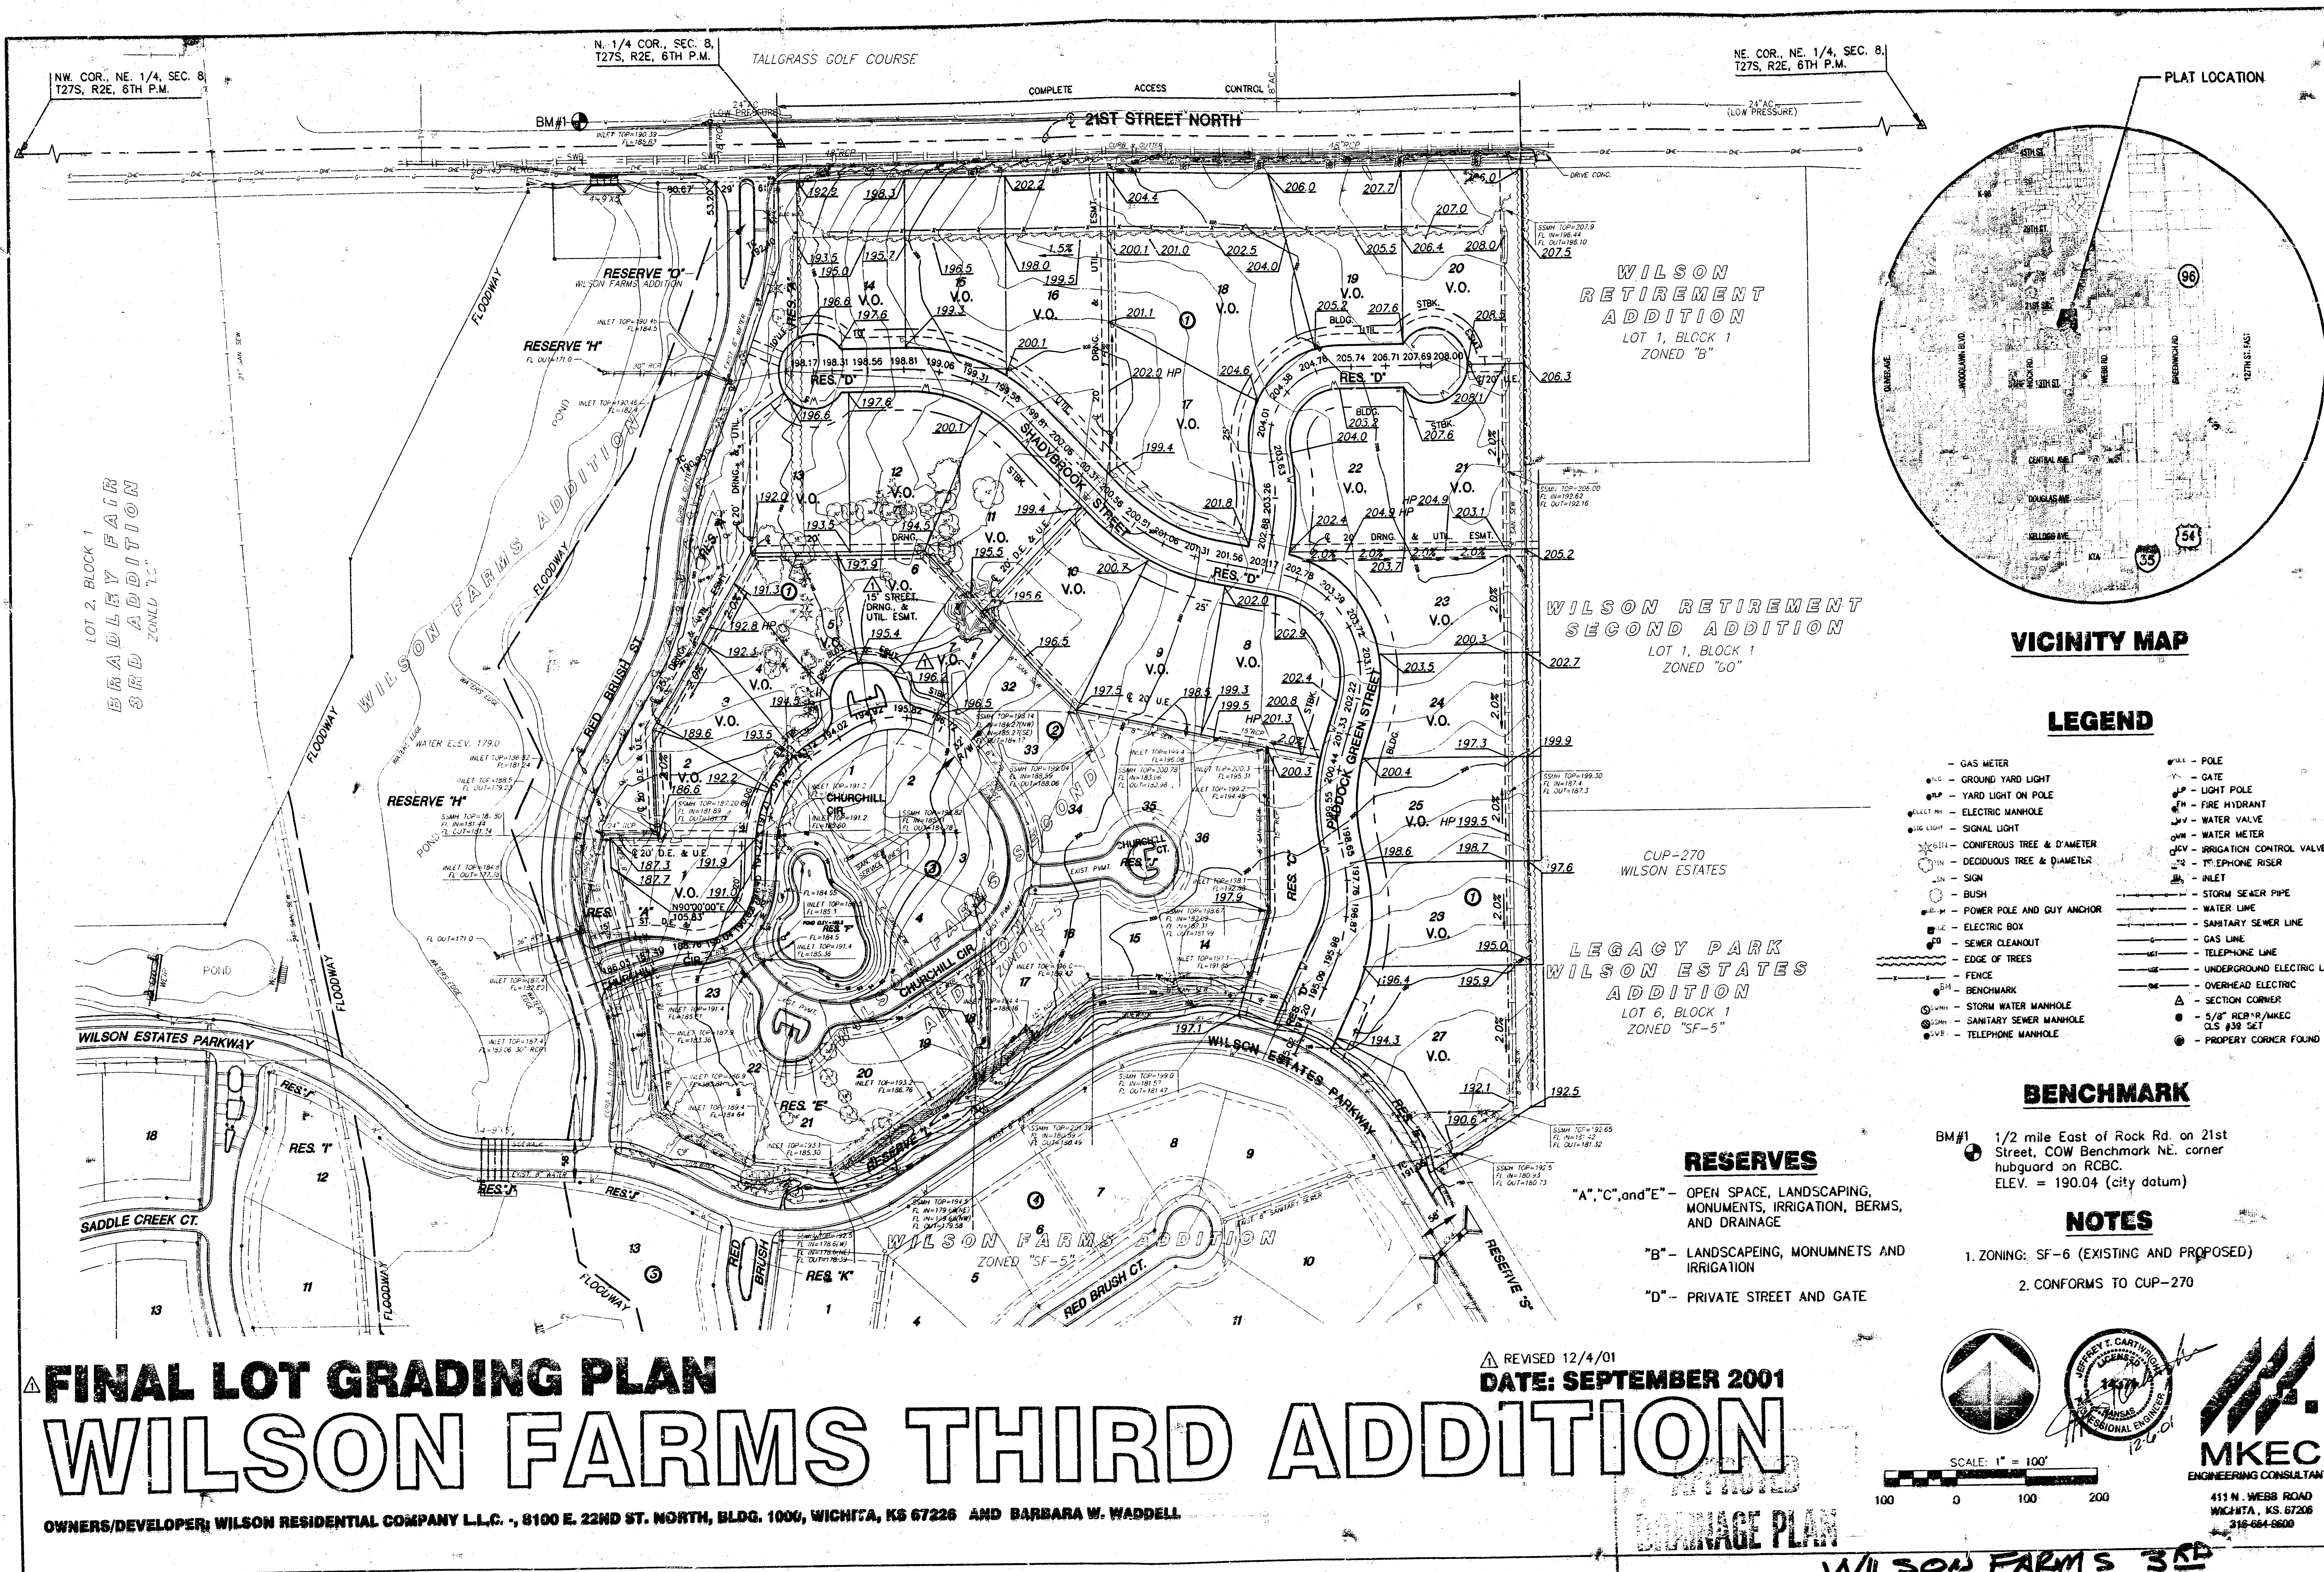

FINAL LOT GRADING PLAN WILSON FARMS THIRD ADDITION

OWNERS/DEVELOPER: WILSON RESIDENTIAL COMPANY L.L.C. - 8100 E. 22ND ST. NORTH, BLDG. 1000, WICHITA, KS 67226 AND BARBARA W. WADDELL

REVISED 12/4/01
DATE: SEPTEMBER 2001

SCALE: 1" = 100'
100 0 100 200

MKEC
ENGINEERING CONSULTANTS
4111 N. WEBB ROAD
WICHITA, KS 67206
316-684-5800

WILSON FARMS 3RD

H:\CIVIL\05155\01202\LINE\WILSON FARMS THIRD ADDITION.DWG Thu Dec 06 11:20:16 2001