




VICINITY MAP

WILSON SCHOOL ADDITION

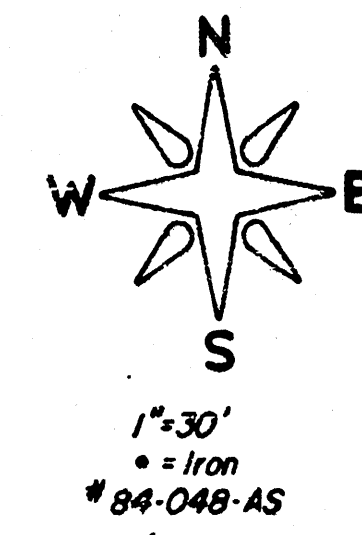

LEGEND:
 W = Water
 W.M. = Water Meter
 F.H. = Fire Hydrant
 S.S. = Sanitary Sewer
 M.H. = Manhole
 O.E. = Overhead Electric
 O.T. = Overhead Telephone

G = Gas
 T.S. = Traffic Signs
 S.L.C. = Street Light Circuit
 G.M. = Gas Meter
 [Symbol] = Concrete Pavement
 [Symbol] = Asphalt Pavement

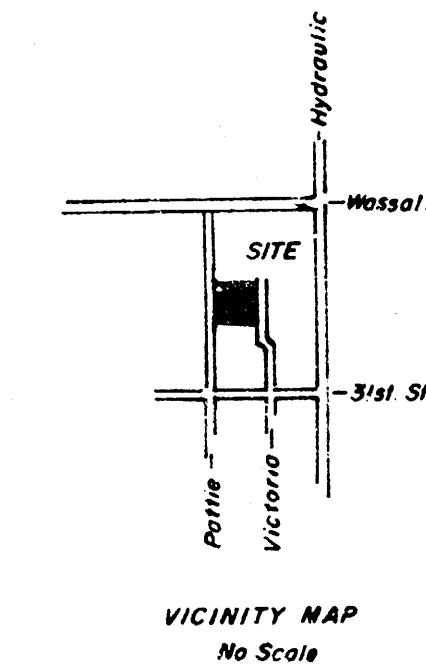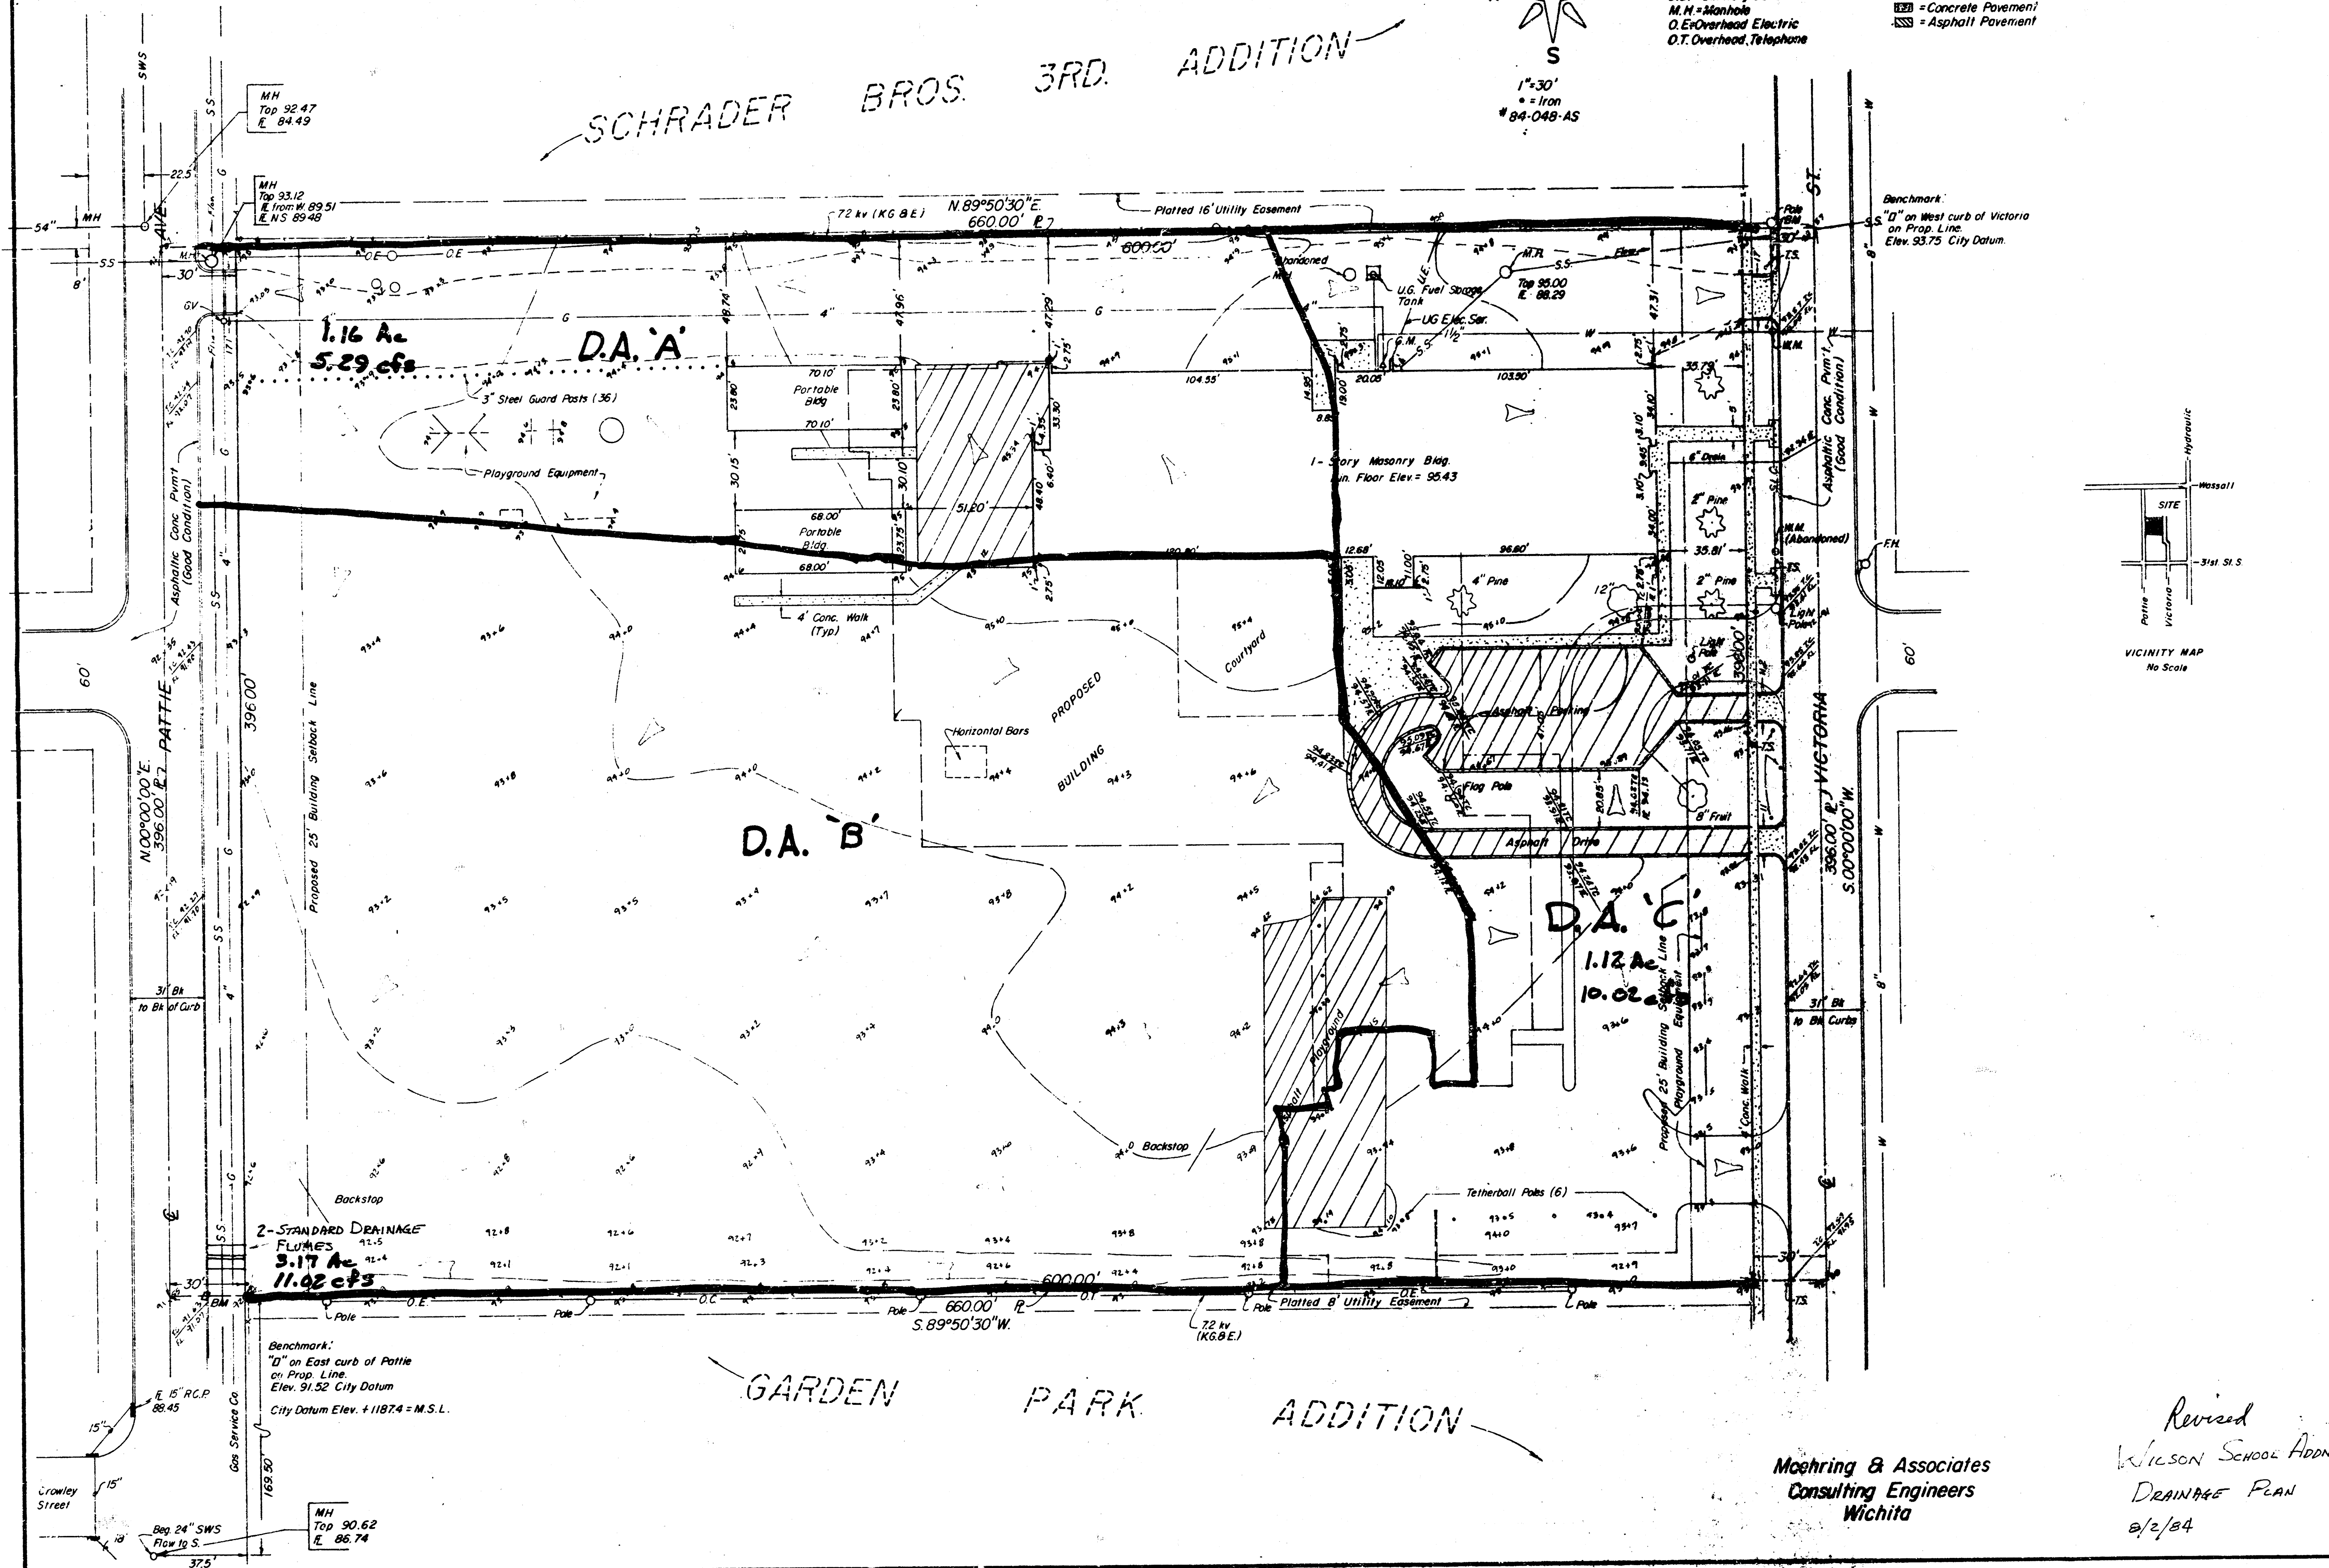


Moehring & Associates
 Consulting Engineers
 Wichita

Revised
 WILSON SCHOOL ADDN.
 DRAINAGE PLAN
 8/2/84

WILSON SCHOOL ADDITION
(Drainage)

VICINITY MAP

WILSON SCHOOL ADDITION


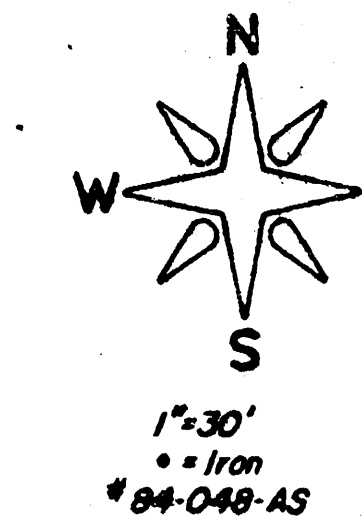


LEGEND:

W. = Water
W.M. = Water Meter
F.H. = Fire Hydrant
S.S. = Sanitary Sewer
M.H. = Manhole
O.E. = Overhead Electric
O.T. = Overhead Telephone

G. = Gas
T.S. = Traffic Signs
S.L.C. = Street Light Circuit
G.M. = Gas Meter
C.P. = Concrete Pavement
A.P. = Asphalt Pavement

Benchmark:
"D" on West curb of Victoria
on Prop. Line
Elev. 93.75 City Datum

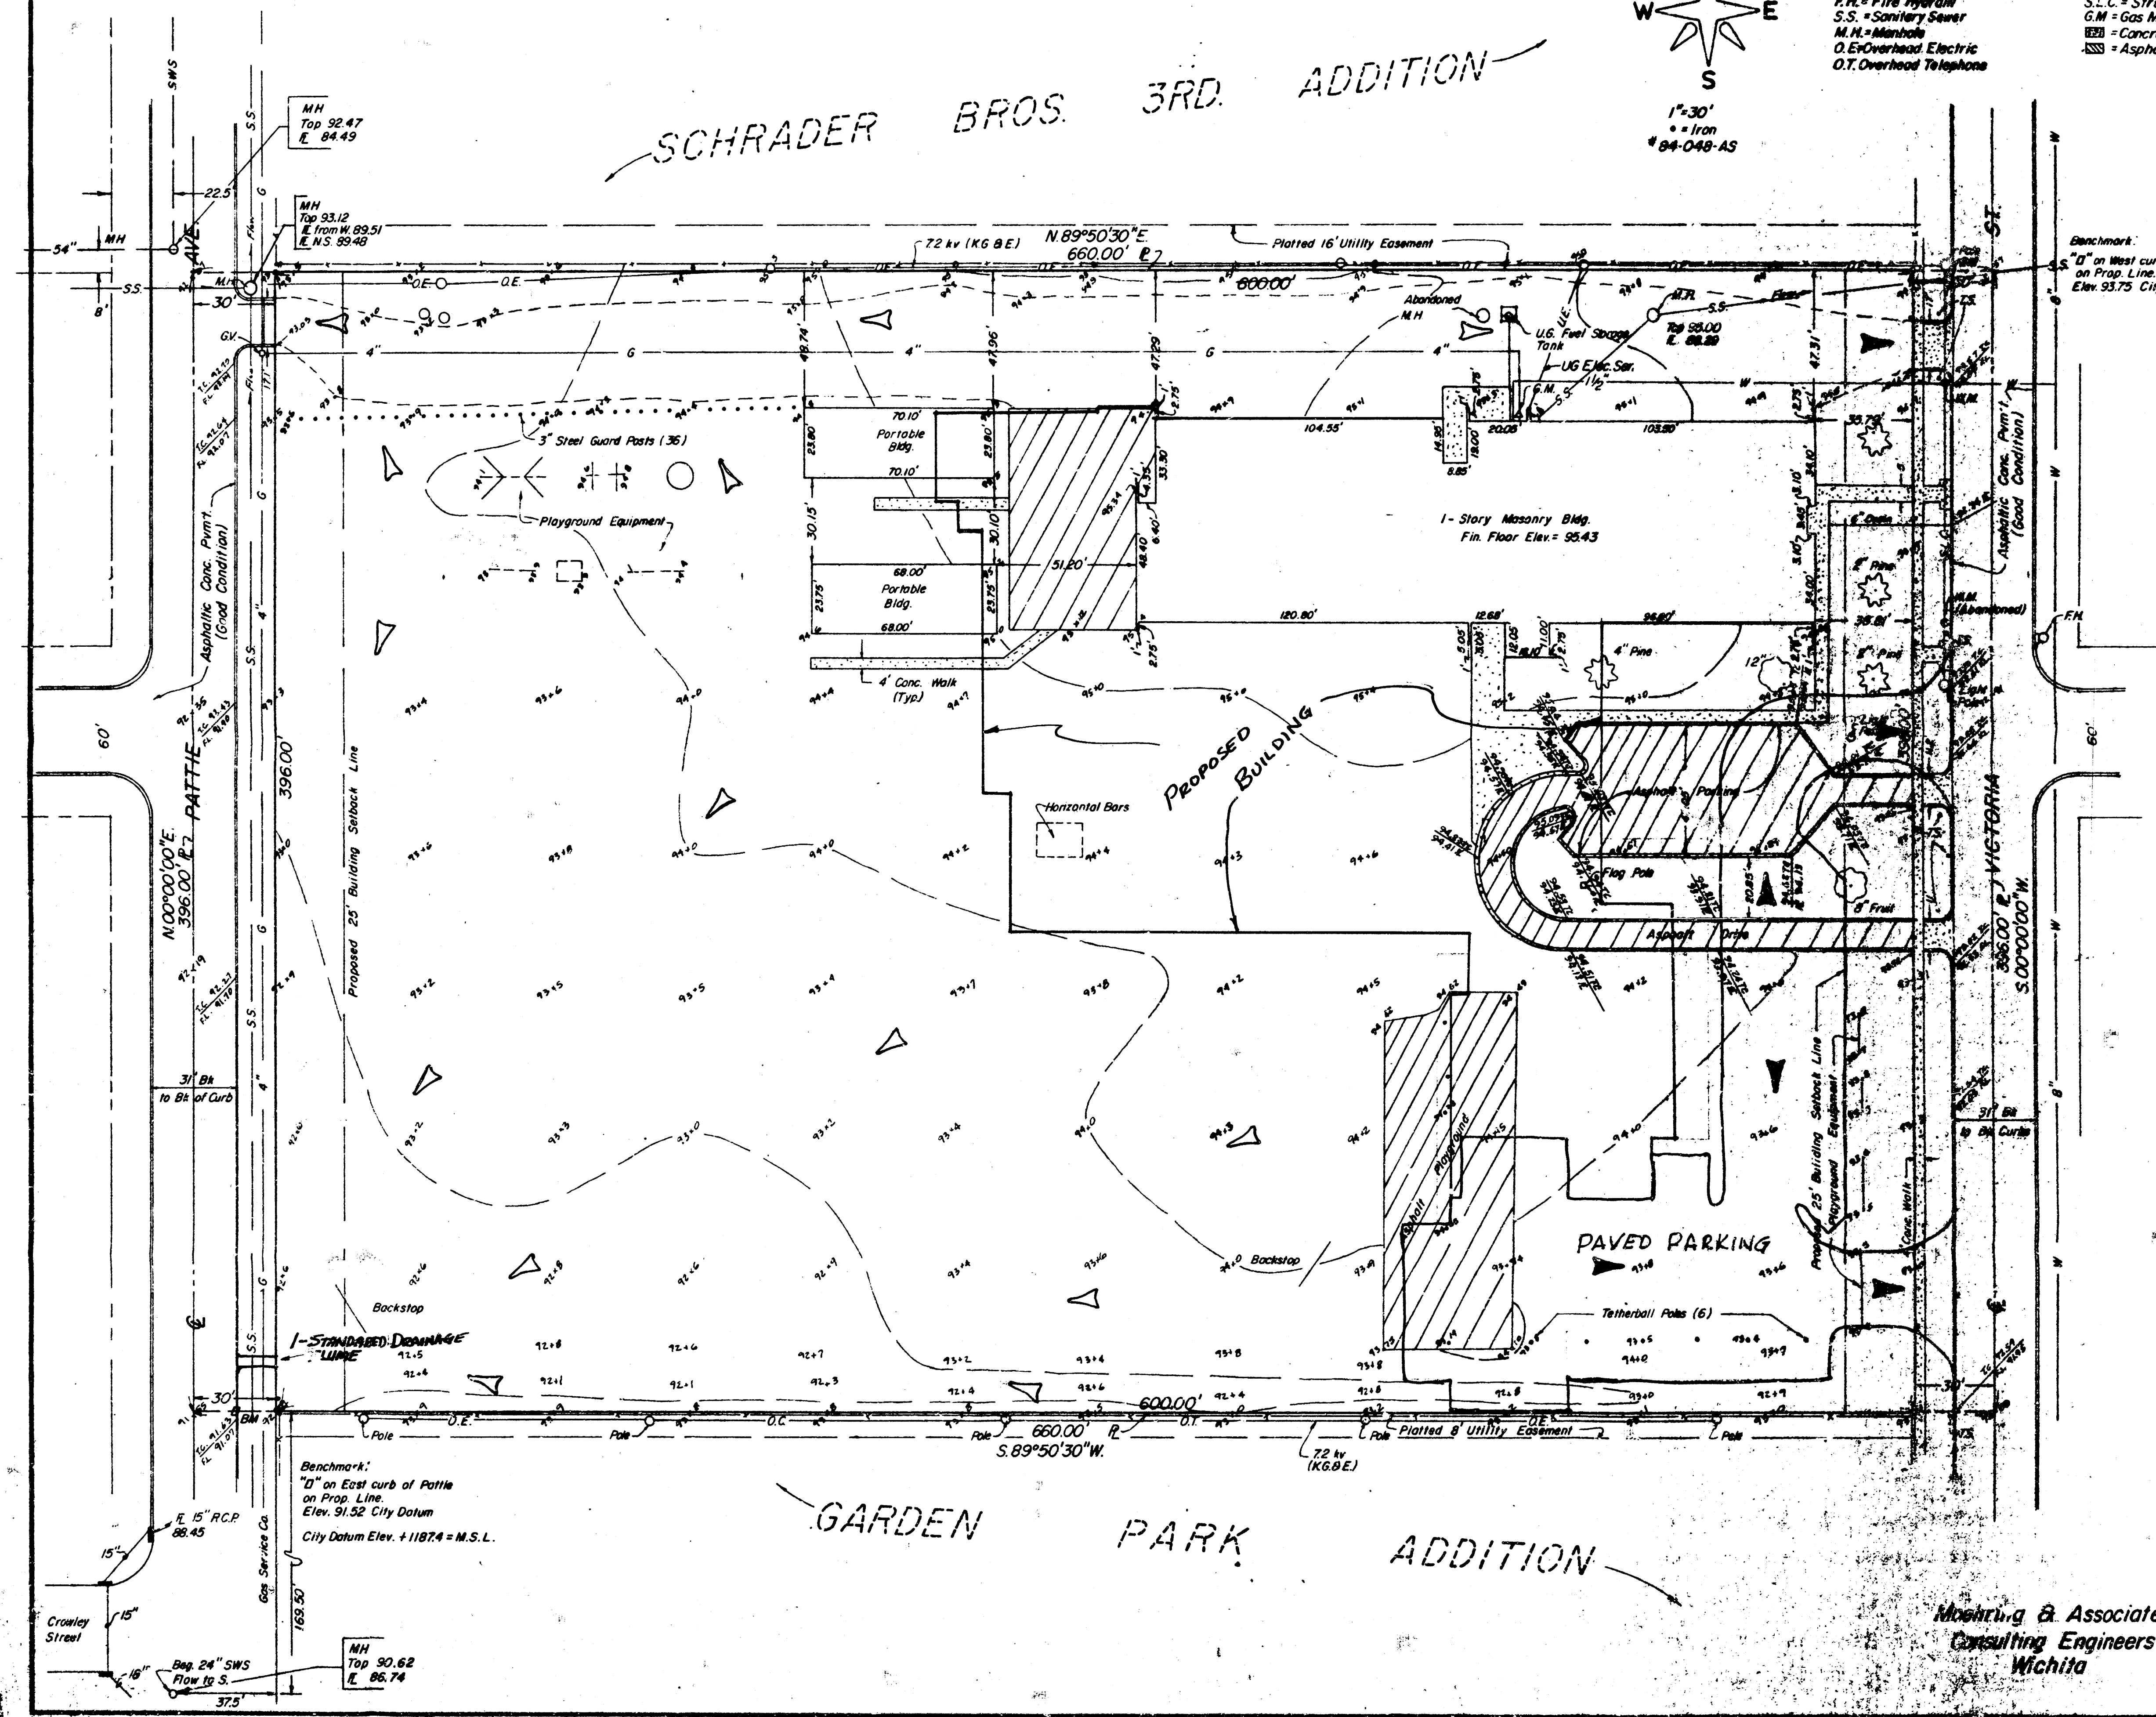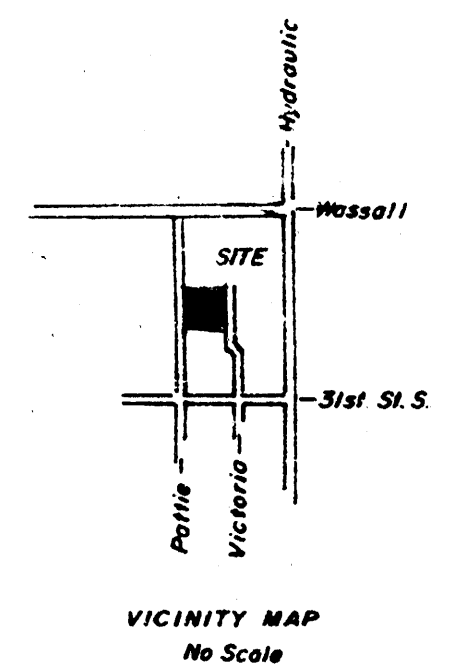

Mooring & Associates
Consulting Engineers
Wichita