


PRELIMINARY PLAT
WONG 2ND ADDITION
 WICHITA, SEDGWICK COUNTY, KANSAS

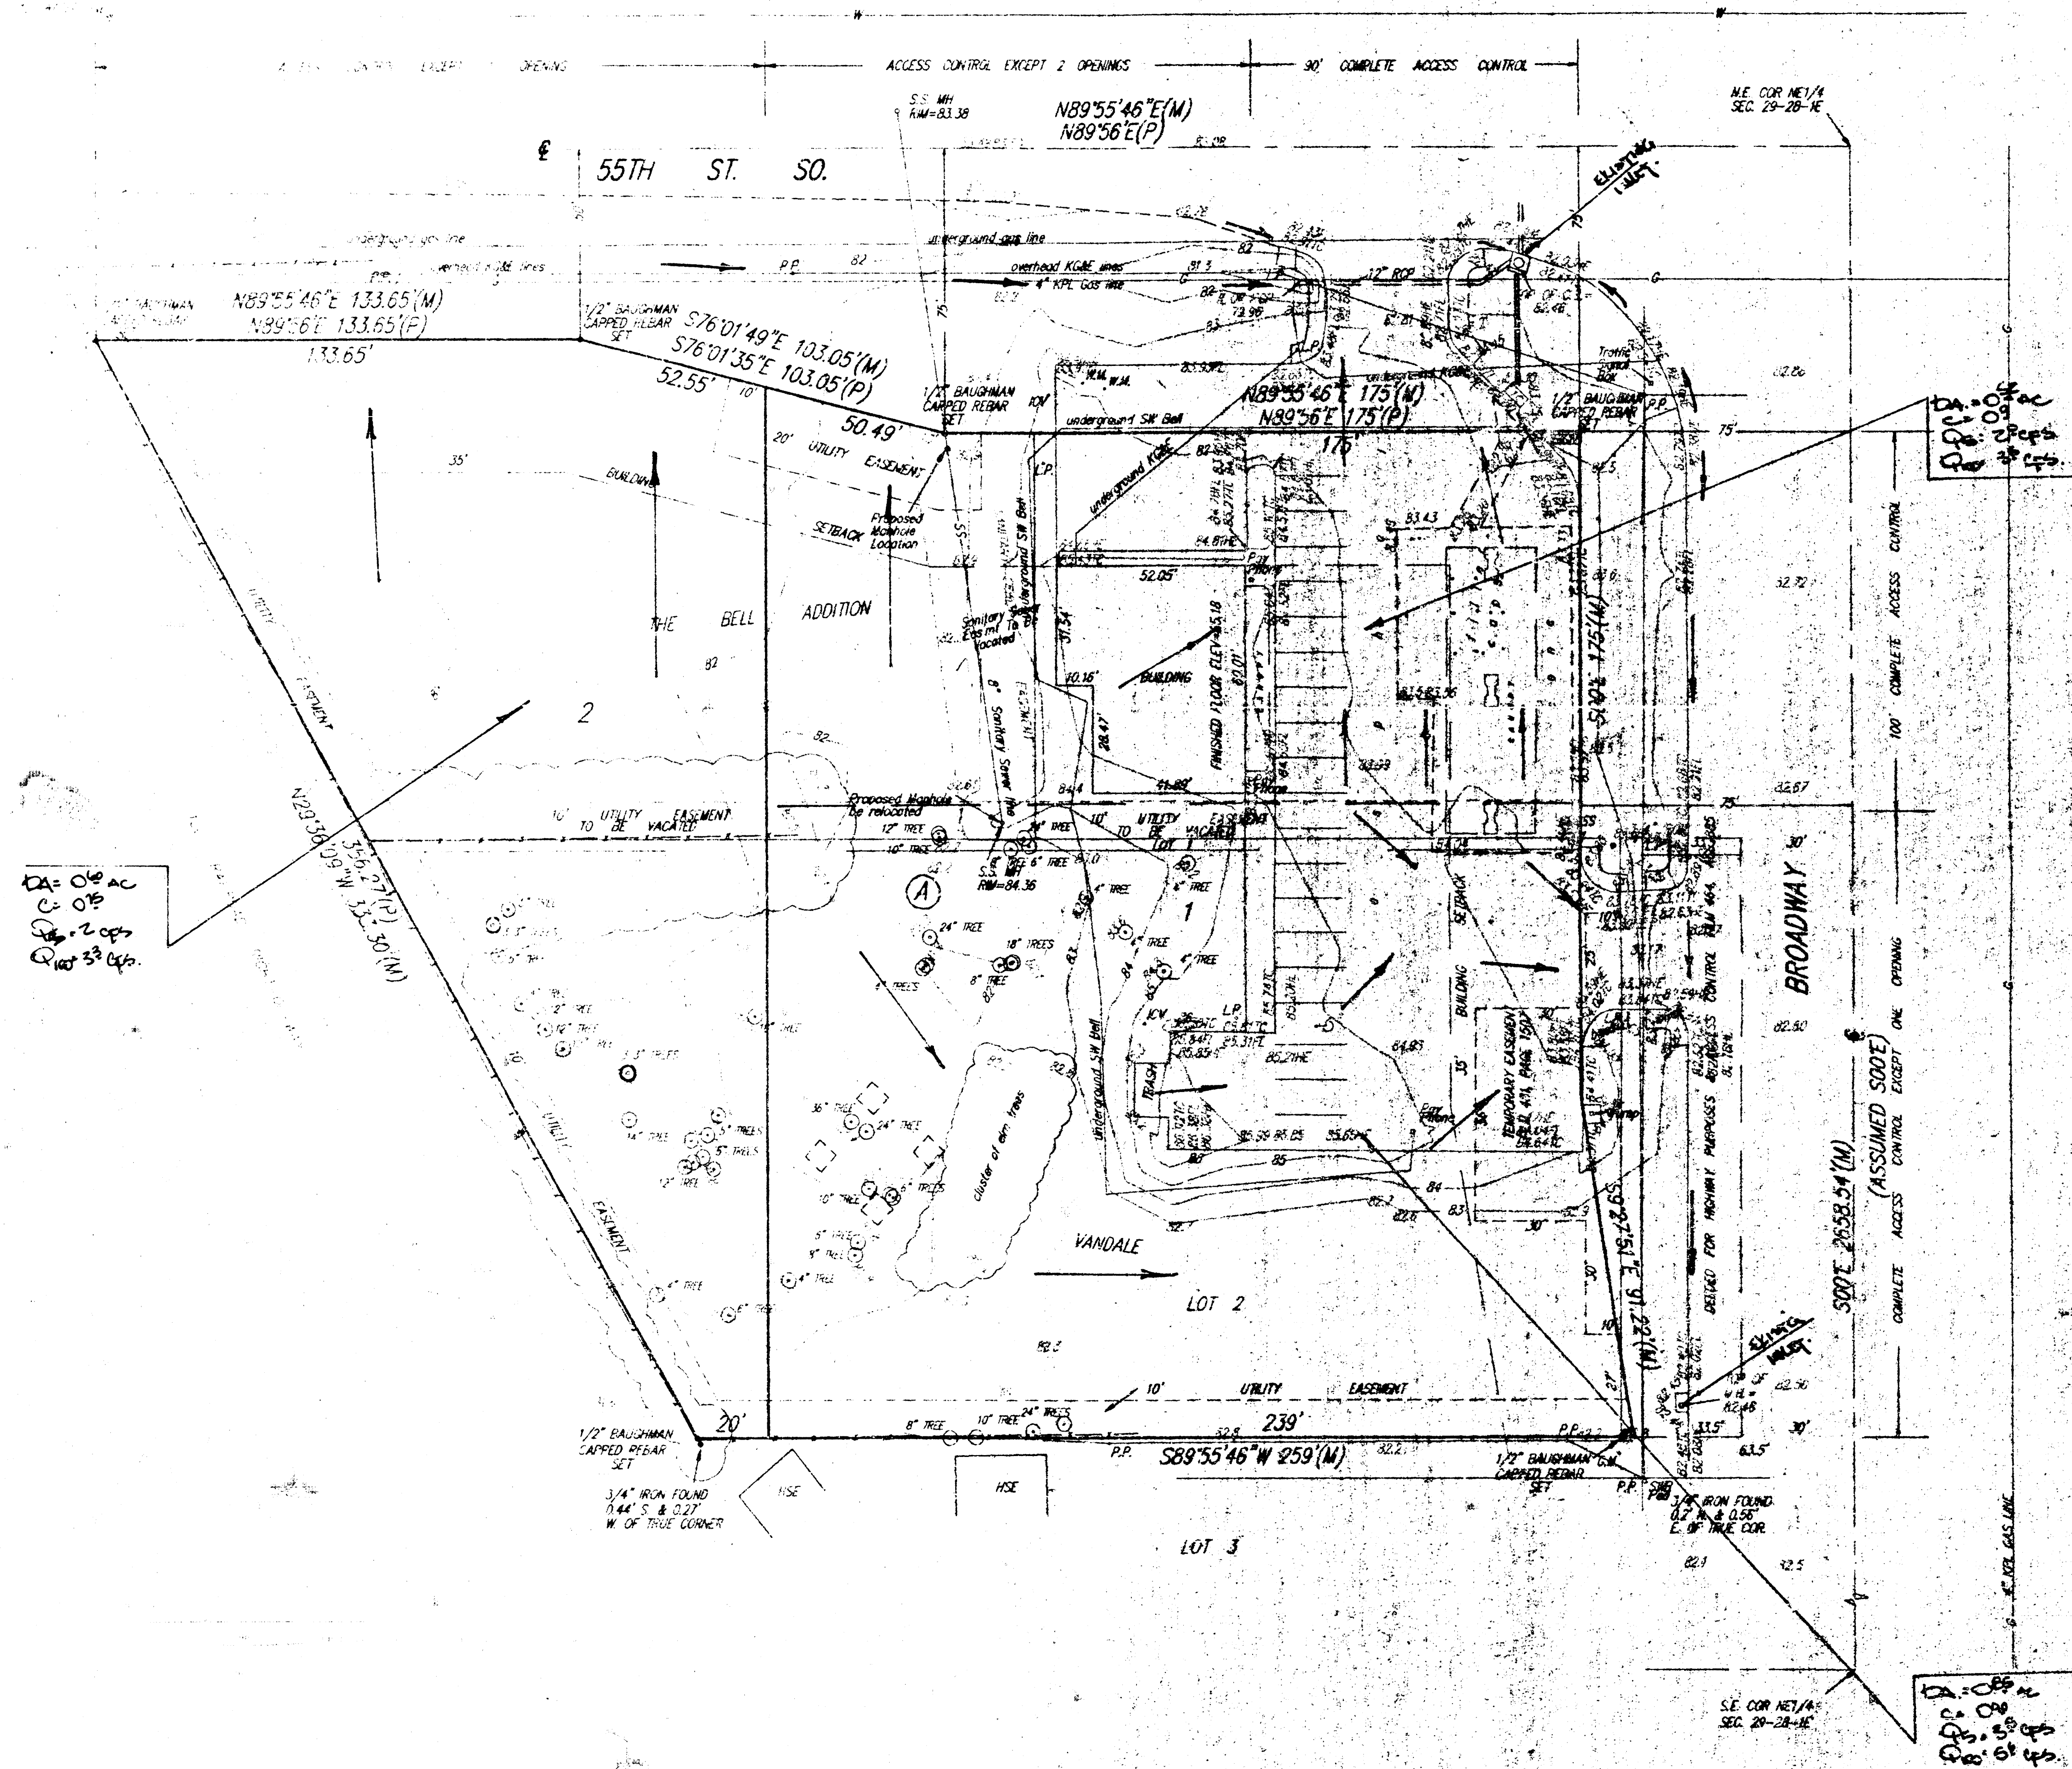

DRAINAGE PLAN