
C-23
N 275 Incidental drainage Hillside Ave

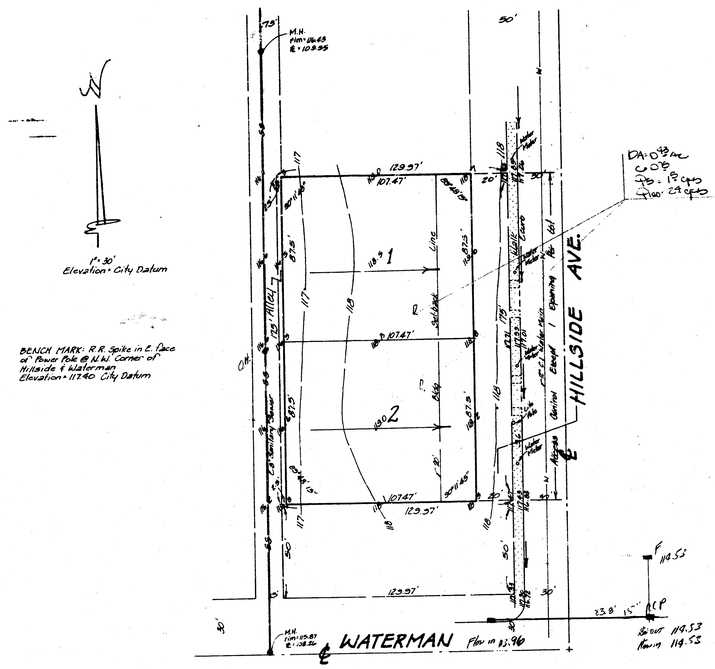

f=30'
Elevation = City Datum

BENCH MARK: R.R. Spike in E. face of Power Pole @ N.W. Corner of Hillside & Waterman
Elevation = 1174.0 City Datum

SKETCH PLAT

ZAKAS 6TH ADDITION

REPLAT OF LOTS 32, 34, 36, 38, 40, 42 & 44 ON HILLSIDE, MUELLERS SUBDIVISION OF LOTS 1 AND 4 IN BLOCK 4, RICHLANDS 2ND ADDITION, WICHITA, KANSAS

OWNER: JOHN H. ZAKAS
CONNIE L. ZAKAS

DRAINAGE PLAN

BAUGHMAN COMPANY, P.A.
SURVEYING & ENGINEERING
316/265-7271 • 315 ELLIS • WICHITA, KANSAS 67211

15 Jun 1988

ZAKAS 6TH ADDITION (Drainage)