

**WATER DISTRIBUTION PLANS
ANDOVER ELEMENTARY SCHOOL #3
ANDOVER, KANSAS**


LINE 1
SHEET TITLE
06771
PROJECT NUMBER

DESIGN BY: **SRS**
DRAWN BY: **MK**
CHECKED BY: **MAB**


ISSUED: **MARCH 2007**
REVISED:

NOTES:
CONTRACTOR TO VERIFY THE DEPTH
AND LOCATION OF EXISTING
UTILITIES PRIOR TO CONSTRUCTION.


SHEET NO.
2 of 4

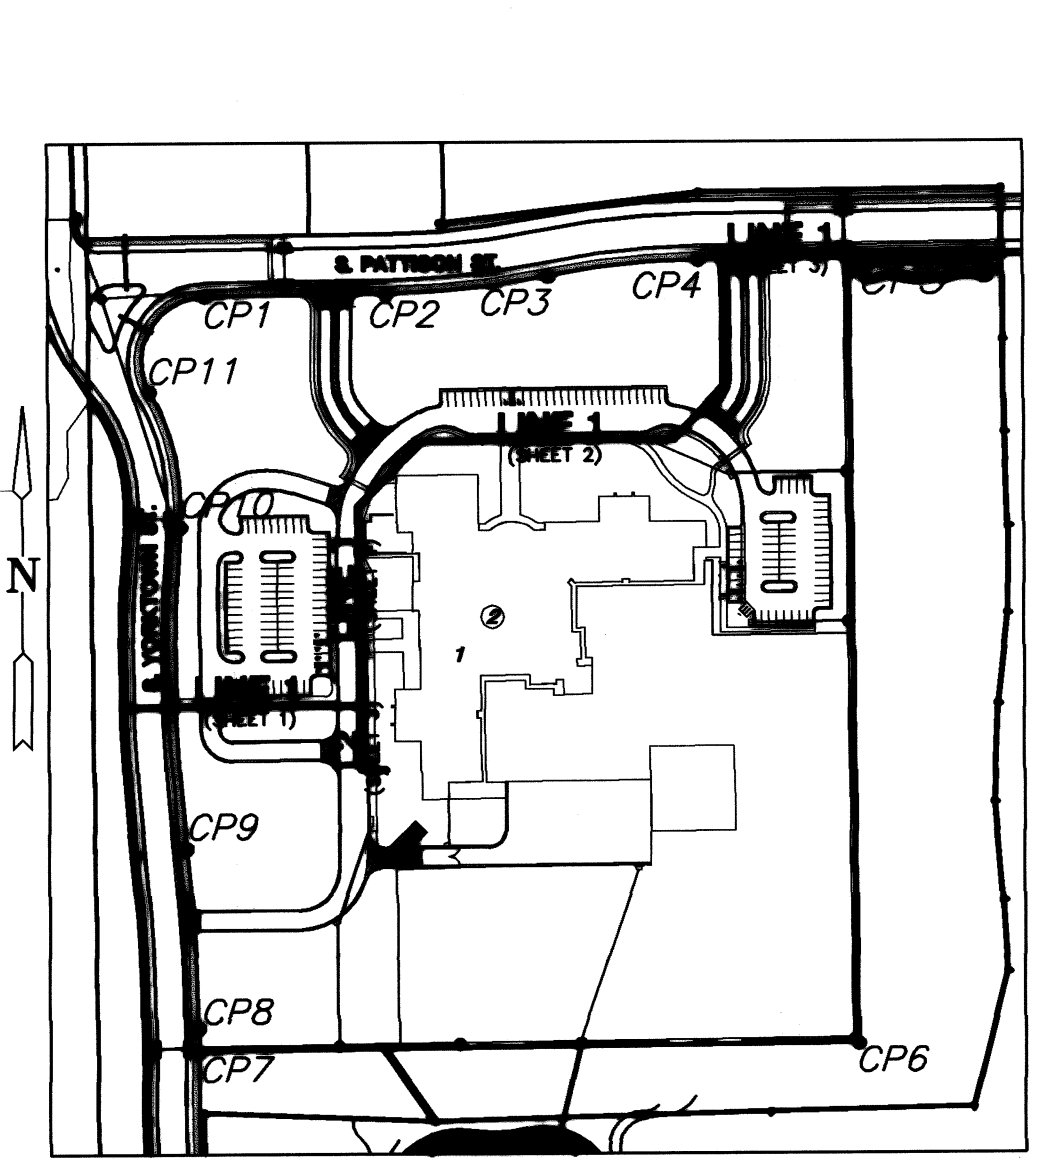

LOCATION MAP
NO SCALE

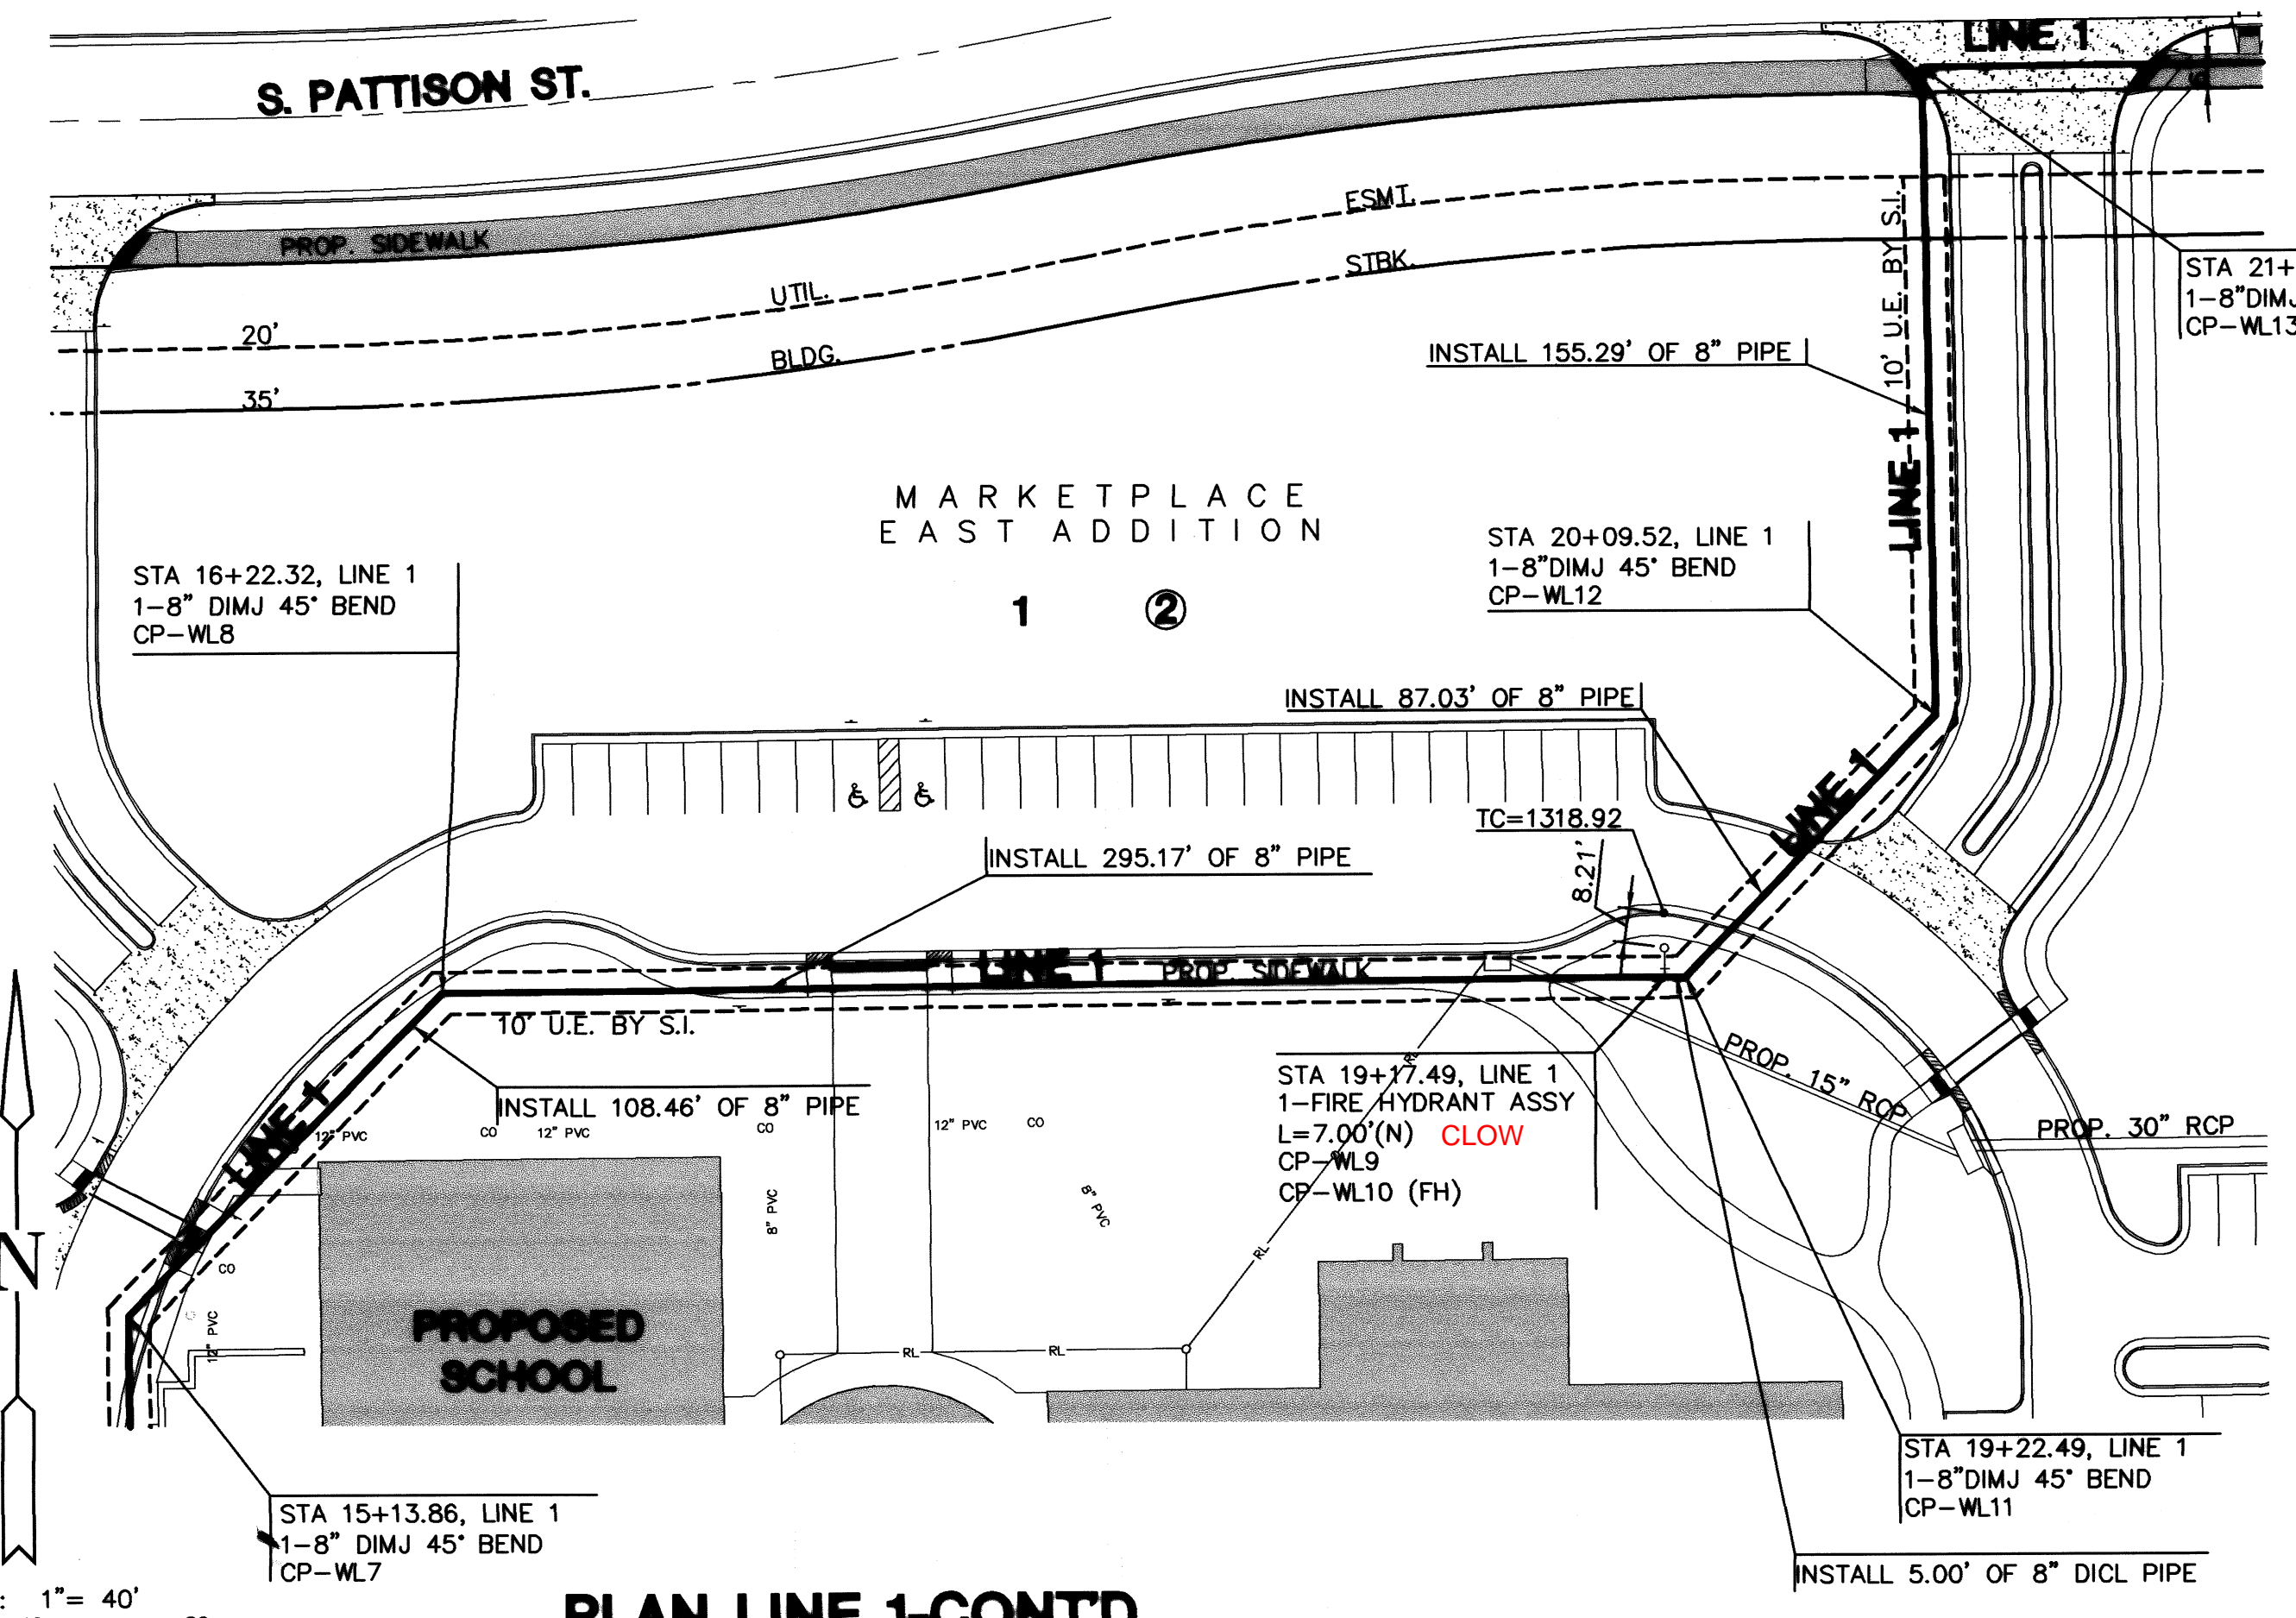


PLAN LINE 1-CONTD
SCALE: 1"=40'

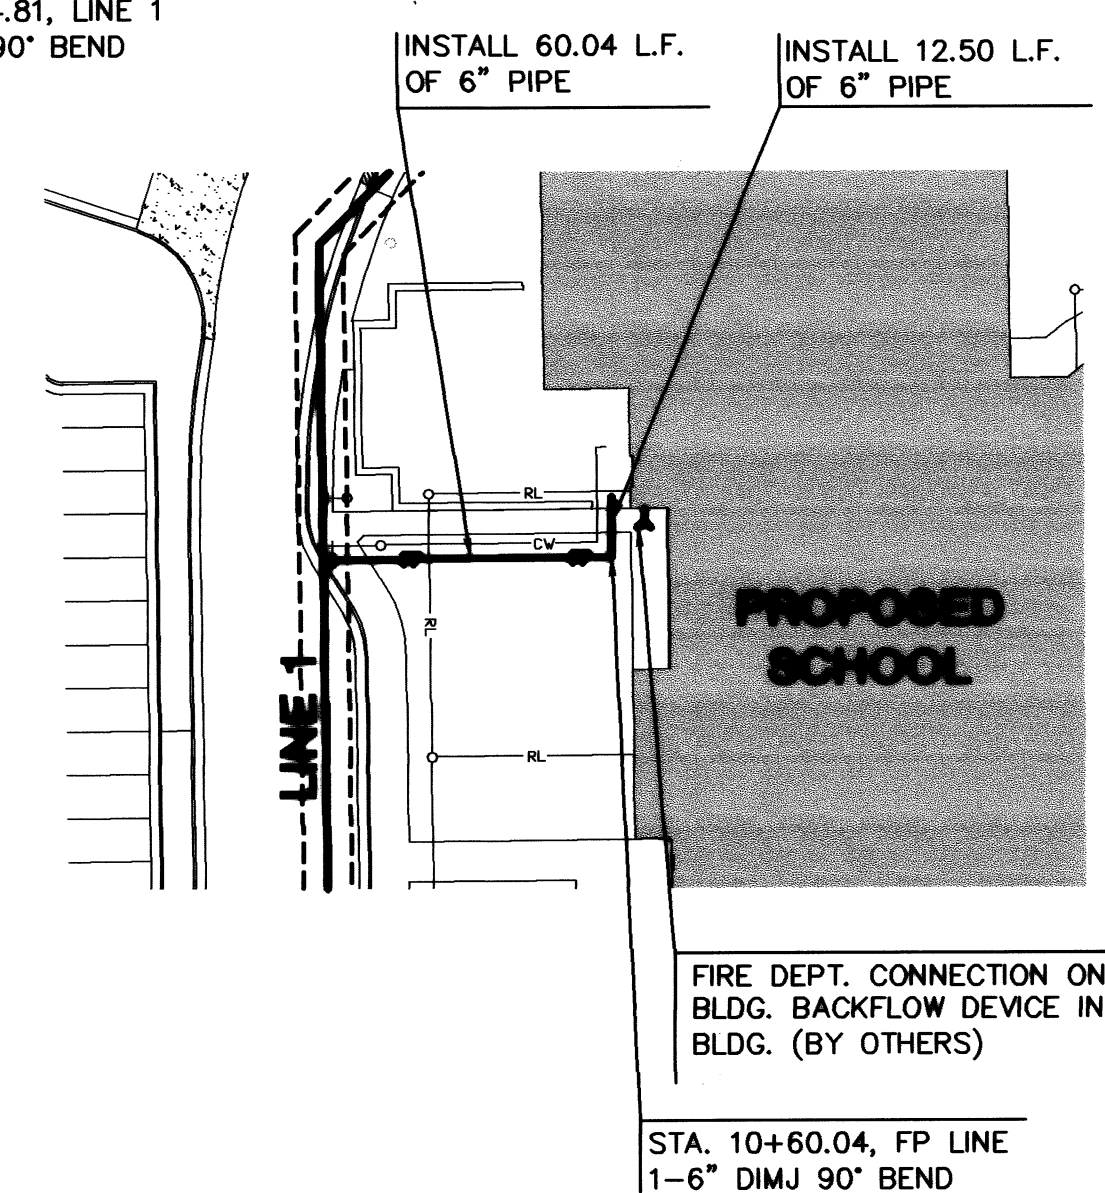

PLAN FIRE PROTECTION

PROFILE FIRE PROTECTION
SCALE: HORIZ. 1"=40'
SCALE: VERT. 1"=5'

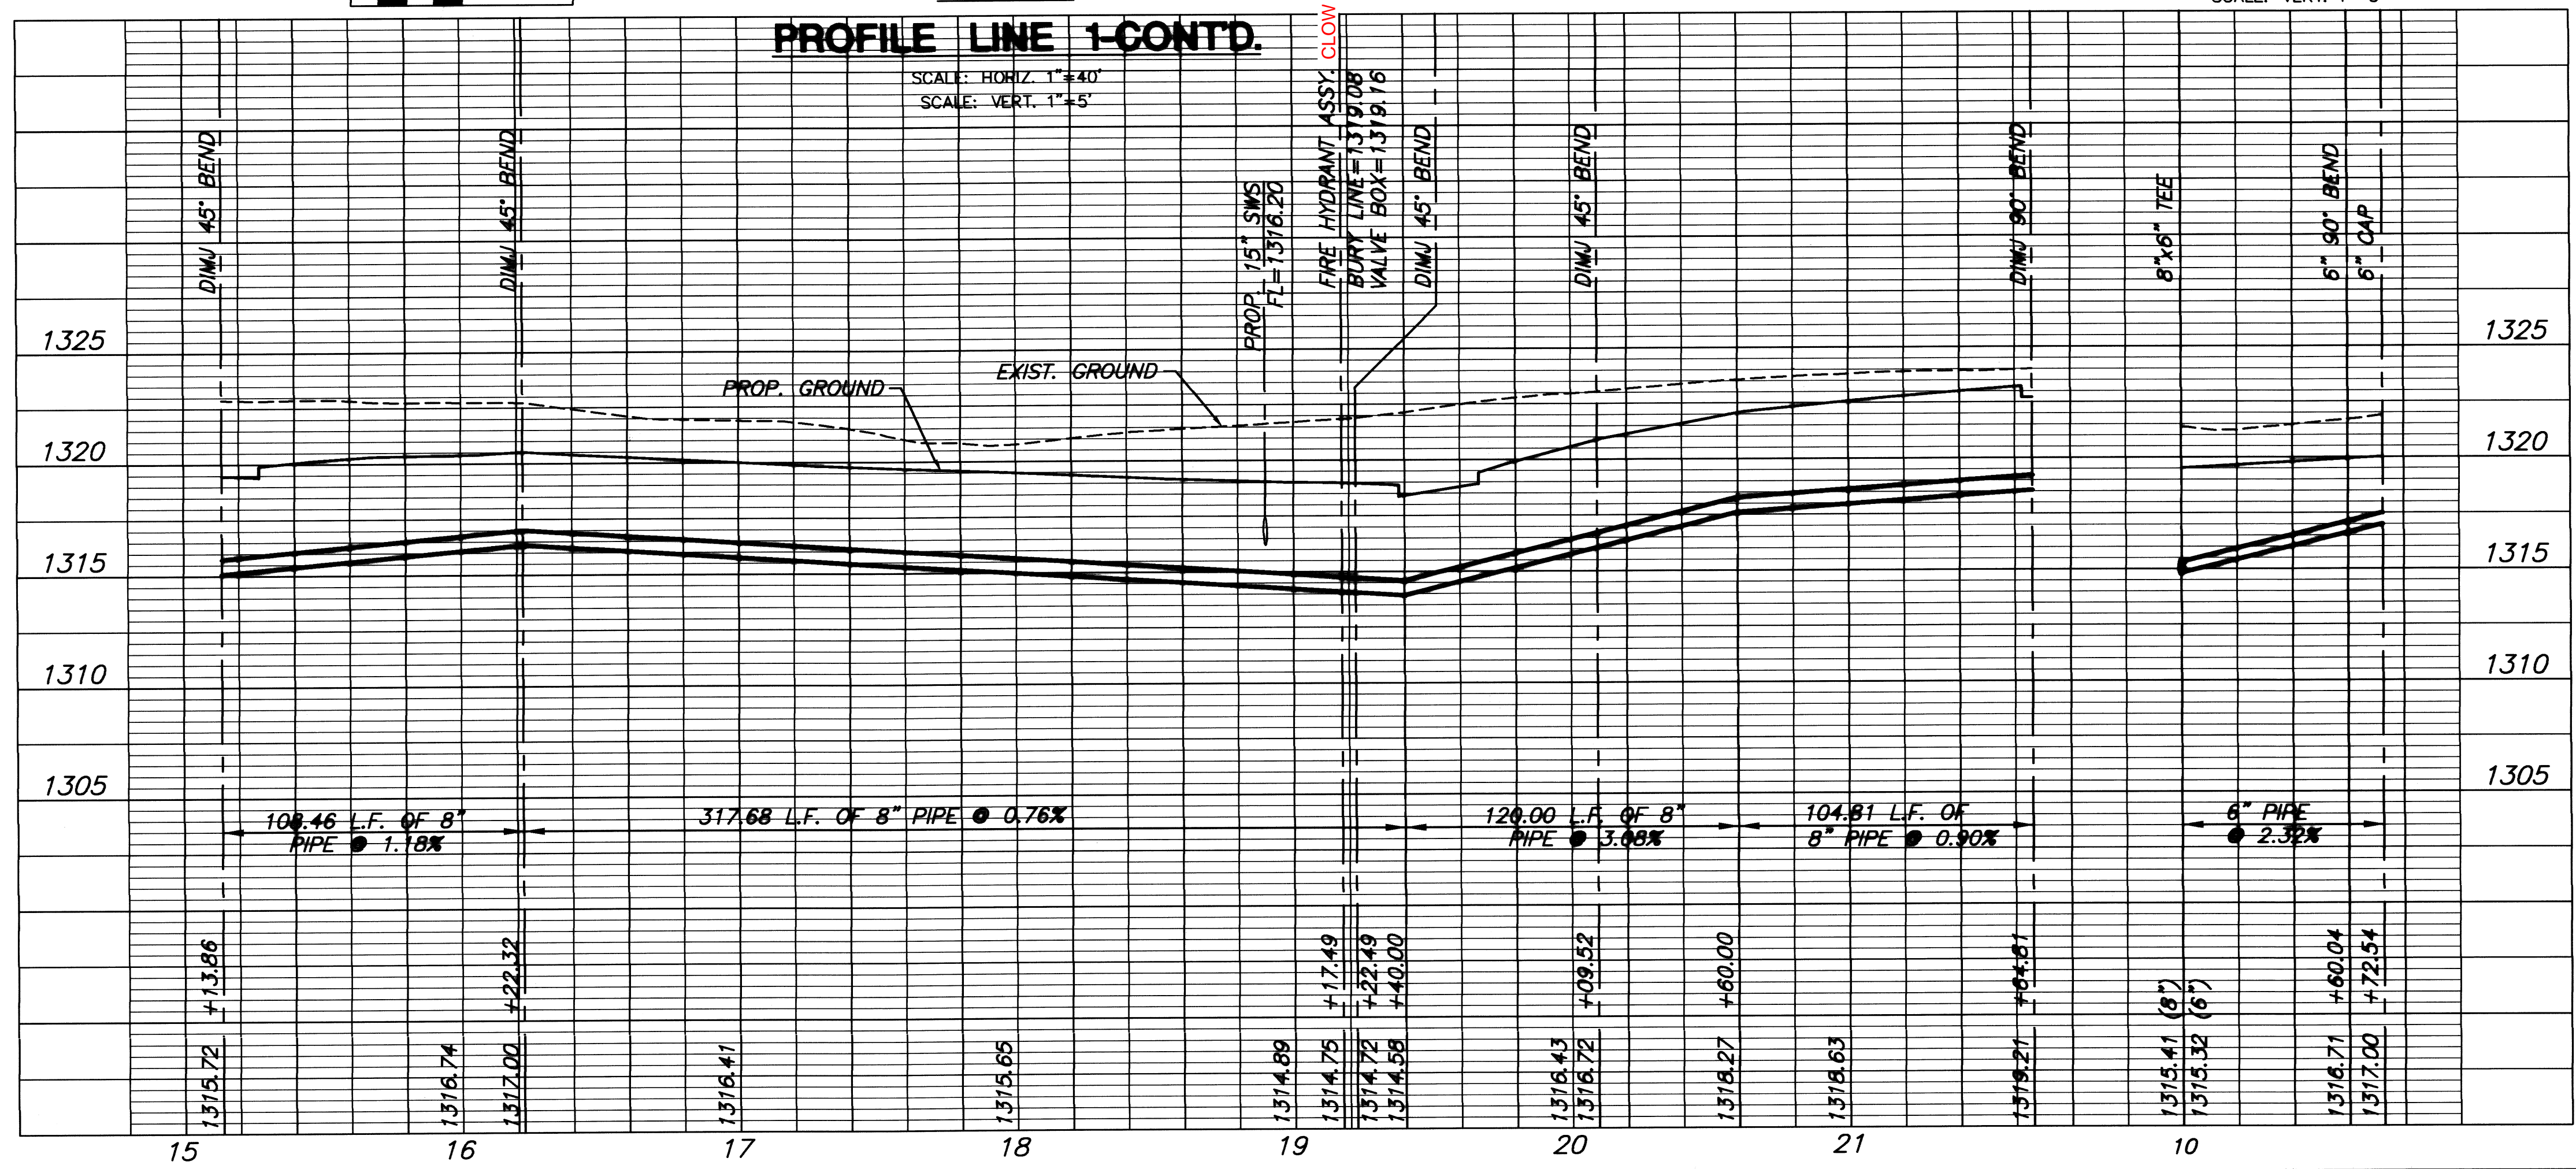

PROFILE LINE 1-CONTD.
SCALE: HORIZ. 1"=40'
SCALE: VERT. 1"=5'

**WATER LINE VALVES TO BE
OPERATED BY CONTRACTOR ONLY
IF WATER INSPECTOR IS ON SITE**

PLOTTED: Friday, March 23, 2007 @ 11:12AM

J:\Civil\05103\Draw\Design\Draw_385\wt_06771_c2.dwg