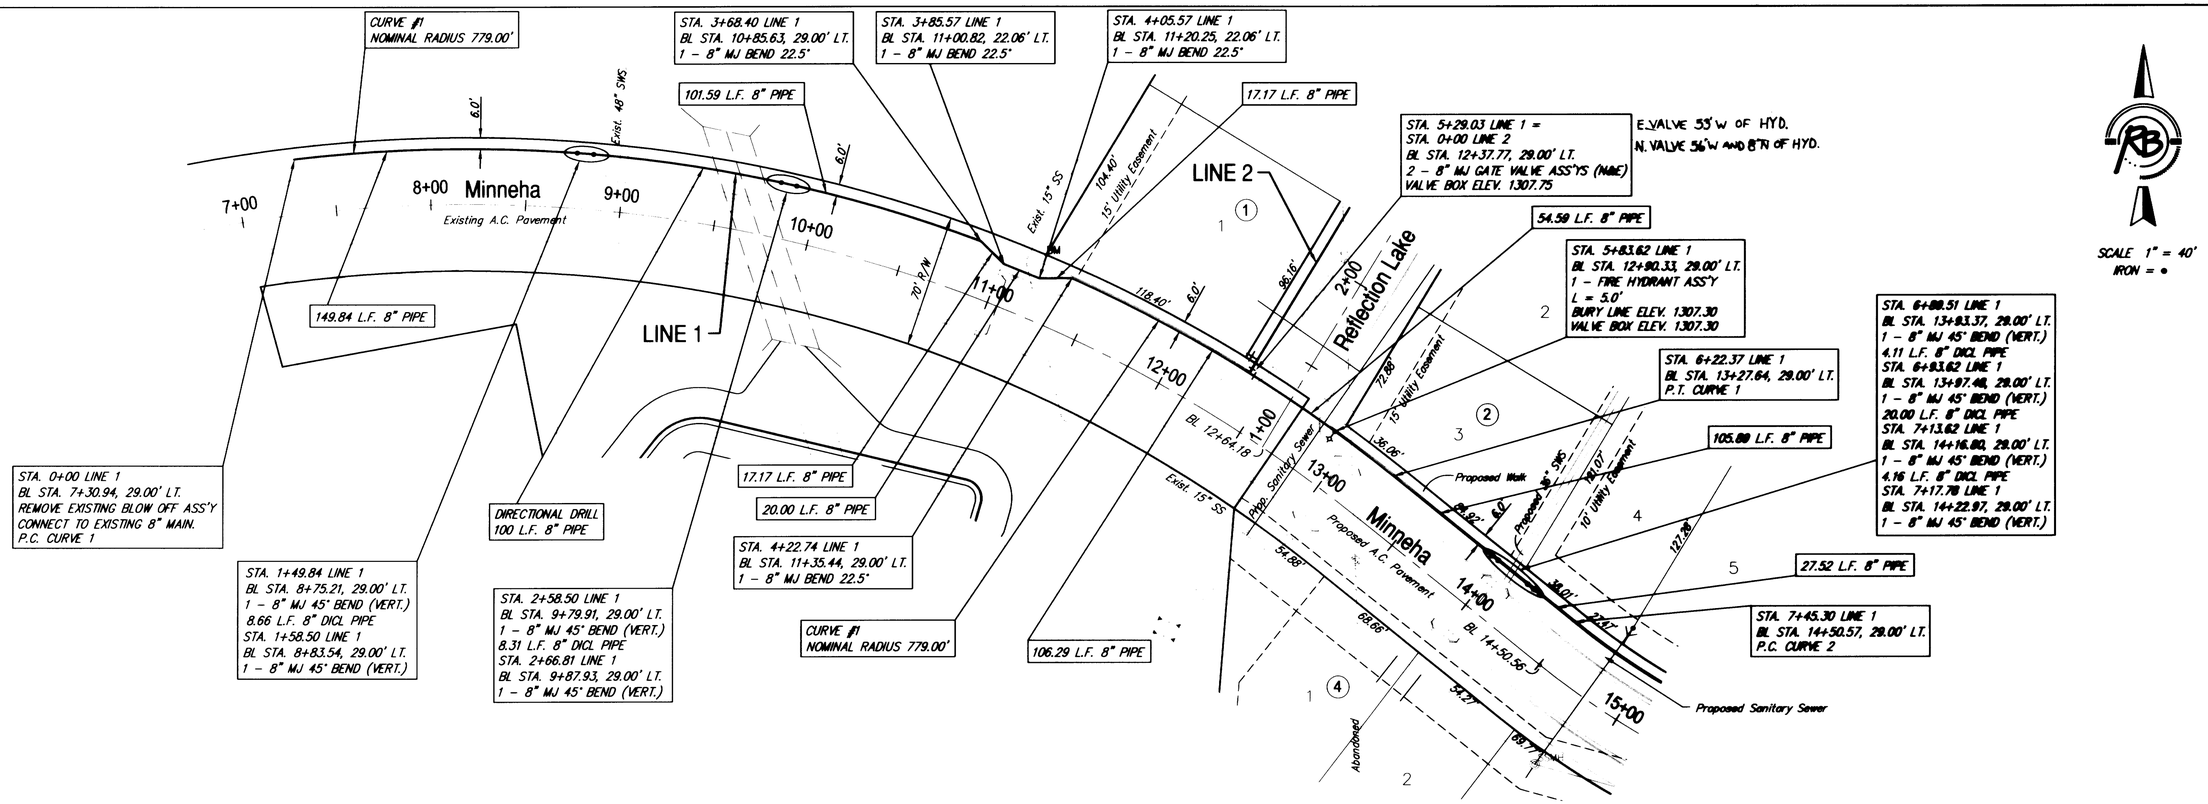

Reflection Lake at Cloud City 2nd Add.
WATER LINE 1
ANDOVER, KANSAS

DESIGN KWL | DRAWN RA | REVISED
UTILITY | DATE Dec. 3, 2004 | REVIEW

PROJECT NUMBER
DRAWING FILE water {LINE 1}

Ruggles & Bohm, P.A.
Engineering, Surveying, Land Planning
924 North Main
Wichita, Kansas 67203
www.rbkansas.com
(316) 264-8008
(316) 264-4621 fax
E-mail: info@rbkansas.com

RB JOB 2566E
SHEET 2 of 8