


SCALE 1" = 40'
IRON = ●

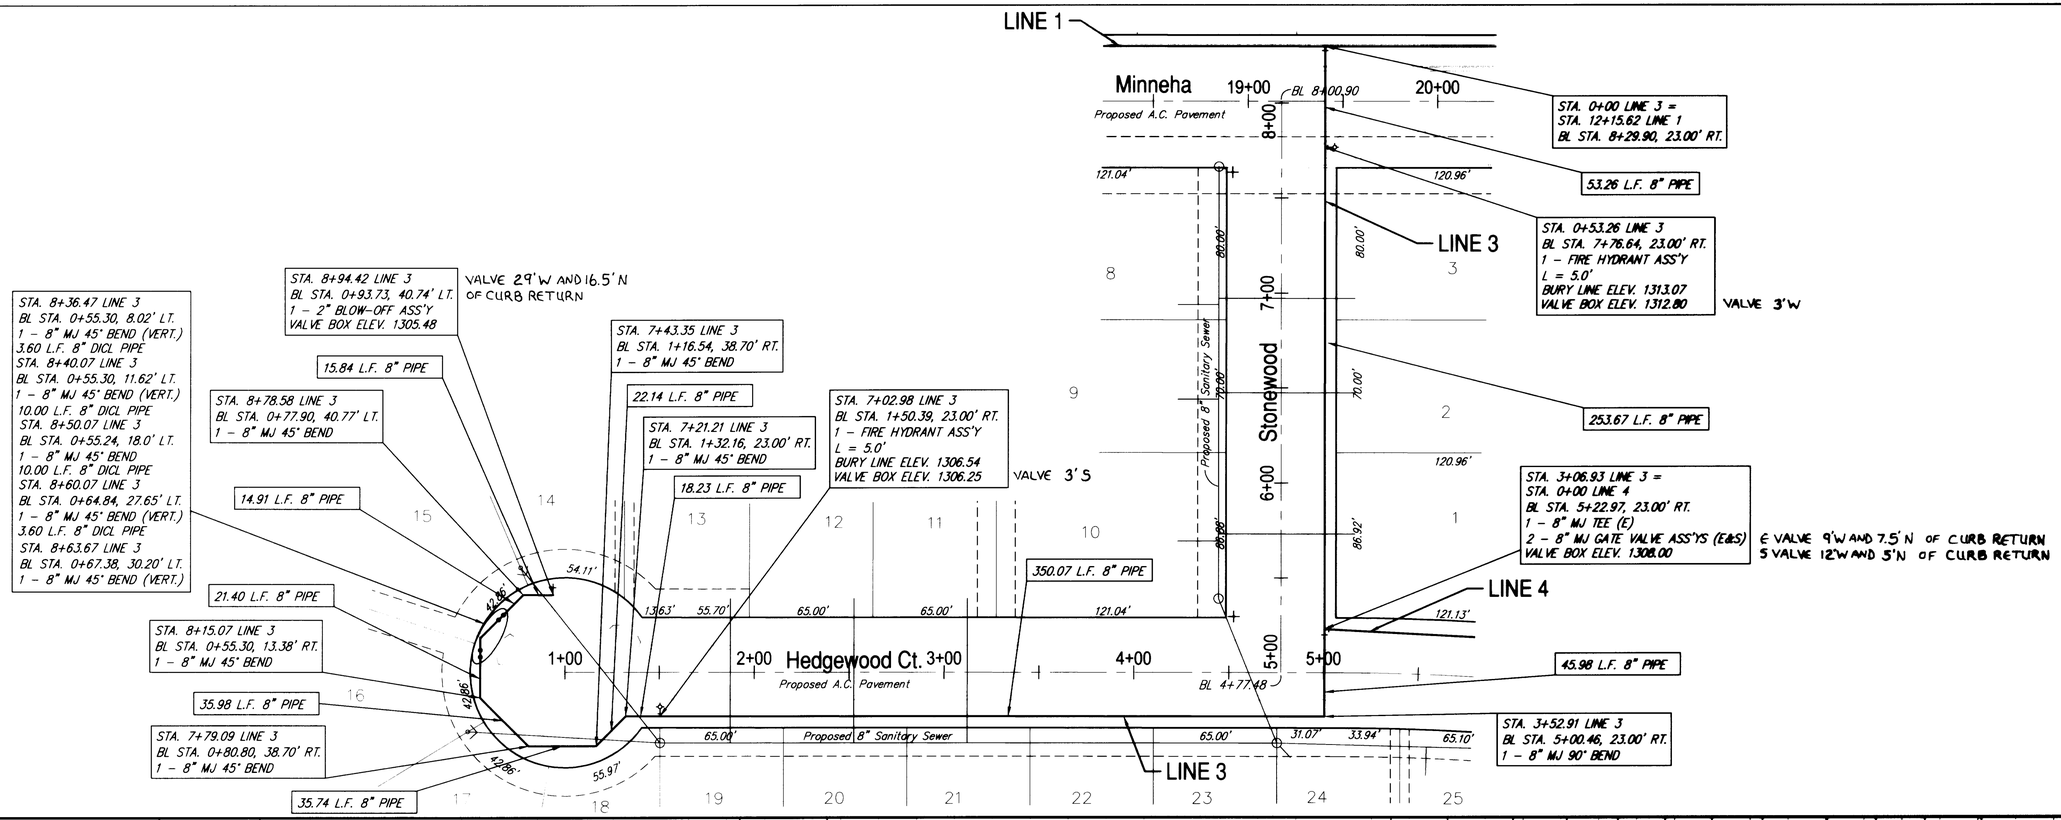


"AS BUILT"
11-13-08
JOM

Reflection Lake at Cloud City 2nd Add.
WATER LINE 3
ANDOVER, KANSAS

| DESIGN | DRAWN | REVISED |
|---|---|---|
| KML | RA | |
| UTILITY | DATE | REVIEW |
| | Dec. 3, 2004 | |

PROJECT NUMBER

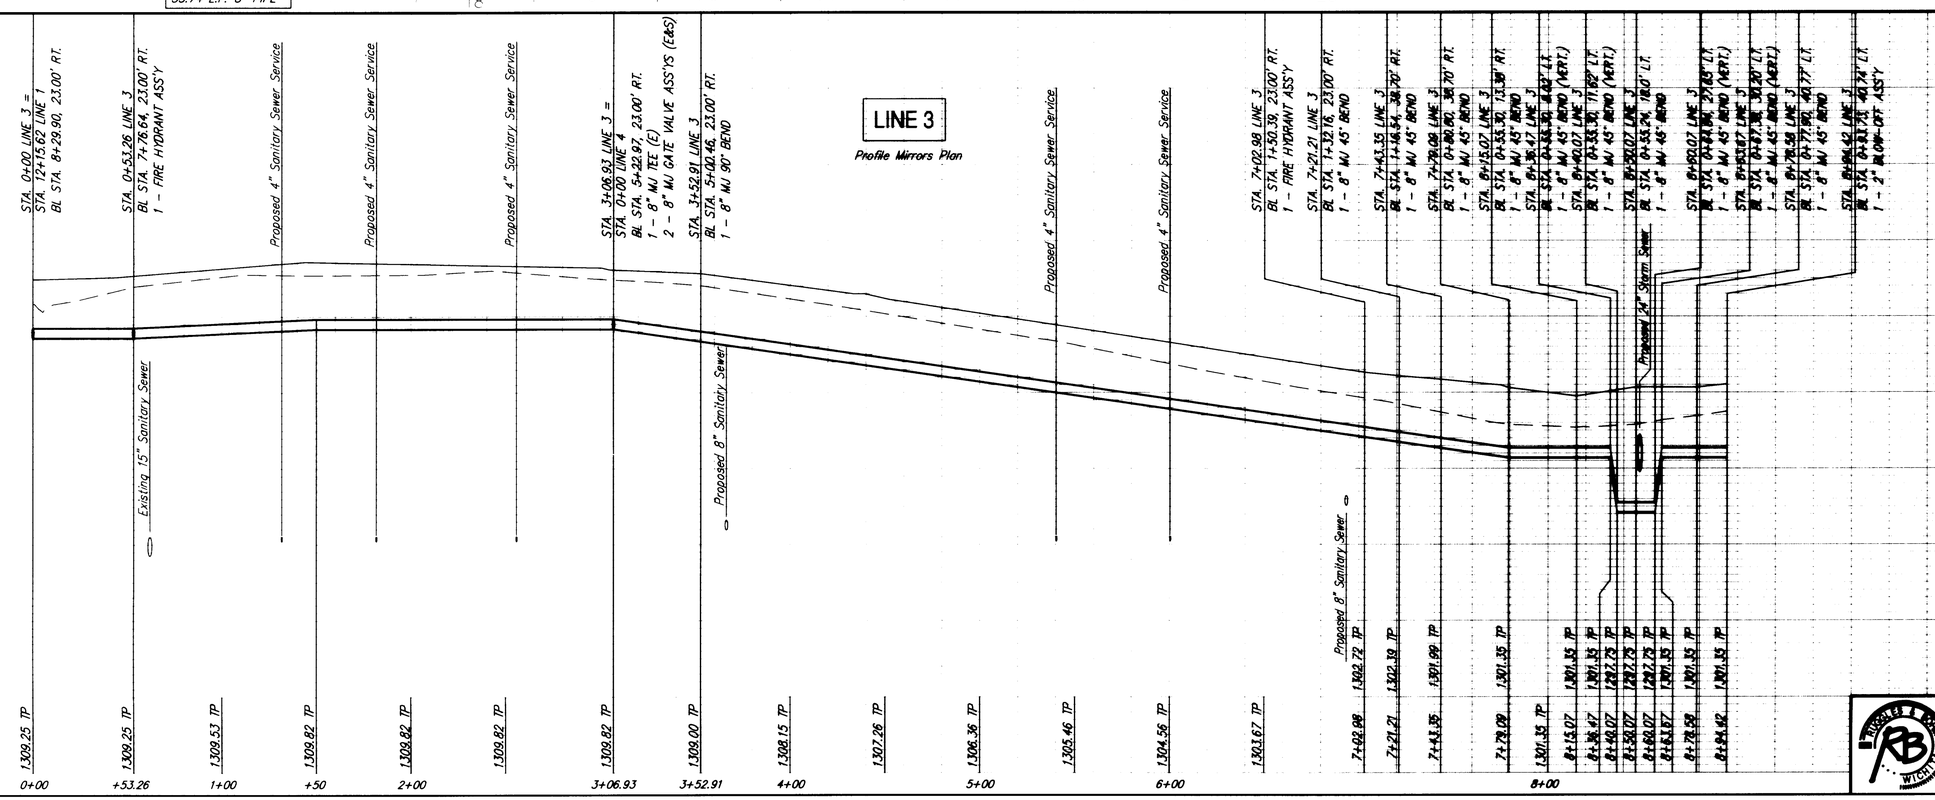DRAWING FILE
water (LINE 3)


Ruggles & Bohm, P.A.
Engineering, Surveying, Land Planning
924 North Main
Wichita, Kansas 67203
www.rbkansas.com
(316) 264-8006
(316) 264-4621 fax
E-mail: info@rbkansas.com


RB JOB 2598E

SHEET 8 of 5