


Subdivision Bench Marks

No.	Street and Station	From CL	Description	Elevation
4	Tara Falls Ct., Sta. 4+66.23	14.0' Rt.	Top of Curb at the common lot lines of Lots 12 & 13, Block 1, Casa Bella Add.	

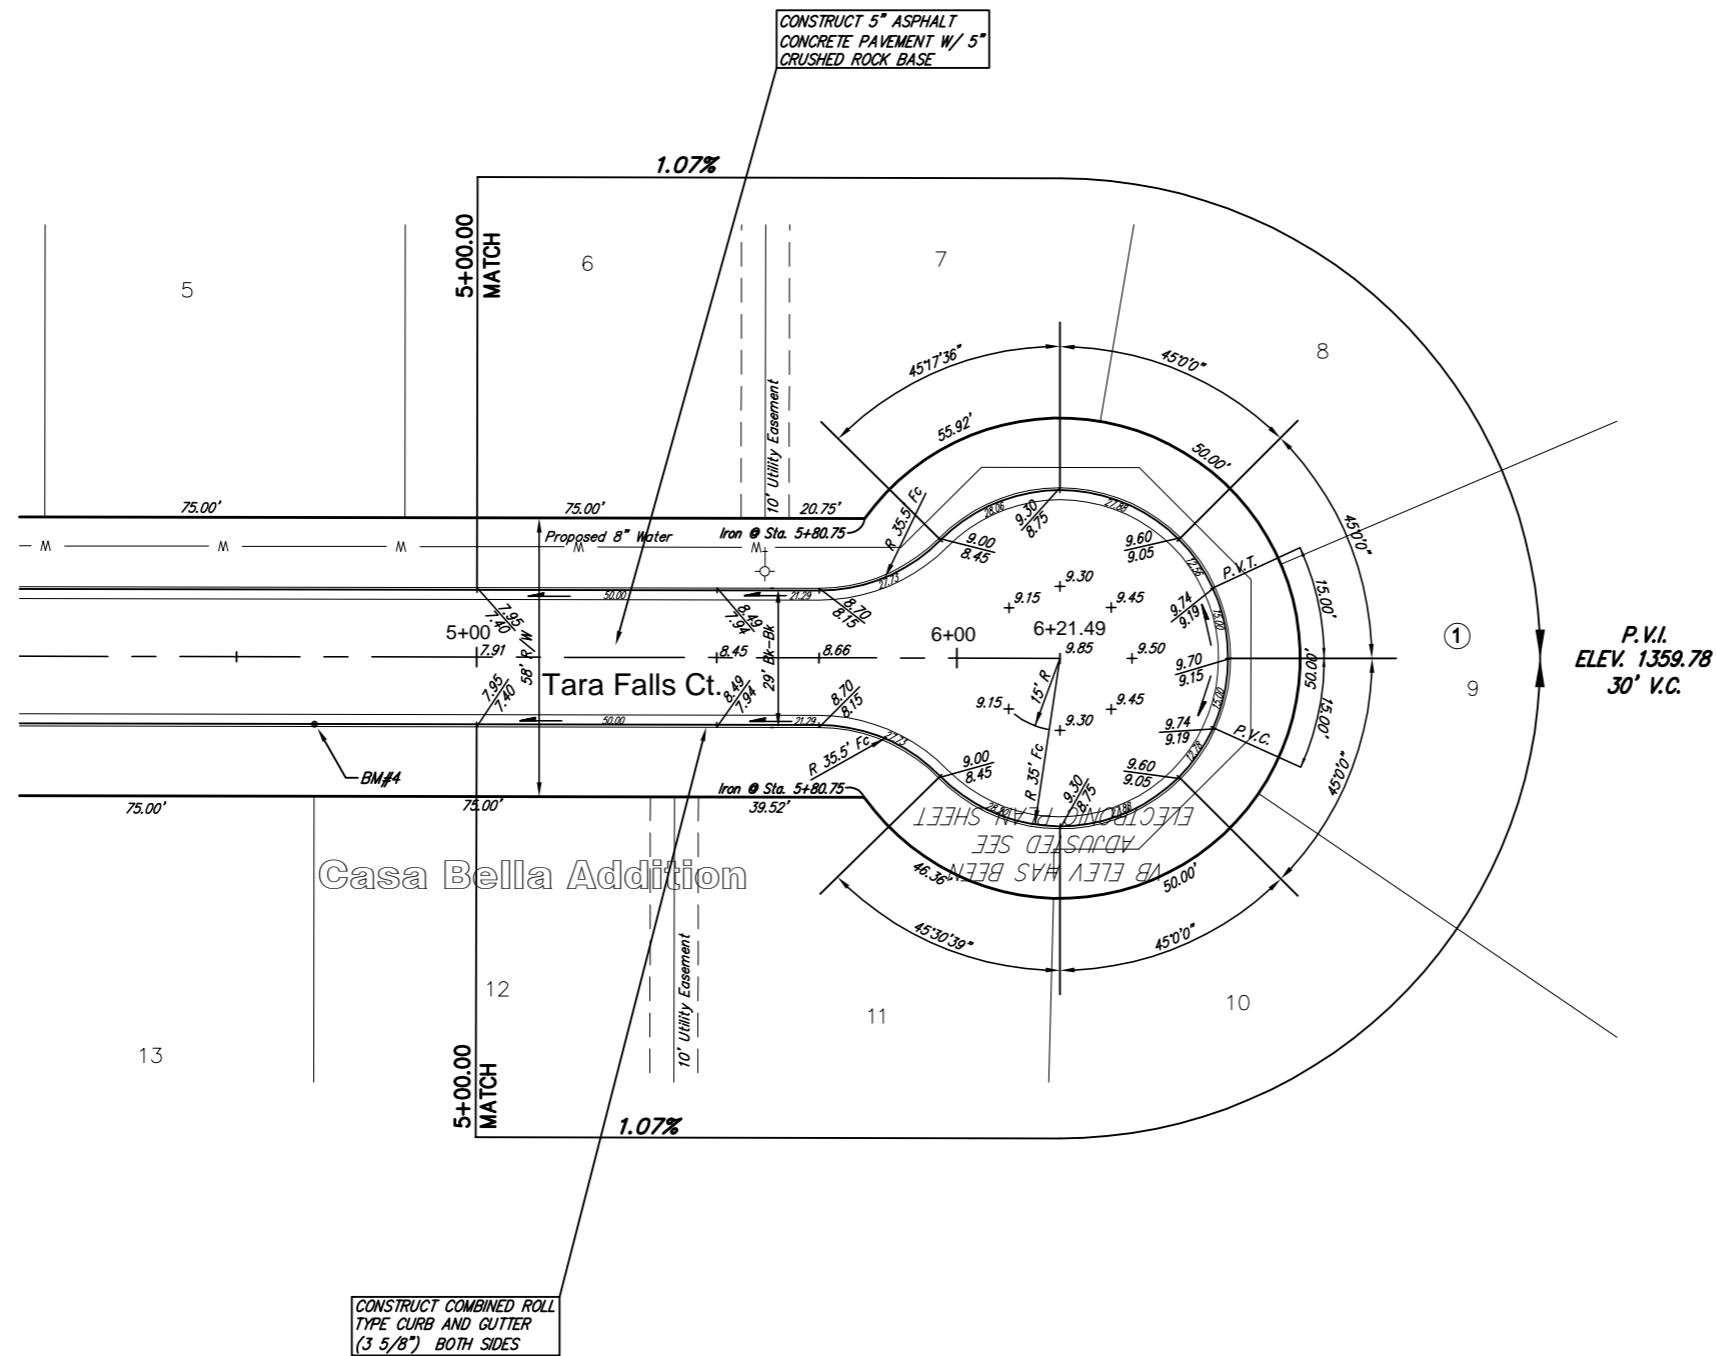

P.V.I.
ELEV. 1359.78
30' V.C.



SCALE 1" = 20'
IRON = •

NOTE: ROLL TYPE CURB AND GUTTER TO BE CONSTRUCTED ALONG PAVEMENT DEPICTED ON THIS SHEET

Cheryl's Hollow Addition, Paving Improvements Stout Court WICHITA, KANSAS			
	Ruggles & Bohm, P.A. Engineering, Surveying, Land Planning		DESIGN KWL
	924 North Main Wichita, Kansas 67203 www.rbkansas.com		(316) 264-8008 (316) 264-4621 fax E-mail: info@rbkansas.com
DRAWING FILE paving {Tara Falls Ct 2}	PROJECT NUMBER 472-84271	DATE Nov., 16, 2005	SHEET 10 OF 24