



PLAN LINE 1



NOTE:
CONTRACTOR TO VERIFY SIZE AND
DEPTH OF THE EXISTING UTILITIES
PRIOR TO CONSTRUCTION.

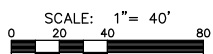


NOTE:
FRONT YARD SANITARY SEWER SHALL
BE SAND BACKFILLED & FLUSHED.
STA. 12+72.8 TO STA. 13+59.3, LINE 1.

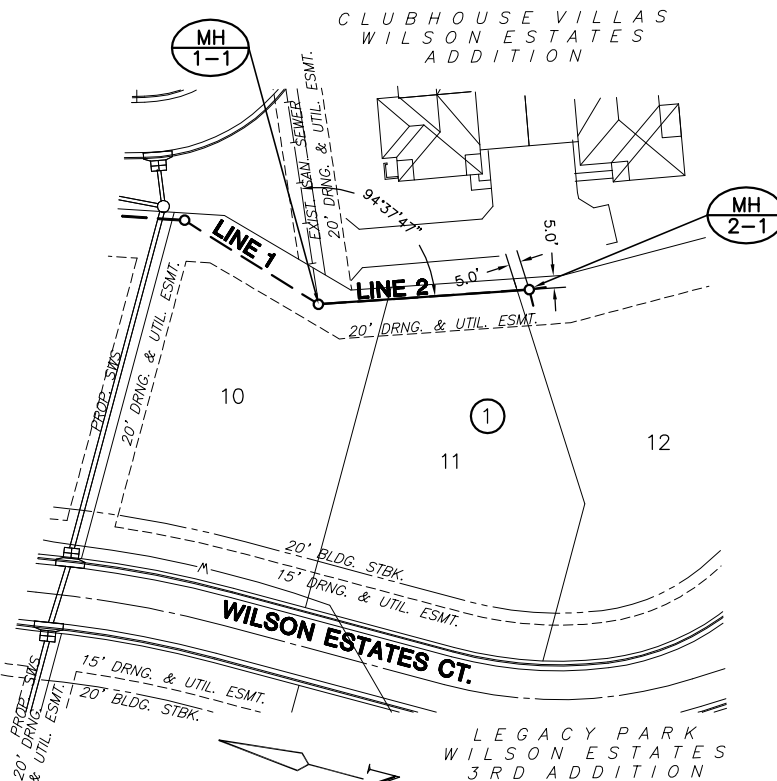

PLAN LINE 2

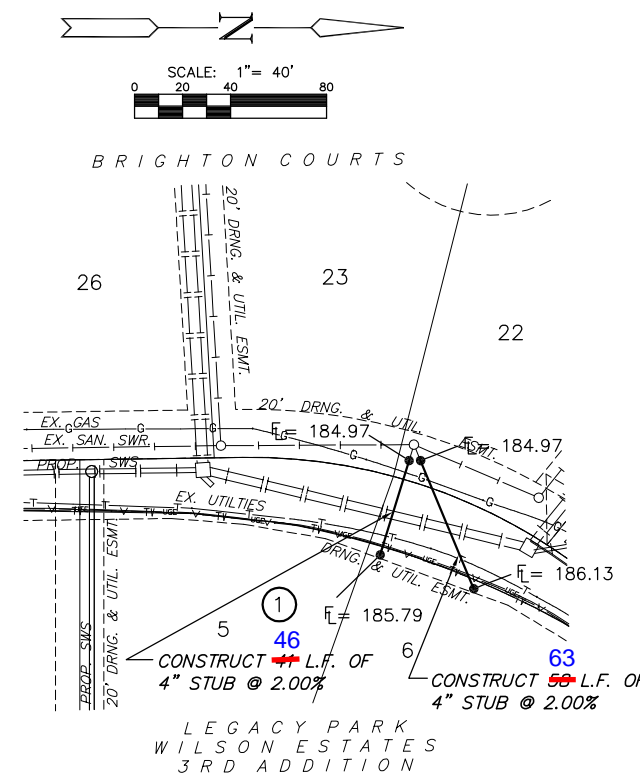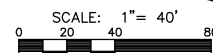

PLAN FOR LOTS 5 & 6 SEWER STUBS

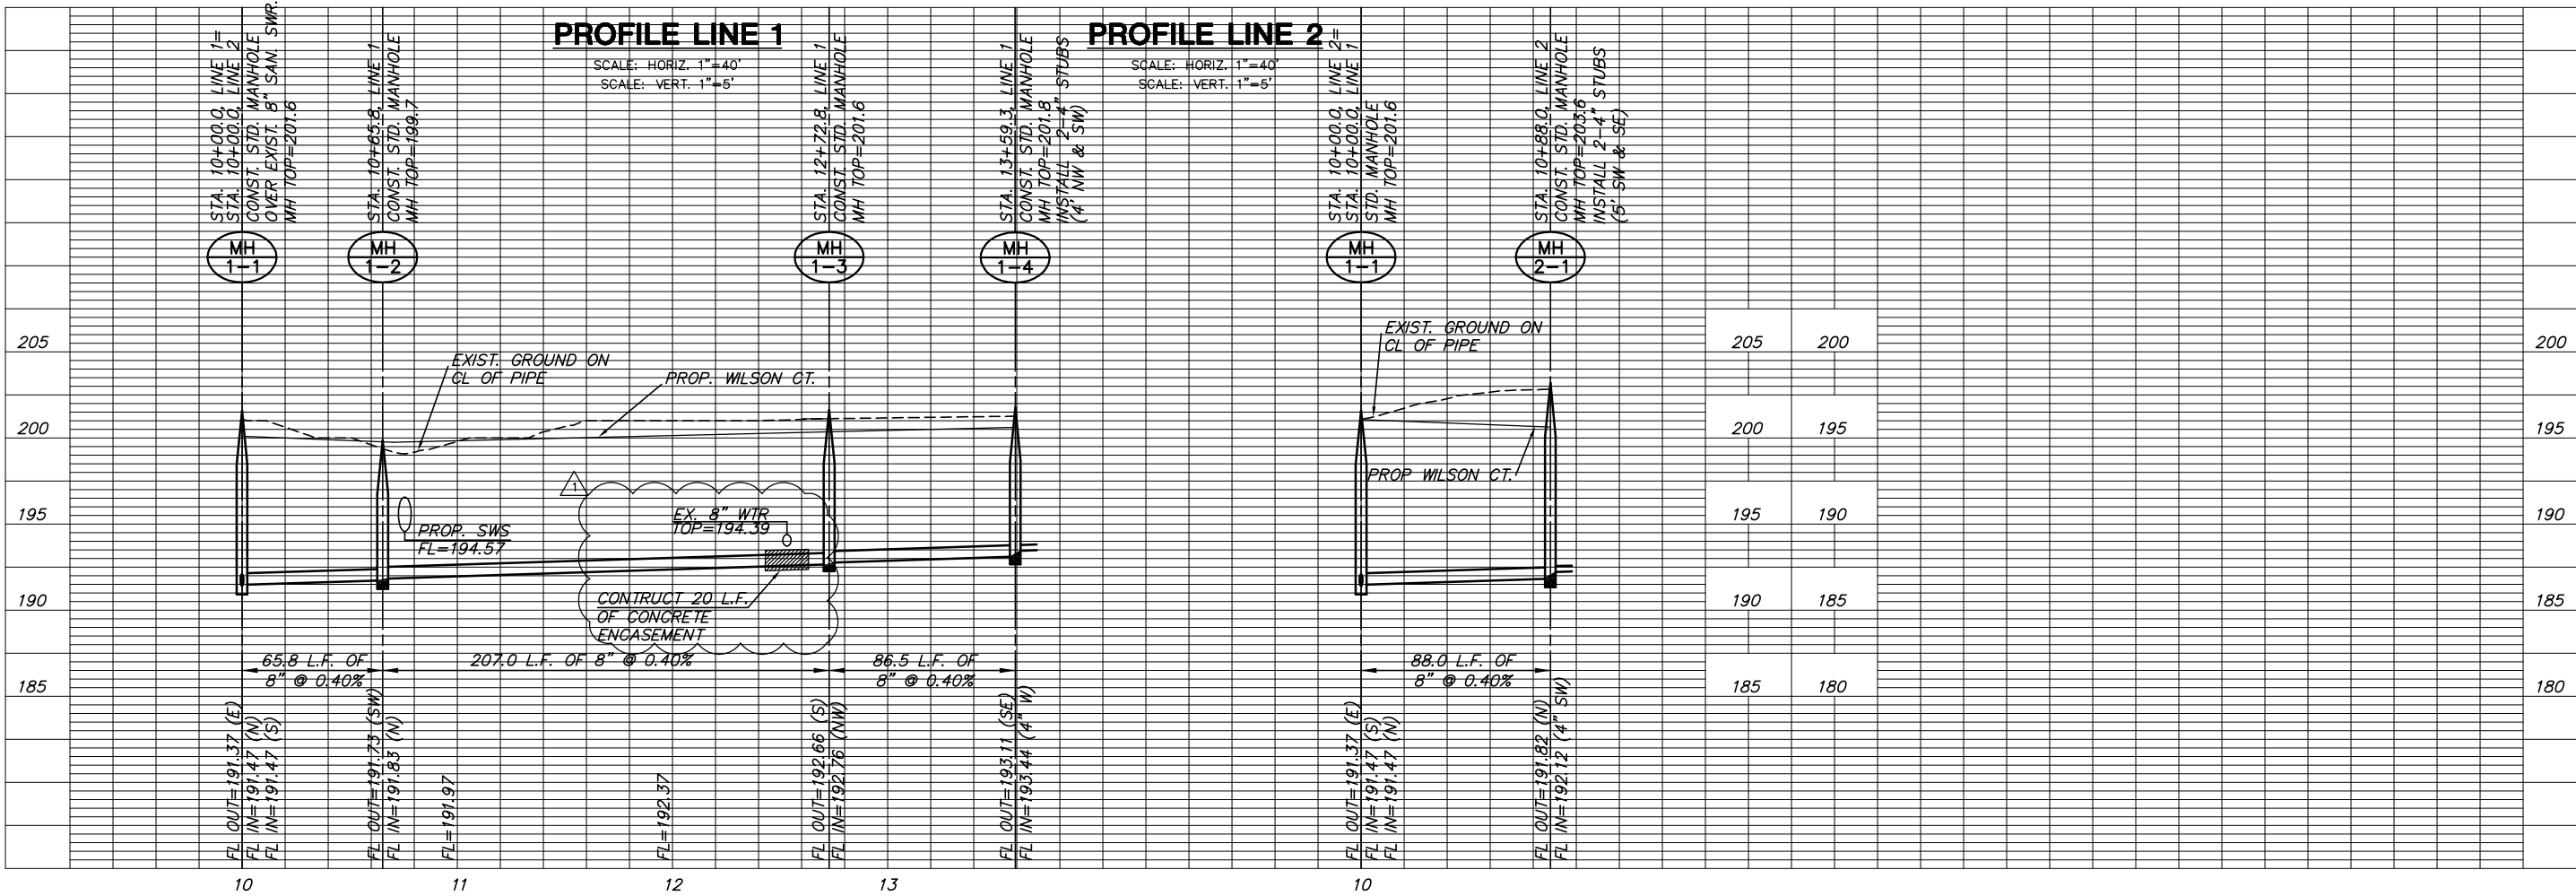

PROFILE LINE 1

PROFILE LINE 2

**PUBLIC IMPROVEMENT PLANS FOR
LEGACY PARK
WILSON ESTATES 3RD ADD.
WICHITA, KANSAS**

LINE 1, 2, & 3

SHEET TITLE
PROJECT NUMBER
05753

DESIGN BY
SRS
DRAWN BY
KWS
CHECKED BY
GLA

ISSUED
JUNE 2006
REVISED
7/27/06
COW COMMENTS

SHEET NO.
5 of 25