


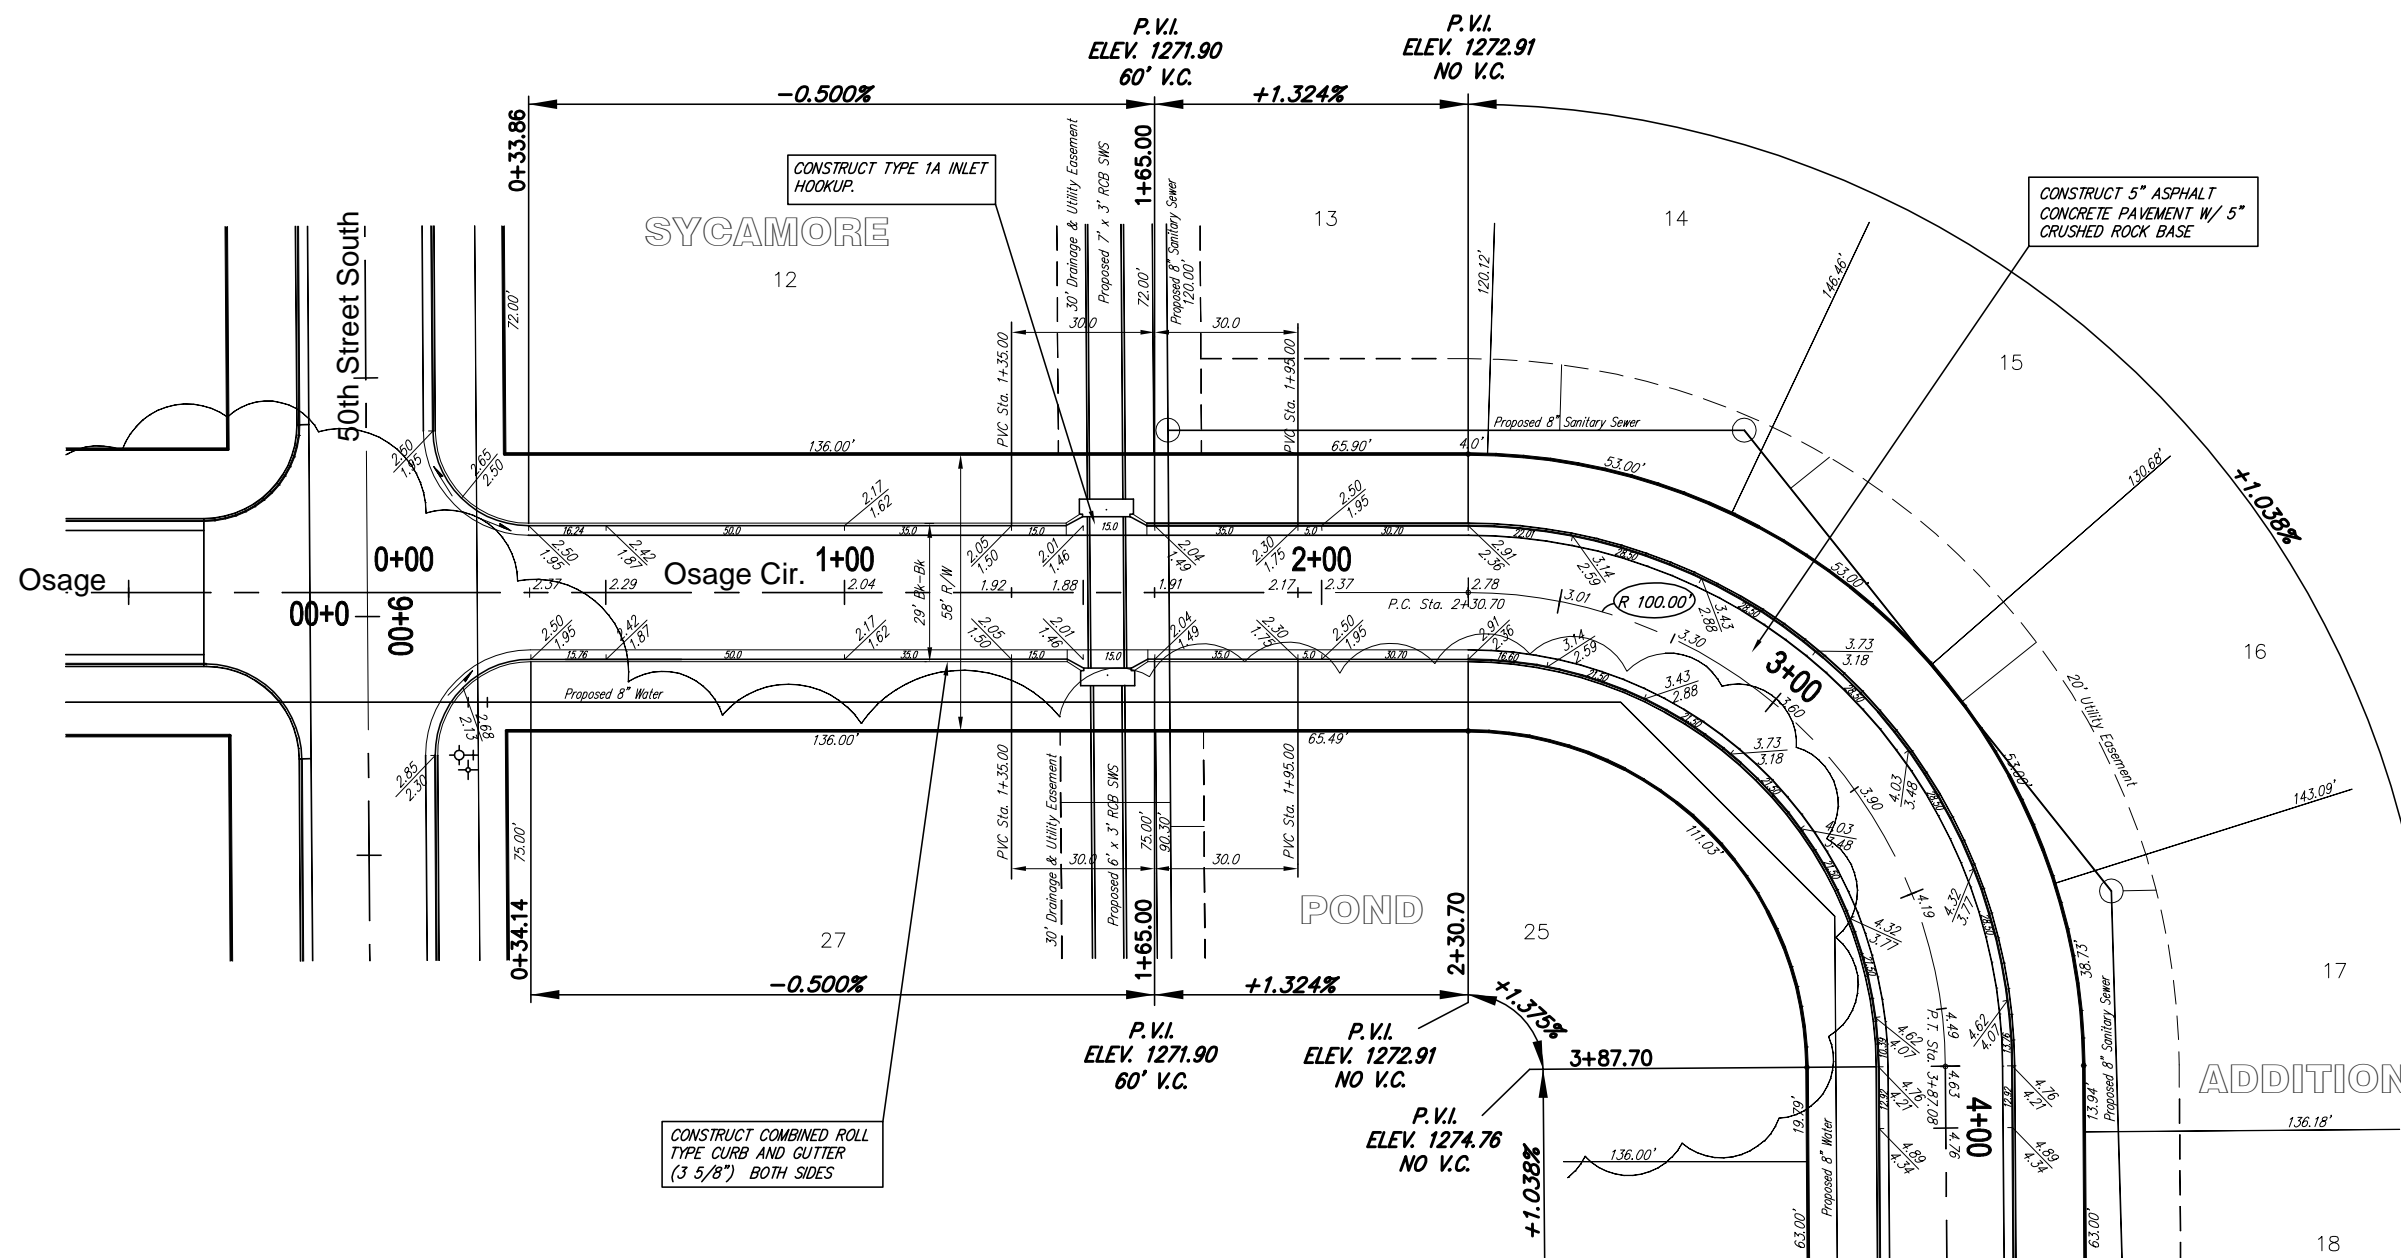

SCALE 1" = 20'
IRON = •



NOTE: ROLL TYPE CURB AND GUTTER TO BE CONSTRUCTED ALONG PAVEMENT DEPICTED ON THIS SHEET

Sycamore Pond Addition, Paving Improvements
Osage Circle
WICHITA, KANSAS

 Rugles & Bohm, P.A. Engineering, Surveying, Land Planning	924 North Main Wichita, Kansas 67203 www.rbkansas.com	(316) 264-8008 (316) 264-4621 fax E-mail: info@rbkansas.com	DESIGN EJG DRAWN RA REVIEW UTILITY DATE Sept. 20, 2006	SHEET 7 OF 16
	DRAWING FILE paving {Osage Cir - 1}	PROJECT NUMBER 472-84416		