CONSTRUCTION PLANS FOR

WATERLINE IMPROVEMENTS

FOR

HAYSVILLE EMERGENCY WATERLINE

THE CITY OF HAYSVILLE

PEC PROJECT NO. 34-95676-1263

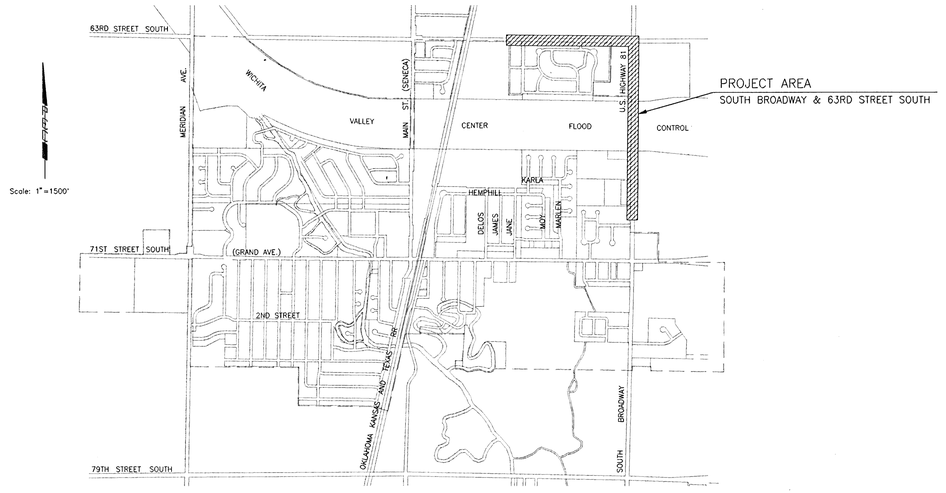

LOCATION MAP

PUBLIC OFFICIALS

MAYOR	TOM LINDSAY
CITY COUNCIL	SANDRA BRADSHAW
	DOROTHY BOOHER
	MICHAEL MORRISON, SR.
	BRUCE ARMSTRONG
	PHIL HARRIS
	WENDELL CORBETT
	LARRY EMERSON
	TIM NORTON
CITY CLERK	CAROL McBEATH

INDEX OF SHEETS

SHEET NO. 1	TITLE SHEET
SHEET NO. 2	KEY MAP
SHEET NO. 3	MISCELLANEOUS DETAILS
SHEET NO. 4-13	WATERLINE PLAN/PROFILE
SHEET NO. 14-15	BRIDGE ATTACHMENT DETAILS

OCTOBER 1995

PLANS PREPARED BY

PROFESSIONAL ENGINEERING CONSULTANTS, P.A.

ENGINEERS

WICHITA, KANSAS

RECORD DRAWING

PROJ. ENG. 1/14/97 DATE

RES. ENG. DATE

DSNR: REJ OPER: JLM SCALE: 1=1.00
Q:\1995\95676\TITLE.DWG 10-24-1995 9:00:01 am

2D