


ELEVATION
(Bridge Rail not shown for clarity)

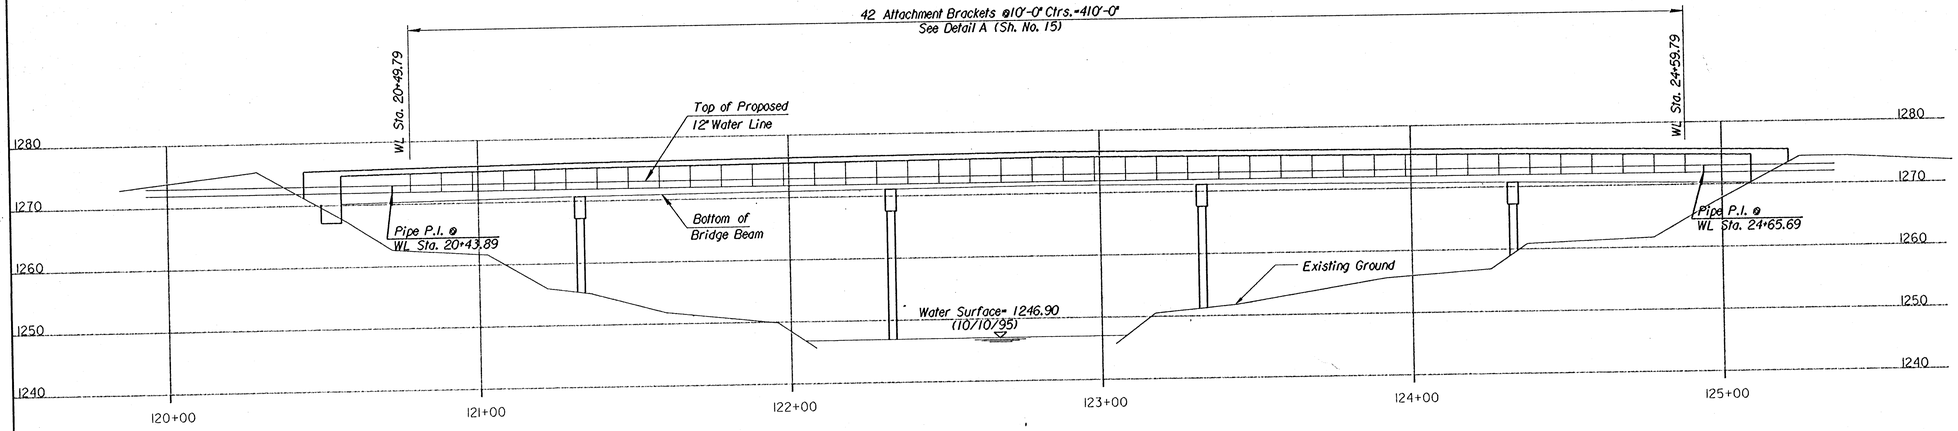


PLAN

RECORD DRAWING
MDK PROJ. ENG. 1/14/97 DATE
RES. ENG. DATE

CITY OF HAYSVILLE
SEDGWICK COUNTY, KANSAS
CONSTRUCTION LAYOUT
OVER WICHITA VALLEY CENTER FLOODWAY
HAYSVILLE EMERGENCY WATERLINE
WATERLINE IMPROVEMENTS

PROFESSIONAL ENGINEERING CONSULTANTS, P.A.
WICHITA, KANSAS

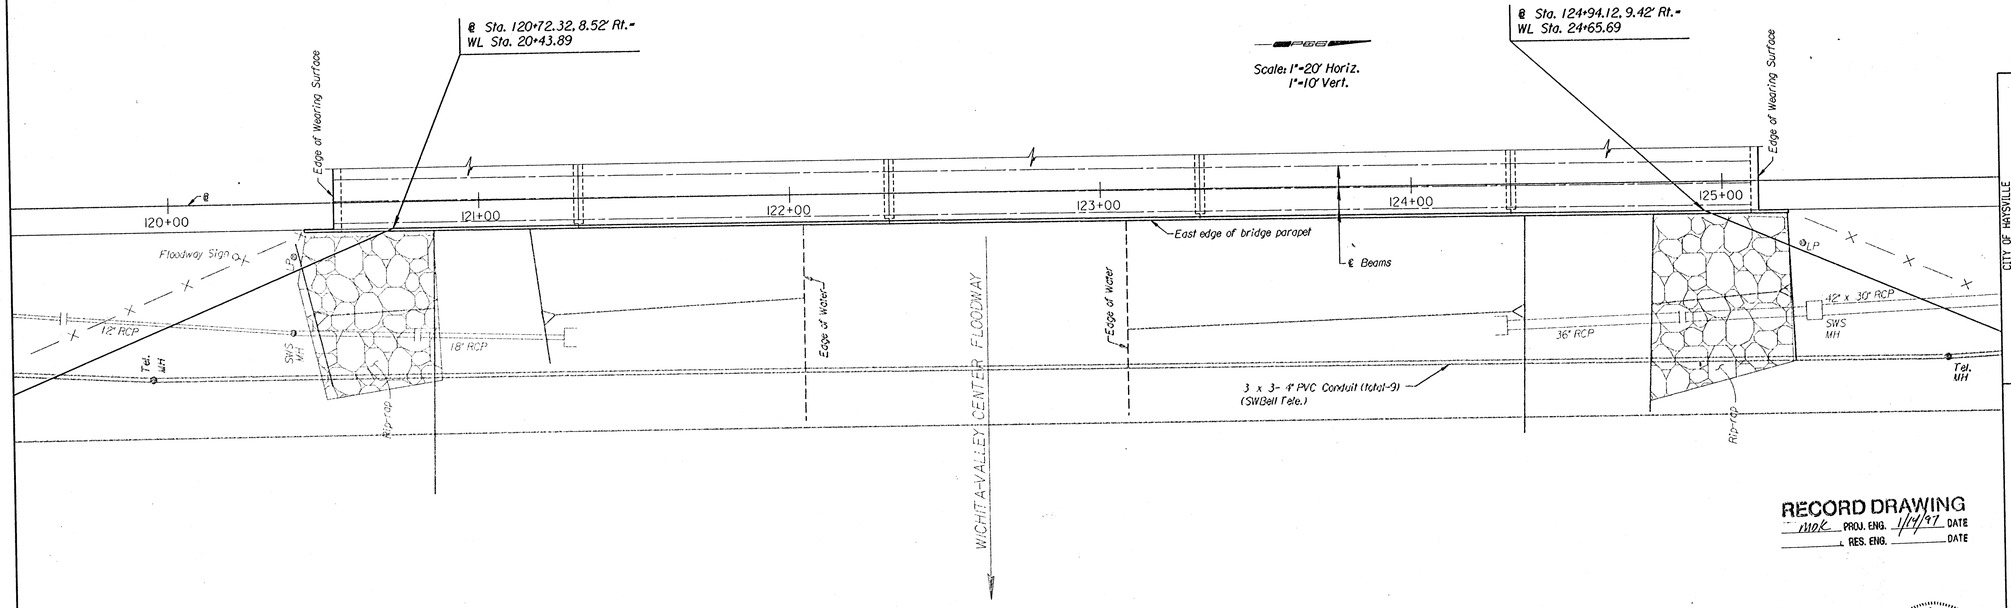Job No. 32-95676
Date October 1995
Designed By RAS
Drawn By MAF
Sheet 14 of 15

RICHARD A. SCHLITT
LICENSED
8054
KANSAS
PROFESSIONAL ENGINEER
10/24/95

i:/1995/95676/ppbase.dgn
drawn by: maf
plotted by: ras 10-23-95
deliver to: ras