HORIZONTAL CONTROL POINTS		
C.P. NO. 1	N 4830.80 E 4930.00	NW CORNER OF LOT 1 ANGELS WEBB ROAD ADDITION, #4 BAUGHMAN REBAR FOUND
C.P. NO. 2	N 4841.34 E 5400.80	NE CORNER OF LOT 1 ANGELS WEBB ROAD ADDITION, #4 BAUGHMAN REBAR FOUND
C.P. NO. 3	N 4281.13 E 5111.80	SW CORNER OF LOT 1 ANGELS WEBB ROAD ADDITION, #4 BAUGHMAN REBAR FOUND

ONE CALL
KANSAS
KS: 1-800-344-7233
WICHITA: 316-687-2470

GRAPHIC SCALE IN FEET
20' 0 20'

LEGEND

- ● = #4 Baughman Rebar Found
- ○ = 3/4" Iron Pipe Found
- ⊡ = 1/2" Iron Pipe Found
- × = Chiseled Cross Found
- △ = #6 Rebar Found
- Ø = #4 Baughman Rebar Set
- FH = Fire Hydrant
- SSMH = Sanitary Sewer Manhole
- SWSMH = Stormwater Sewer Manhole
- T = Tree
- WM = Water Meter

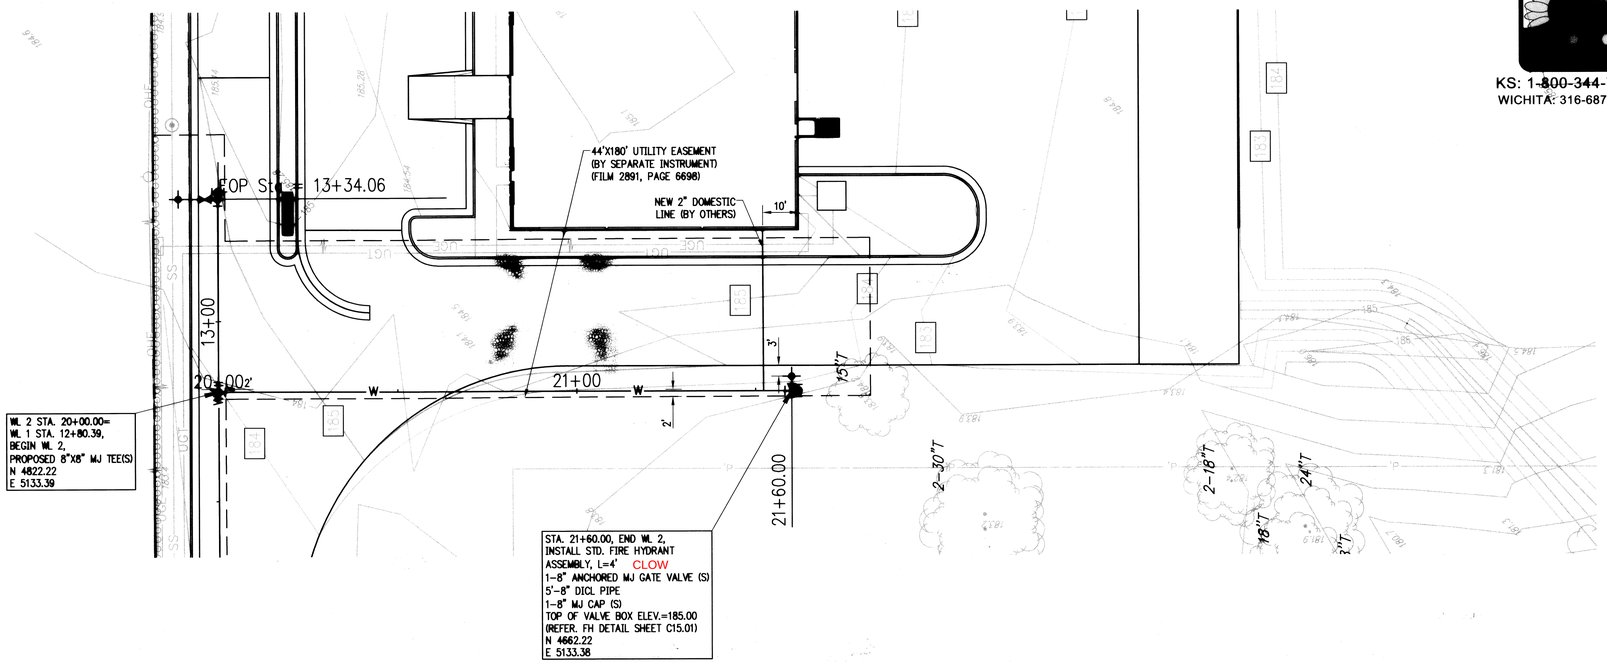

UNLESS OTHERWISE SHOWN,
ELEVATIONS ARE TO TOP OF PIPE.

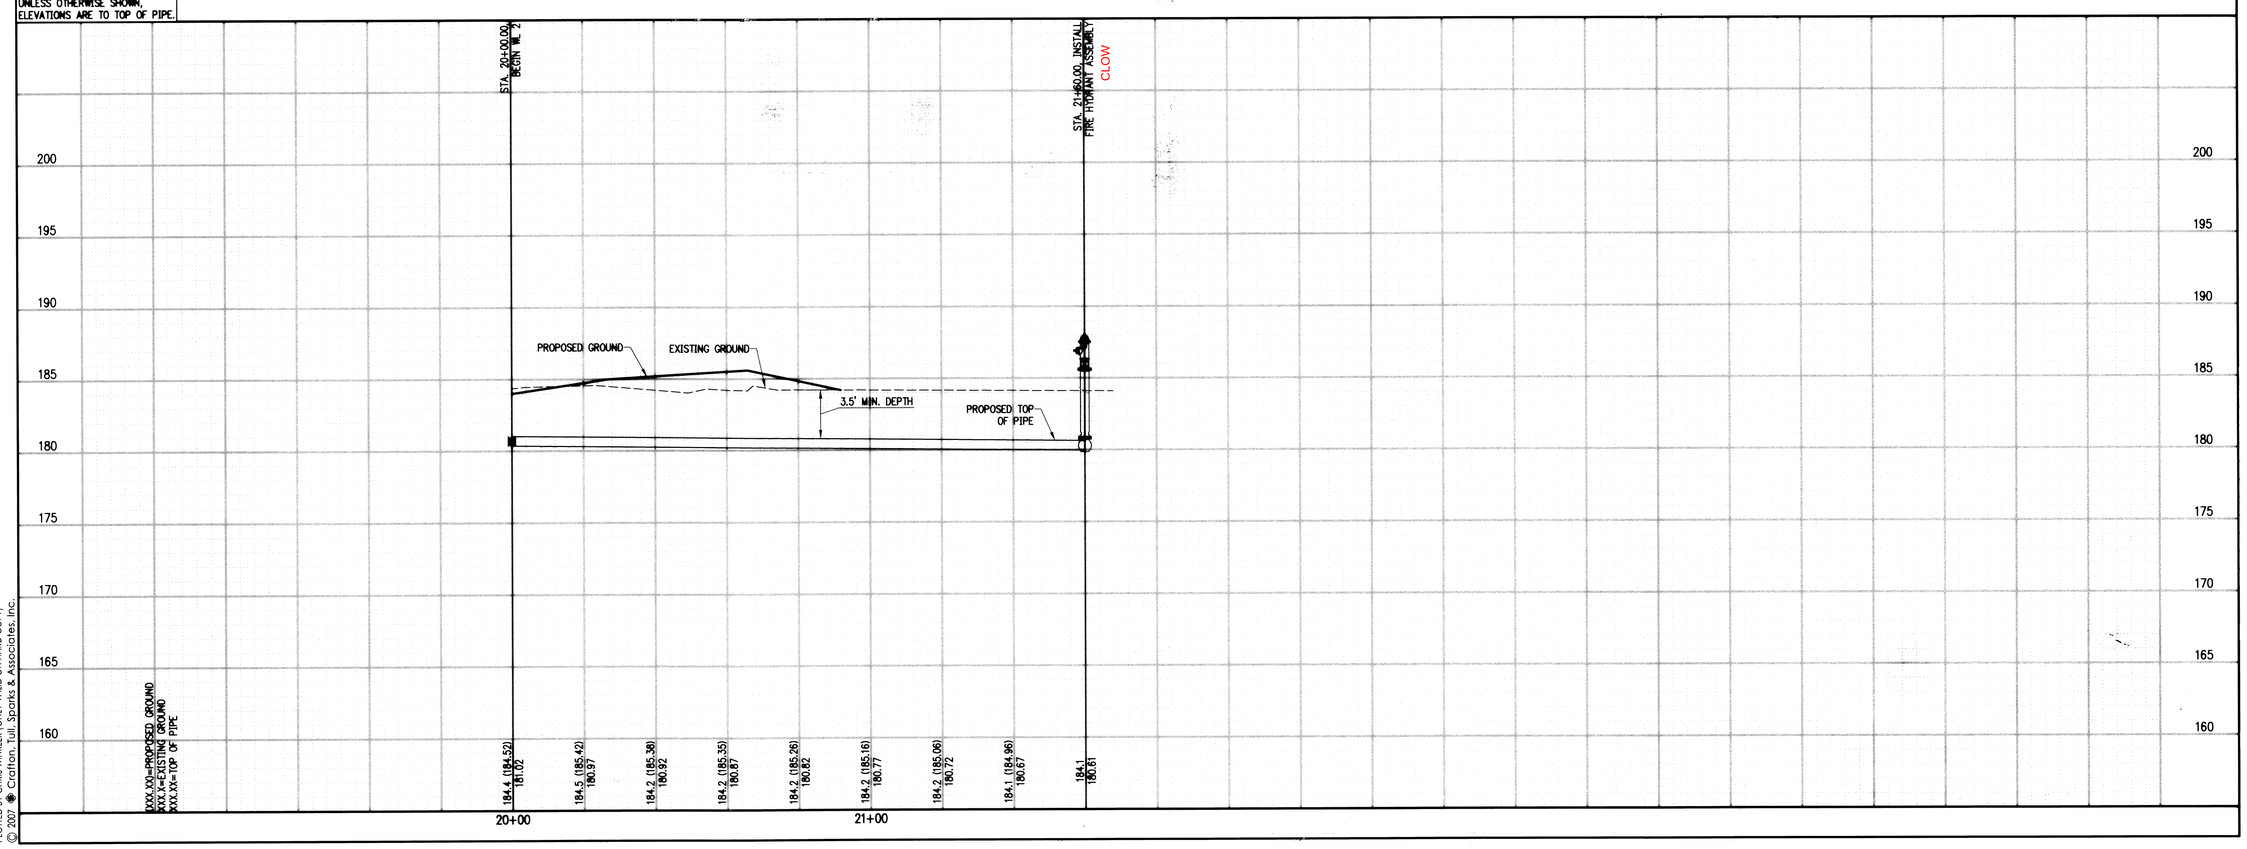

Crafton Tull Sparks
8200 E. 34th Street North, Bldg. 1600
Suite 1,603, Wichita, KS 67226
316.634.6776 FAX: 316.634.6777
www.craftontullsparks.com
architecture | engineering

WEBB ROAD BUSINESS PARK
ORME STREET & WILDCAT LANE
WICHITA, KANSAS
ISSUED FOR CONSTRUCTION

Revisions

WATERLINE 2 P&P

Drawn by	Job Number
CKW	073006-00
Checked by	Contact Person
	J. MOHLER
Date	Sheet Number
08/17/07	C12.02

DRAWING FILE NAME AND LOCATION: G:\073006-00\ENG\DWG\wls&p.dwg, LAYOUT TAB: WL P&P (2)
LAST SAVED BY CW3002, 9/13/2007 1:39:07 PM.
PLOTTED BY CHRIS WINKLER (ONLY VALID ON HARD COPY)
© 2007 Crafton, Tull, Sparks & Associates, Inc.