





PT #	NORTHING	EASTING	DESC
1000	22499.1540	10743.2036	IRON
1001	22498.9306	10742.2035	IRON
1002	22498.5658	10713.2145	IRON
1003	22332.1546	10742.7595	IRON
1004	22346.6636	10826.7984	IRON
1005	22201.2008	10836.4190	IRON
1006	22334.2007	10833.2666	IRON
1007	22168.7705	10912.4028	IRON
1008	22139.1463	10847.2928	IRON
1009	21948.8523	10847.8613	IRON
1010	21948.6948	10911.8611	IRON
1011	22022.0396	10766.9809	IRON
1012	21899.5033	10826.4676	IRON
1013	21852.8997	10870.3322	IRON
1014	21866.4573	10601.6836	IRON
1015	21751.2795	10668.9894	IRON
1016	21726.6082	10736.1548	IRON
1017	21717.2076	10745.0030	IRON
1018	21673.3430	10698.3993	IRON
1019	21685.6108	10686.8525	IRON
1020	21668.7868	10622.8826	IRON
1021	21732.7964	10622.6400	IRON
1022	21667.9807	10407.5787	IRON
1023	21731.9802	10407.3361	IRON
1024	21926.5495	10198.3878	IRON
1025	21613.4591	10715.5742	IRON
1026	21600.9637	10778.3424	IRON
1027	21320.3446	10709.8856	IRON
1028	21330.3959	10773.0914	IRON
1029	21190.0391	10707.2367	IRON
1030	21177.4290	10765.9819	IRON
1031	21145.7498	10764.0691	IRON
1032	21145.7448	10699.1737	IRON
1033	21087.7138	10691.1124	IRON
1034	21087.7138	10755.5628	IRON
1035	21145.4083	10889.1554	IRON
1036	21087.4086	10888.9971	IRON
1037	21144.8236	10456.1433	IRON
1038	21086.8640	10456.3631	IRON
1039	21195.6299	10404.9805	IRON
1040	21195.4101	10346.9507	IRON
1041	21309.0159	10346.5201	IRON
1042	21309.2357	10404.5197	IRON
1043	20805.7153	10691.2392	IRON
1044	20805.7153	10735.6865	IRON
1045	20747.7504	10762.5750	IRON
1046	20747.7385	10698.2742	IRON
1047	20746.6586	10413.3830	IRON
1048	20804.6588	10413.3830	IRON
1049	20805.4037	10888.2521	IRON
1050	20747.4039	10888.0920	IRON
1051	20648.4163	10703.1177	IRON
1052	20648.2461	10767.1175	IRON
1053	20474.5814	10705.6554	IRON
1054	20474.0014	10766.6541	IRON
1055	20476.9153	10445.1143	IRON
1056	20412.9179	10444.5343	IRON
1057	20364.4953	10332.1032	IRON
1058	20364.7379	10396.6122	IRON
1059	20189.8016	10332.7623	IRON
1060	20190.0442	10396.7619	IRON
1061	19942.9967	10195.9537	IRON
1062	19939.6999	10363.2705	IRON
1063	20407.7136	11018.8214	IRON
1064	20471.7109	11019.4013	IRON
1065	20453.5225	11128.9591	IRON
1066	20498.2319	11083.1653	IRON
1067	20501.6676	11175.9640	IRON
1068	20547.4614	11220.6734	IRON
1069	20657.8213	11328.4200	IRON
1070	20702.5307	11282.6262	IRON
1071	20717.6612	11298.4041	IRON
1072	20734.1638	11288.9976	IRON
1073	20752.4872	11344.7846	IRON
1074	20769.0099	11332.3781	IRON
1075	20841.9620	11308.1377	IRON
1076	20842.1048	11250.1378	IRON
1077	21088.6304	11250.7446	IRON
1078	21088.4876	11308.7444	IRON
1079	21310.5693	10910.2905	IRON
1080	20802.5988	11521.3370	IRON
1081	20738.5981	11521.1143	IRON
1082	20802.3161	11602.5594	IRON
1083	20802.1143	11660.5591	IRON
1084	21043.0619	11603.1519	IRON
1085	21042.9182	11661.1517	IRON
1086	21151.7930	11715.3287	IRON
1087	21093.7933	11712.3280	IRON
1088	21151.1126	11909.1985	IRON
1089	21093.1130	11908.9979	IRON
1090	20737.8048	11749.3694	IRON
1091	20737.5820	11813.3680	IRON
1092	20800.3445	12169.0325	IRON
1093	20736.3446	12168.8803	IRON
1094	20436.0197	11243.2042	IRON
1095	20481.8135	11287.9136	IRON
1096	20435.0079	11324.8800	IRON
1097	20442.0541	11341.4897	IRON
1098	20376.0902	11349.8743	IRON
1099	20383.1364	11366.4640	IRON
1100	20390.1211	11401.6485	IRON
1101	20454.1185	11402.2284	IRON
1102	20387.6039	11679.4123	IRON
1103	20451.6013	11679.9927	IRON
1104	20519.3618	11748.6981	IRON
1105	20519.1391	11812.6077	IRON
1106	20315.3974	11293.8416	IRON
1107	20315.2399	11357.8414	IRON
1108	20131.0915	11293.3880	IRON
1109	20130.5115	11357.3867	IRON
1110	20073.0904	11293.2452	IRON
1111	20072.5104	11357.2440	IRON
1112	20075.1759	11063.1186	IRON
1113	20133.1735	11063.6446	IRON
1114	20165.1698	11946.8330	IRON
1115	20067.1722	11946.3075	IRON
1116	19925.1675	12166.8838	IRON
1117	19809.7602	10562.0930	IRON
1118	19809.4044	10601.3529	IRON
1119	19745.4070	10600.7729	IRON
1120	19625.4120	10599.6855	IRON
1121	19624.1888	10734.6579	IRON
1122	19743.7969	10778.4463	IRON
1123	19807.7943	10778.0263	IRON
1124	19722.5176	10835.0321	IRON
1125	19771.0391	10876.7653	IRON
1126	19786.2020	10889.8070	IRON
1127	19720.9938	10963.6218	IRON

PT #	NORTHING	EASTING	DESC
1128	19705.8309	10992.5802	IRON
1129	19537.6616	11148.1035	IRON
1130	19495.1450	11275.6250	IRON
1131	19473.9235	11222.2091	IRON
1132	19425.4020	11180.4758	IRON
1133	19358.1301	11211.0909	IRON
1134	19337.2666	11275.0896	IRON
1135	19444.5773	11324.4777	IRON
1136	19686.3105	11275.9562	IRON
1137	19720.3272	11356.4017	IRON
1138	19720.4847	11292.4019	IRON
1139	19738.3042	11356.4219	IRON
1140	19802.5054	11356.5794	IRON
1141	19736.2936	11600.3554	IRON
1142	19800.2910	11600.9353	IRON
1143	19843.9119	11653.0322	IRON
1144	19880.9695	11724.7788	IRON
1145	19864.5905	11788.8757	IRON
1146	19928.5879	11789.4556	IRON
1147	19861.6467	12113.7151	IRON
1148	19861.3205	12149.7137	IRON
1149	19860.8706	12199.7116	IRON
1150	19860.5478	12235.7102	IRON
1151	19858.8121	12429.2793	IRON
1152	19922.8096	12429.8532	IRON
1153	19880.0311	12235.3459	IRON
1154	19820.3539	12199.3483	IRON
1155	19777.7628	12112.9630	IRON
1156	19745.3511	12148.6738	IRON
1157	19759.7612	12168.3124	IRON
1158	19720.7367	12189.6097	IRON
1159	19739.4938	12093.2613	IRON
1160	19660.6769	12094.1302	IRON
1161	19712.2761	12056.2684	IRON
1162	19684.9945	12023.6856	IRON
1163	19638.6544	12067.8285	IRON
1164	19621.7321	11957.2743	IRON
1165	19575.3920	12001.4172	IRON
1166	19543.0268	11903.1580	IRON
1167	19518.9885	11962.2295	IRON
1168	19352.0799	11823.5478	IRON
1169	19298.4476	11801.4653	IRON
1170	19265.9652	11865.3227	IRON
1171	19238.8903	11850.6128	IRON
1172	19252.2768	11788.0285	IRON
1173	19383.2614	11598.0374	IRON
1174	19436.7949	11620.3568	IRON
1175	19092.0556	11753.7578	IRON
1176	19078.6591	11816.3422	IRON
1177	18974.2788	11687.2622	IRON
1178	19038.2788	11687.2621	IRON
1179	19038.2787	11640.5495	IRON
1180	18974.2787	11640.5496	IRON
1181	18994.4105	11570.4815	IRON
1182	19048.6496	11604.4538	IRON
1183	19145.8130	11328.7569	IRON
1184	19190.6192	11377.7895	IRON
1185	19186.1172	11278.0076	IRON
1186	19206.1168	11279.1337	IRON
1187	19177.4825	11273.9531	IRON
1188	19177.8870	11209.9544	IRON
1189	19138.6609	11197.1960	IRON
1190	19101.3387	11249.1870	IRON
1191	18907.7020	11257.9010	IRON
1192	18977.6811	11160.4181	IRON
1193	19015.0033	11108.4272	IRON
1194	19084.9824	11010.9442	IRON
1195	19169.8973	11071.9012	IRON
1196	19333.2406	11072.9312	IRON

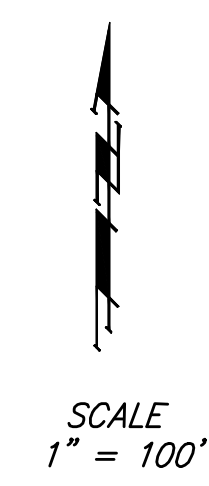



Baughman

AUBURN HILLS 16TH ADD - PHASE 3

COORDINATE SHEET

SANITARY SEWER IMPROVEMENTS

Baughman Company, P.A. 315 Ellis St. Wichita, KS 67211 P 316-262-7271 F 316-262-0149

ENGINEERING | SURVEYING | PLANNING | LANDSCAPE ARCHITECTURE

DESIGN RDM

DRAWN RDM

APPROVED DATE

NOV 2007

PROJECT NUMBER

448-00123

SCALE

Noted

SHEET

18 OF 20

REVISIONS:

Auburn Hills 16th Phase 3\SS\19-20_SS Coordinates.dwg

07-09-E926