


SURV.
 PLOT.
 DTS.
 DR.
 TR.
 CKD.
 APP.

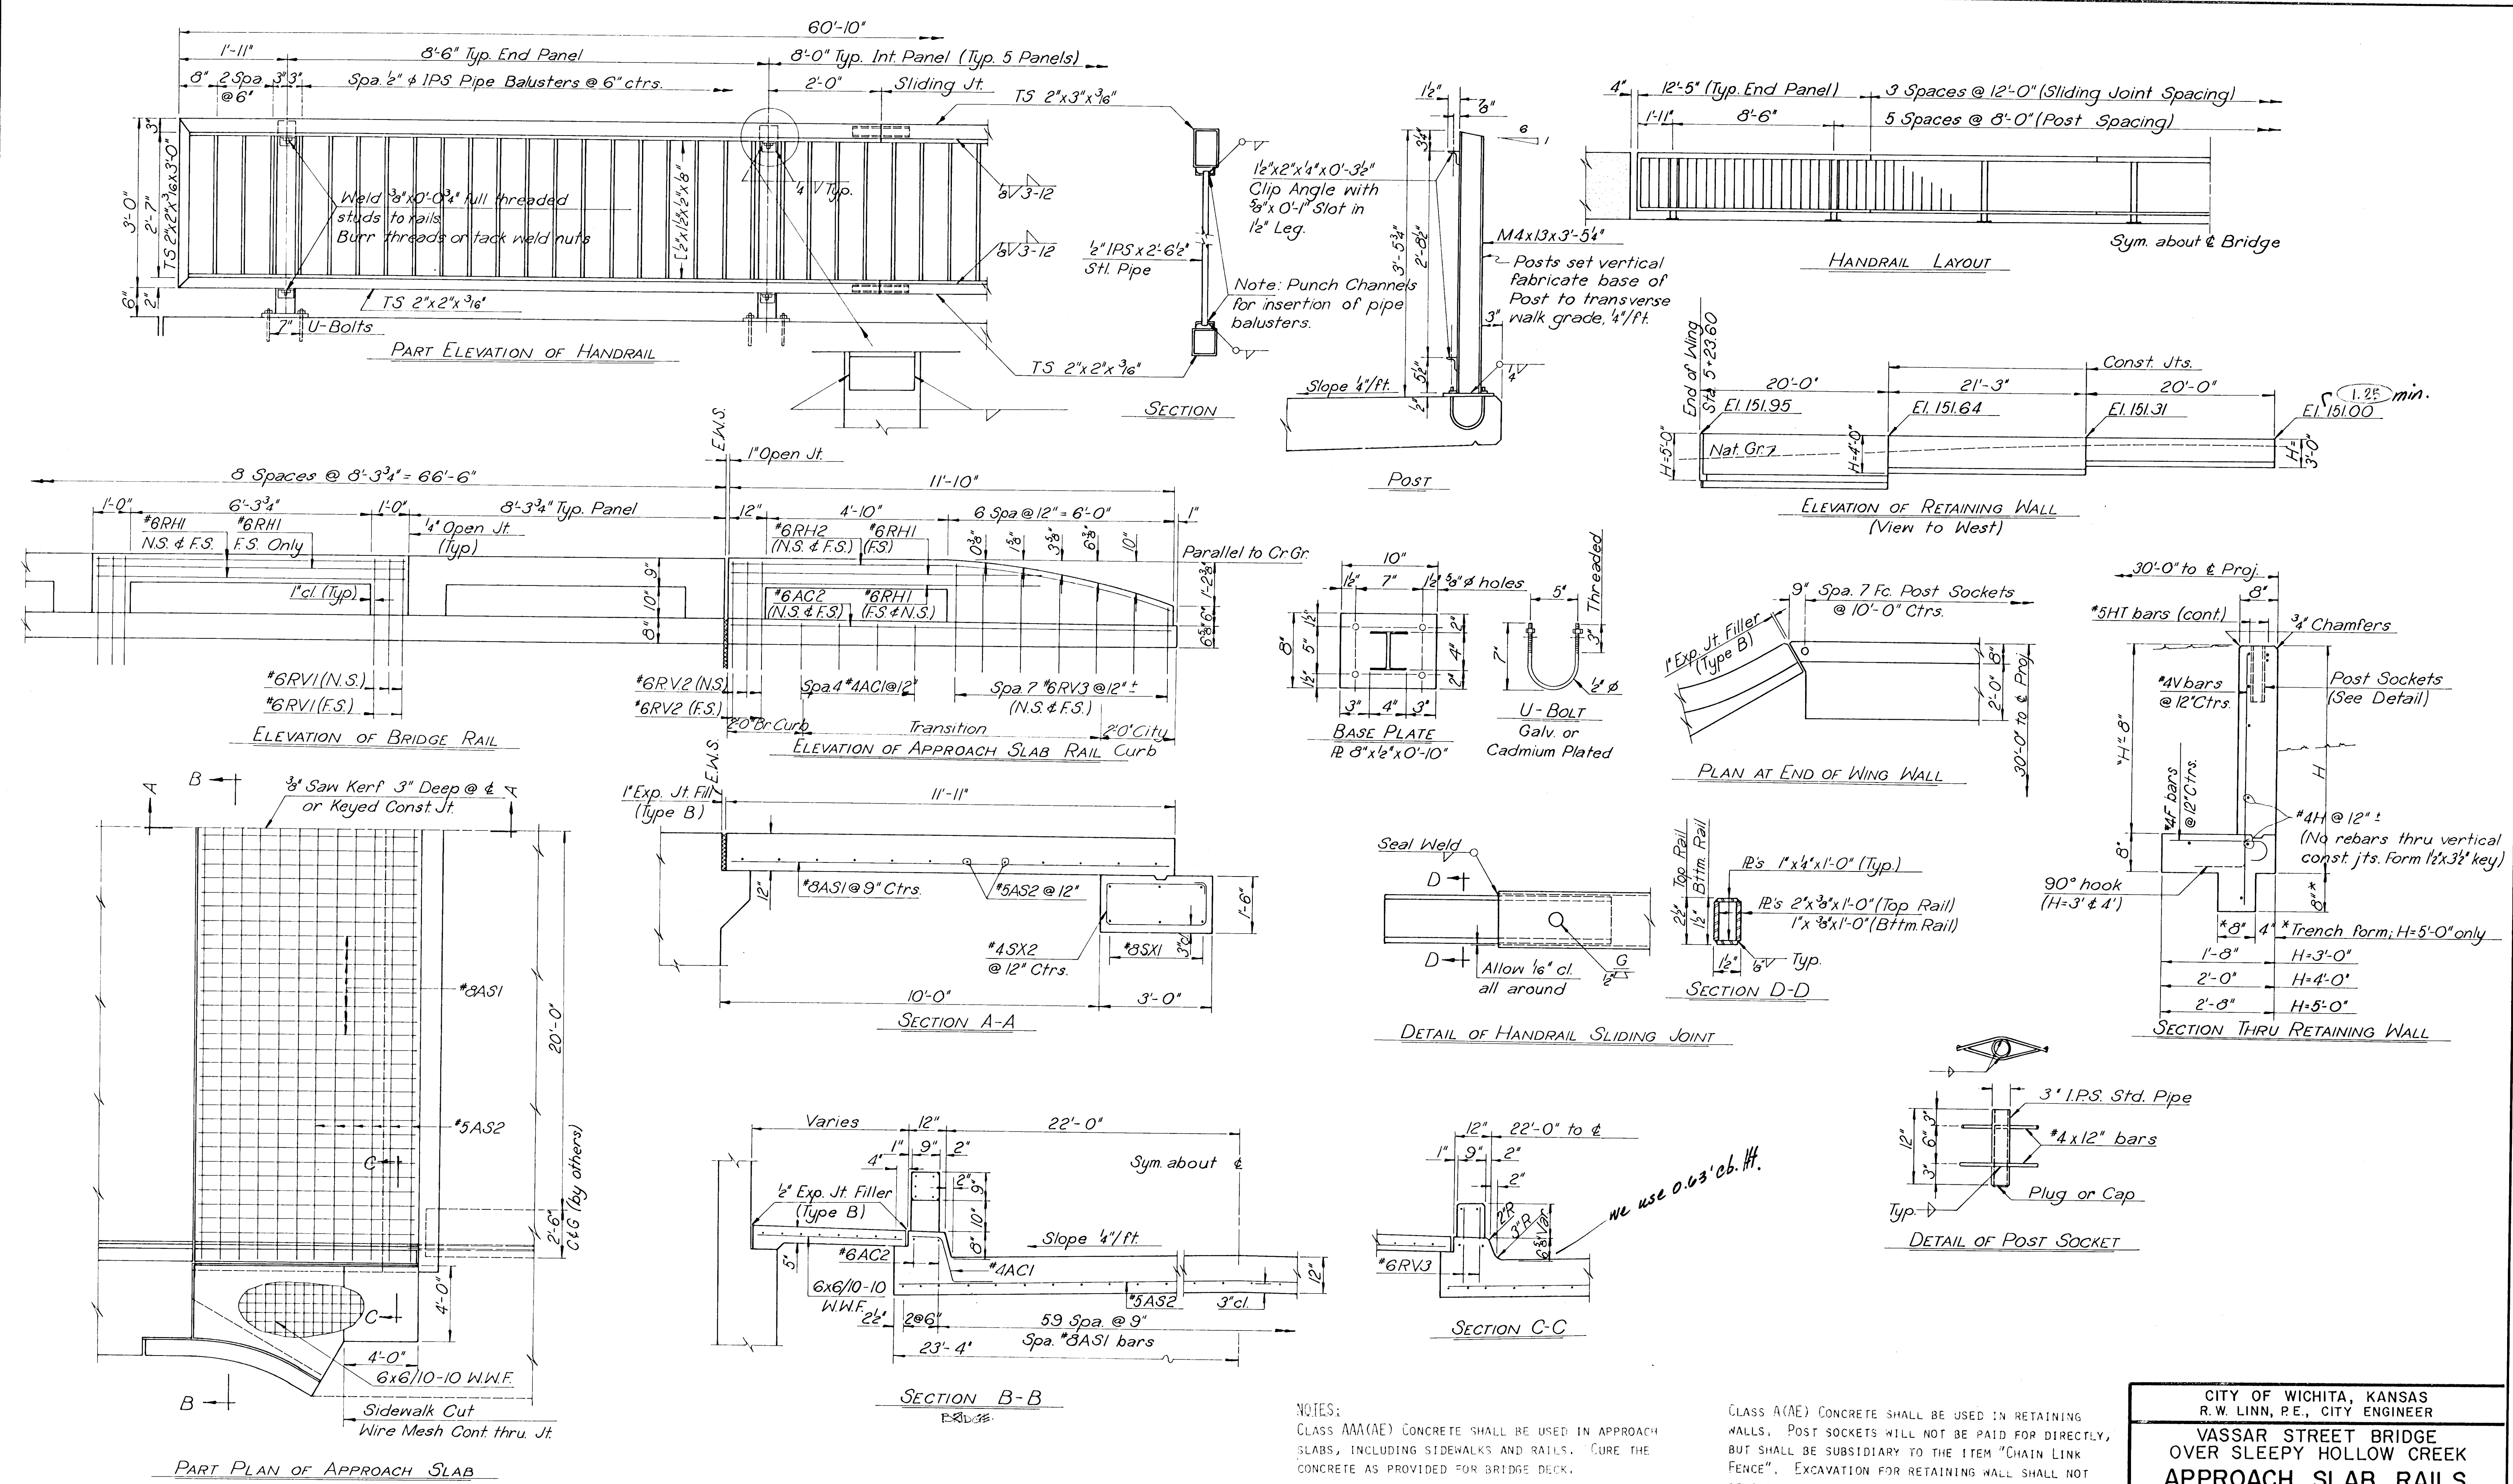

NOTES:
 CLASS AAA(AE) CONCRETE SHALL BE USED IN APPROACH SLABS, INCLUDING SIDEWALKS AND RAILS. CURE THE CONCRETE AS PROVIDED FOR BRIDGE DECK.
 APPROXIMATE QUANTITIES, EACH SLAB (TWO THUS):
 CLASS AAA(AE) CONCRETE: 31.5 CU. YDS.
 REINFORCING STEEL: 3960 LBS.*
 *INCLUDES 25LBS. WELDED WIRE MESH.
 CLASS A(AE) CONCRETE SHALL BE USED IN RETAINING WALLS. POST SOCKETS WILL NOT BE PAID FOR DIRECTLY, BUT SHALL BE SUBSIDIARY TO THE ITEM "CHAIN LINK FENCE". EXCAVATION FOR RETAINING WALL SHALL NOT BE PAID FOR DIRECTLY, BUT SHALL BE CONSIDERED SUBSIDIARY TO THE ITEM "CLASS A(AE) CONCRETE".
 SEE SHEET NO. 1 FOR GENERAL NOTES.
 SEE SHEET NO. 7 FOR BAR LIST AND BENDING DIAGRAMS.

CITY OF WICHITA, KANSAS
 R.W. LINN, P.E., CITY ENGINEER
**VASSAR STREET BRIDGE
 OVER SLEEPY HOLLOW CREEK
 APPROACH SLAB, RAILS,
 RETAINING WALL**
 DELAMATER, FREUND & SCHERER, P.A.
 ENGINEERS & ARCHITECTS
 WICHITA, KANSAS
 SCALE:
 DATE: December, 1975
 DWG. NO. 79-R-6