
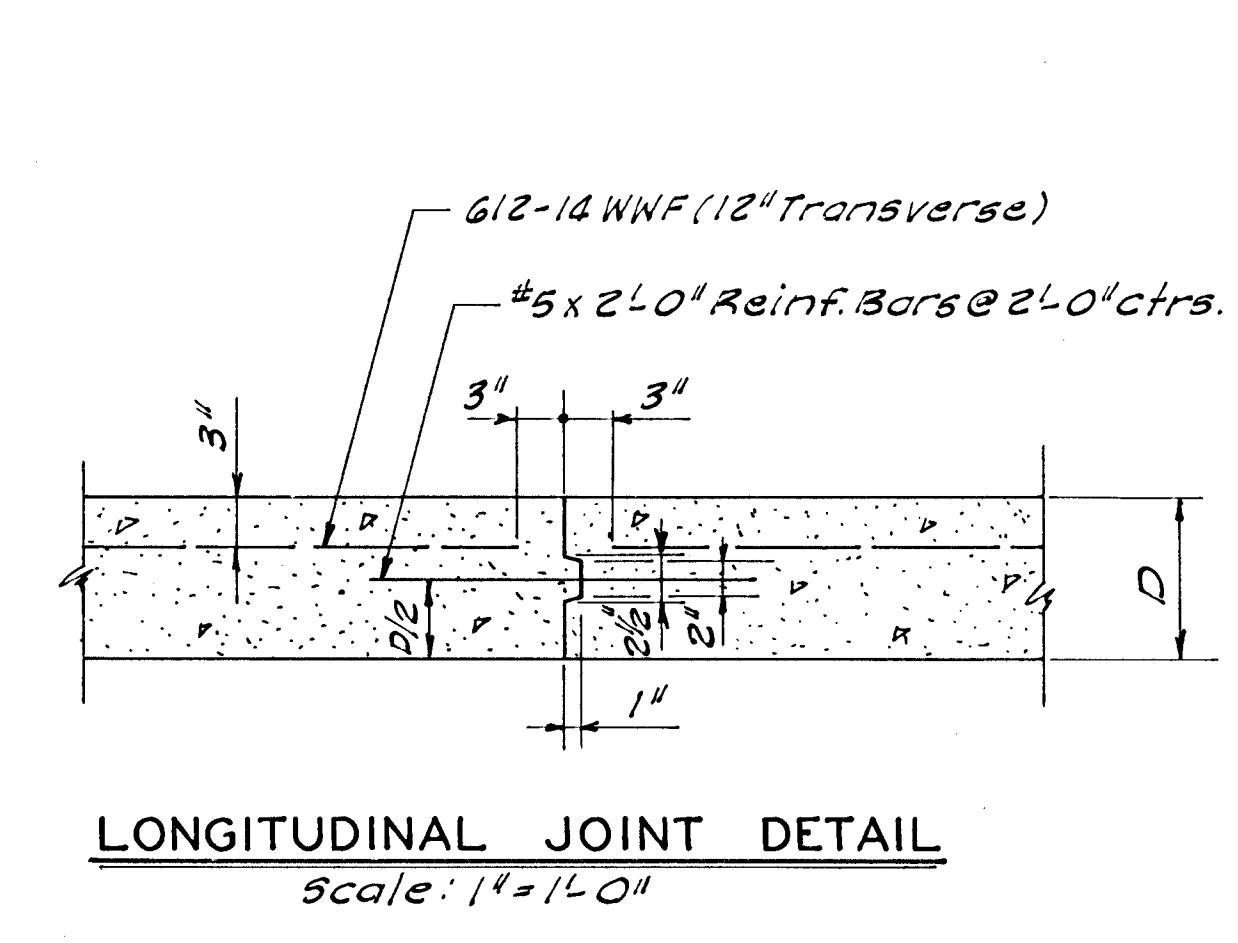
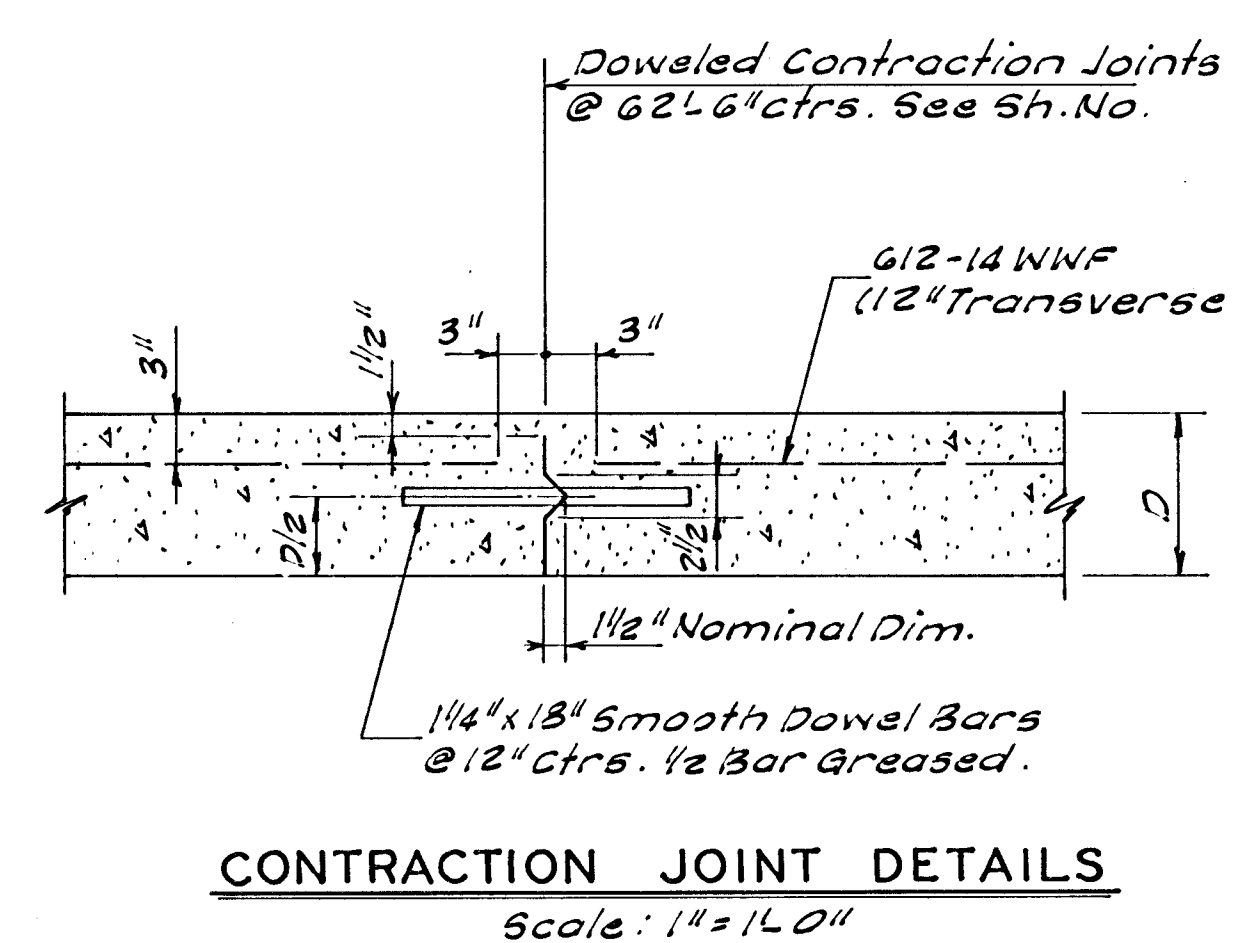
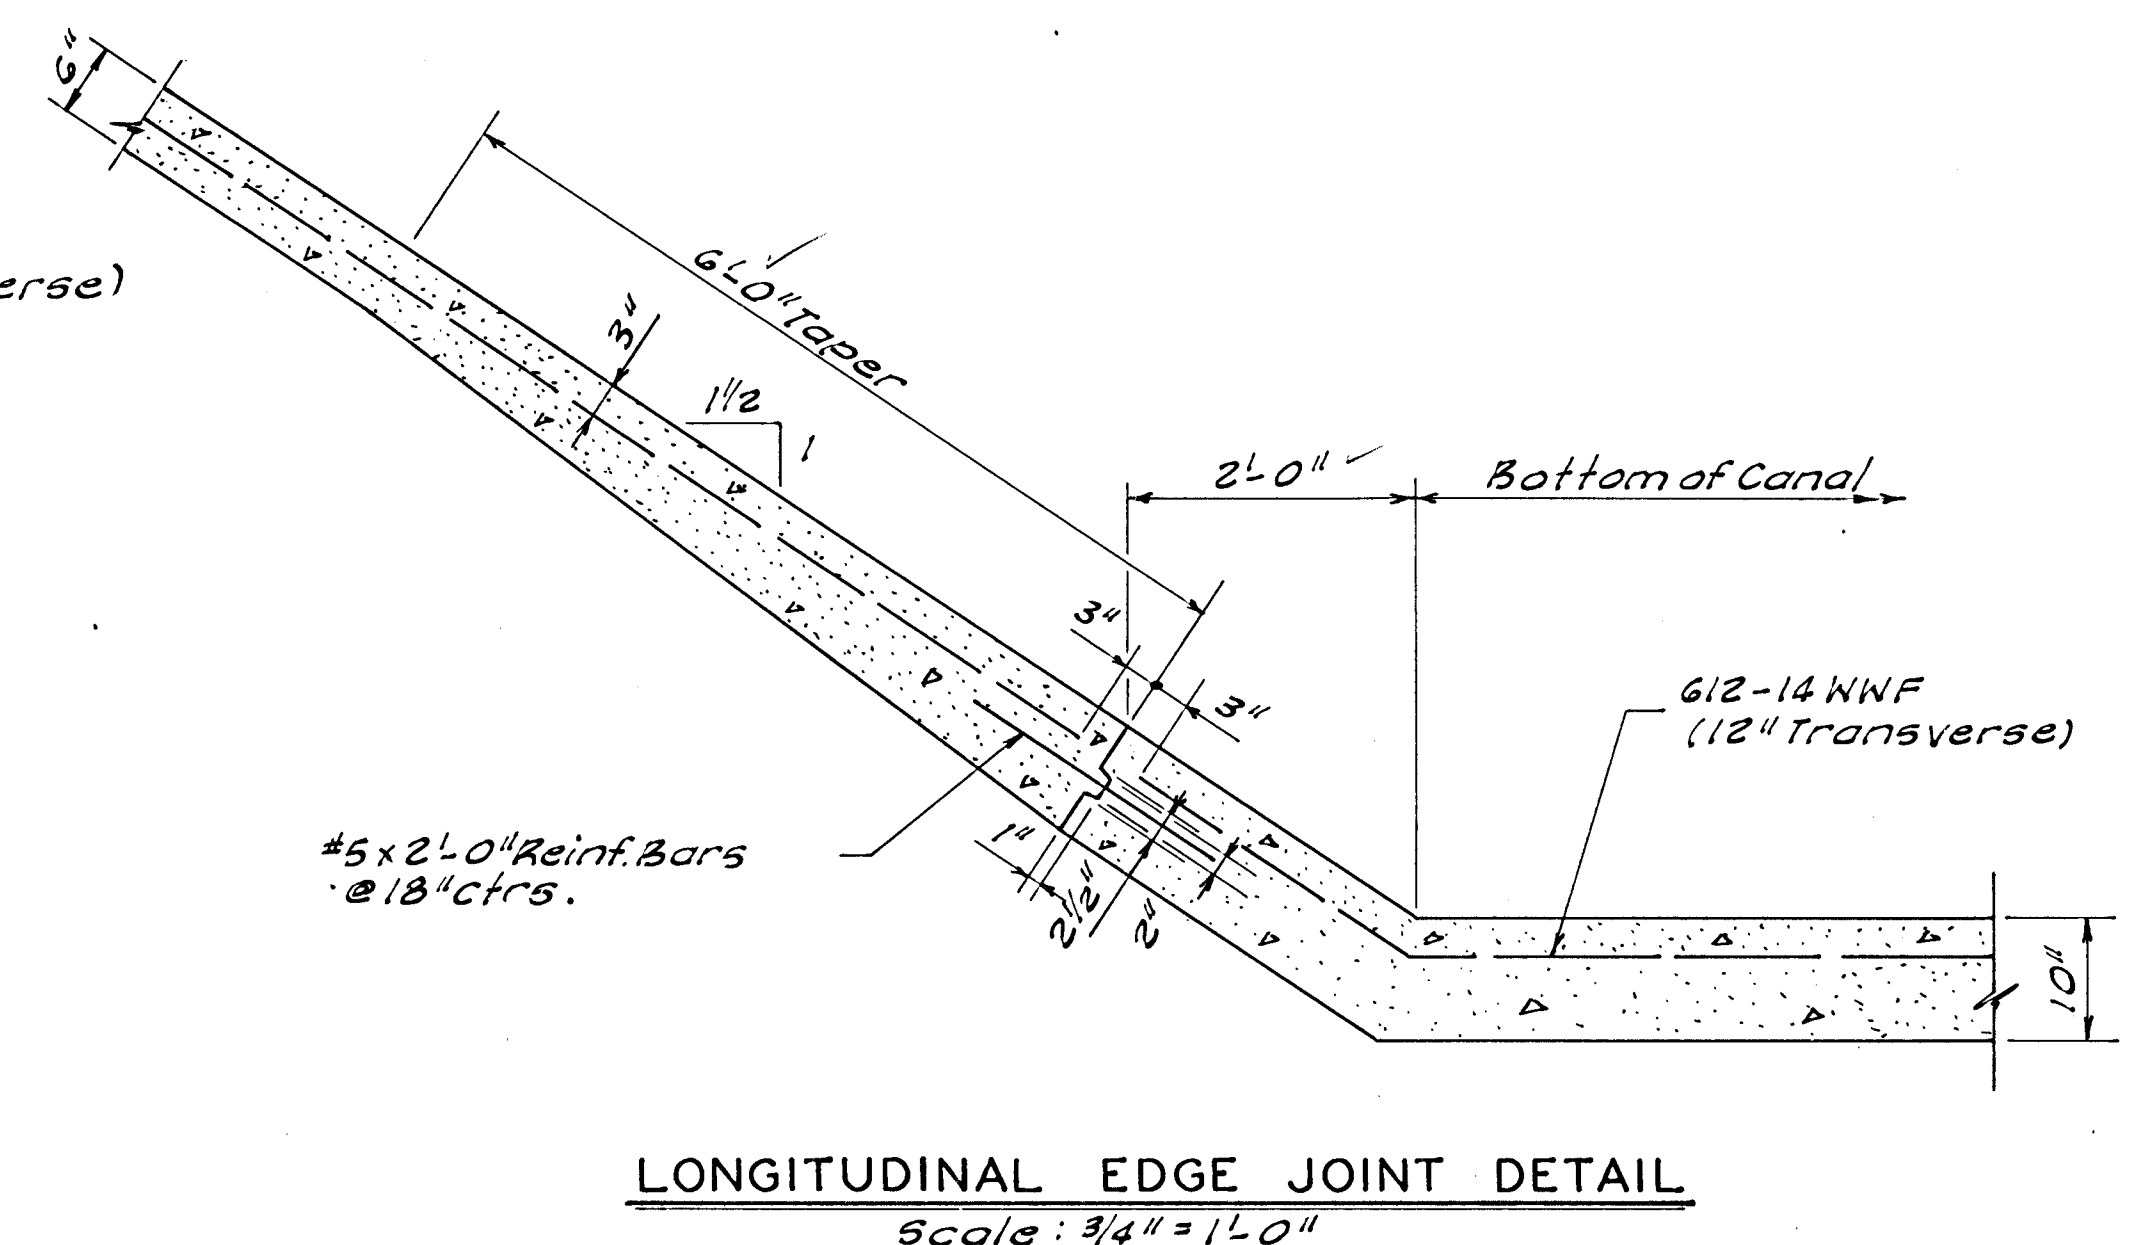
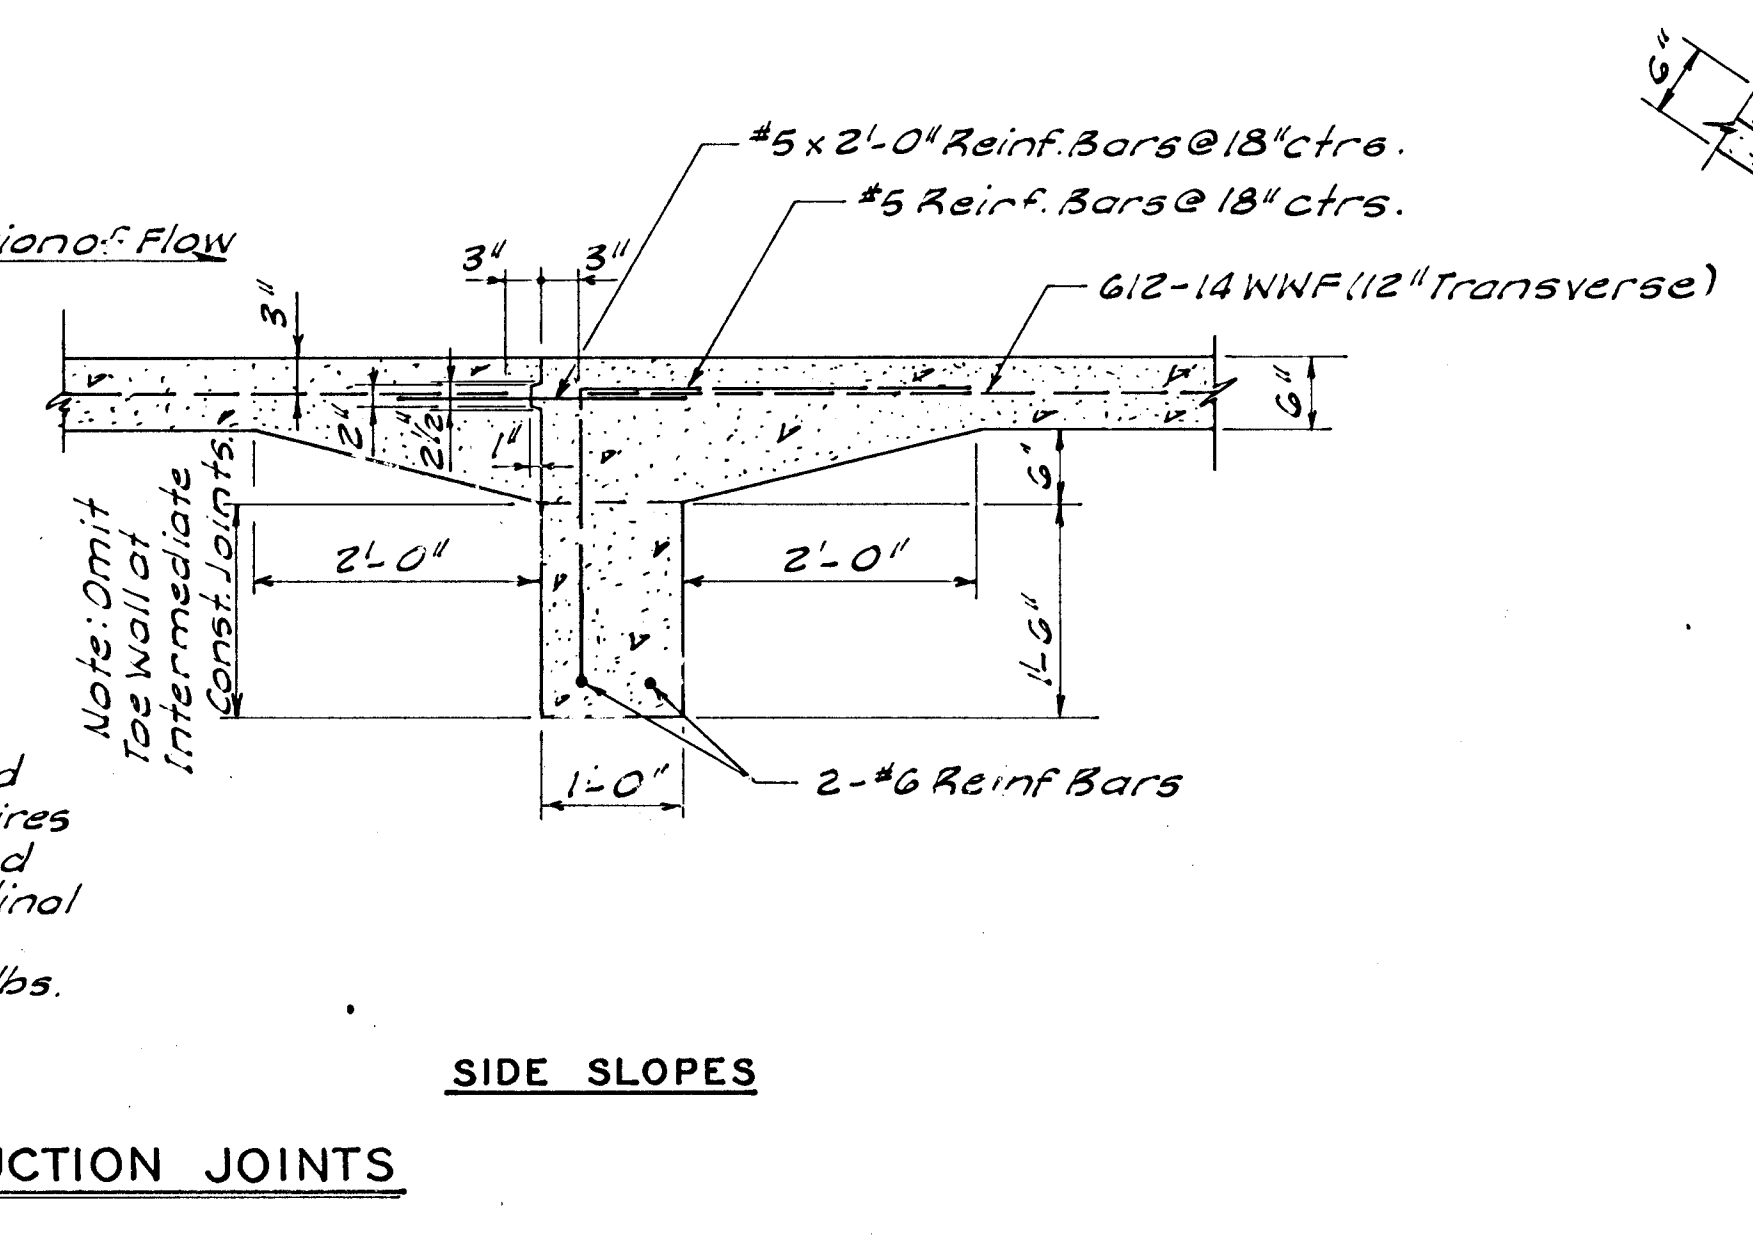
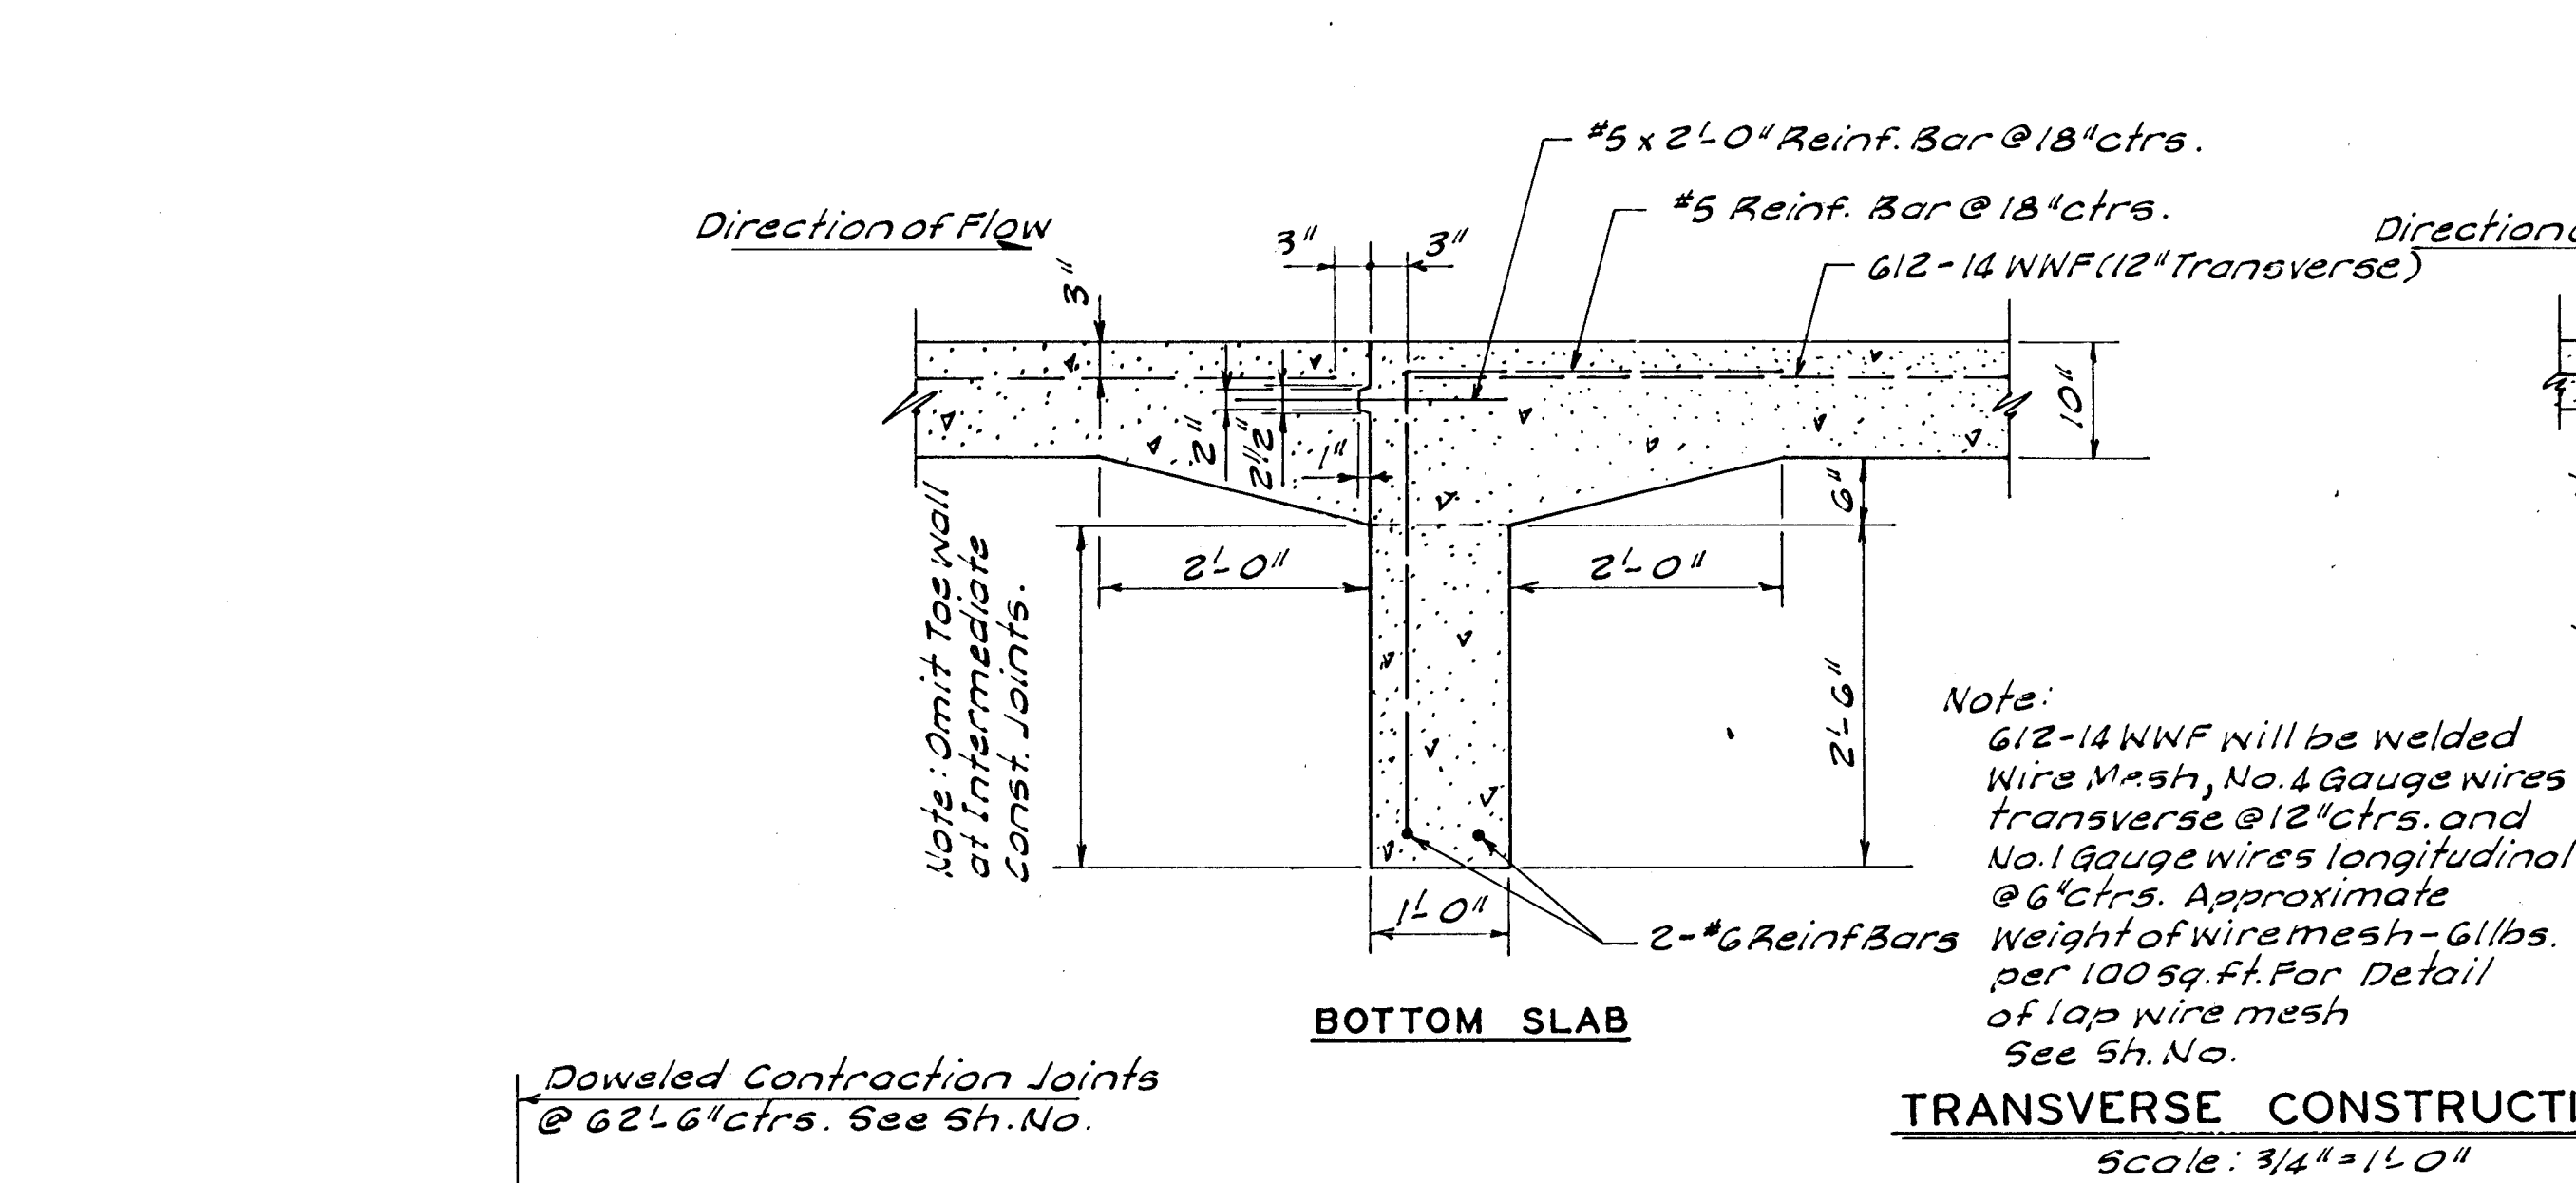


| PUB. ROAD<br>DIV. NO. | STATE  | PROJECT<br>NO.           | FISCAL<br>YEAR | SHEET<br>NO. | TOTAL<br>SHEETS |
|-----------------------|--------|--------------------------|----------------|--------------|-----------------|
| 5                     | KANSAS | 35W-87 I-35W<br>-1133126 | 1970           | 7            | 225             |

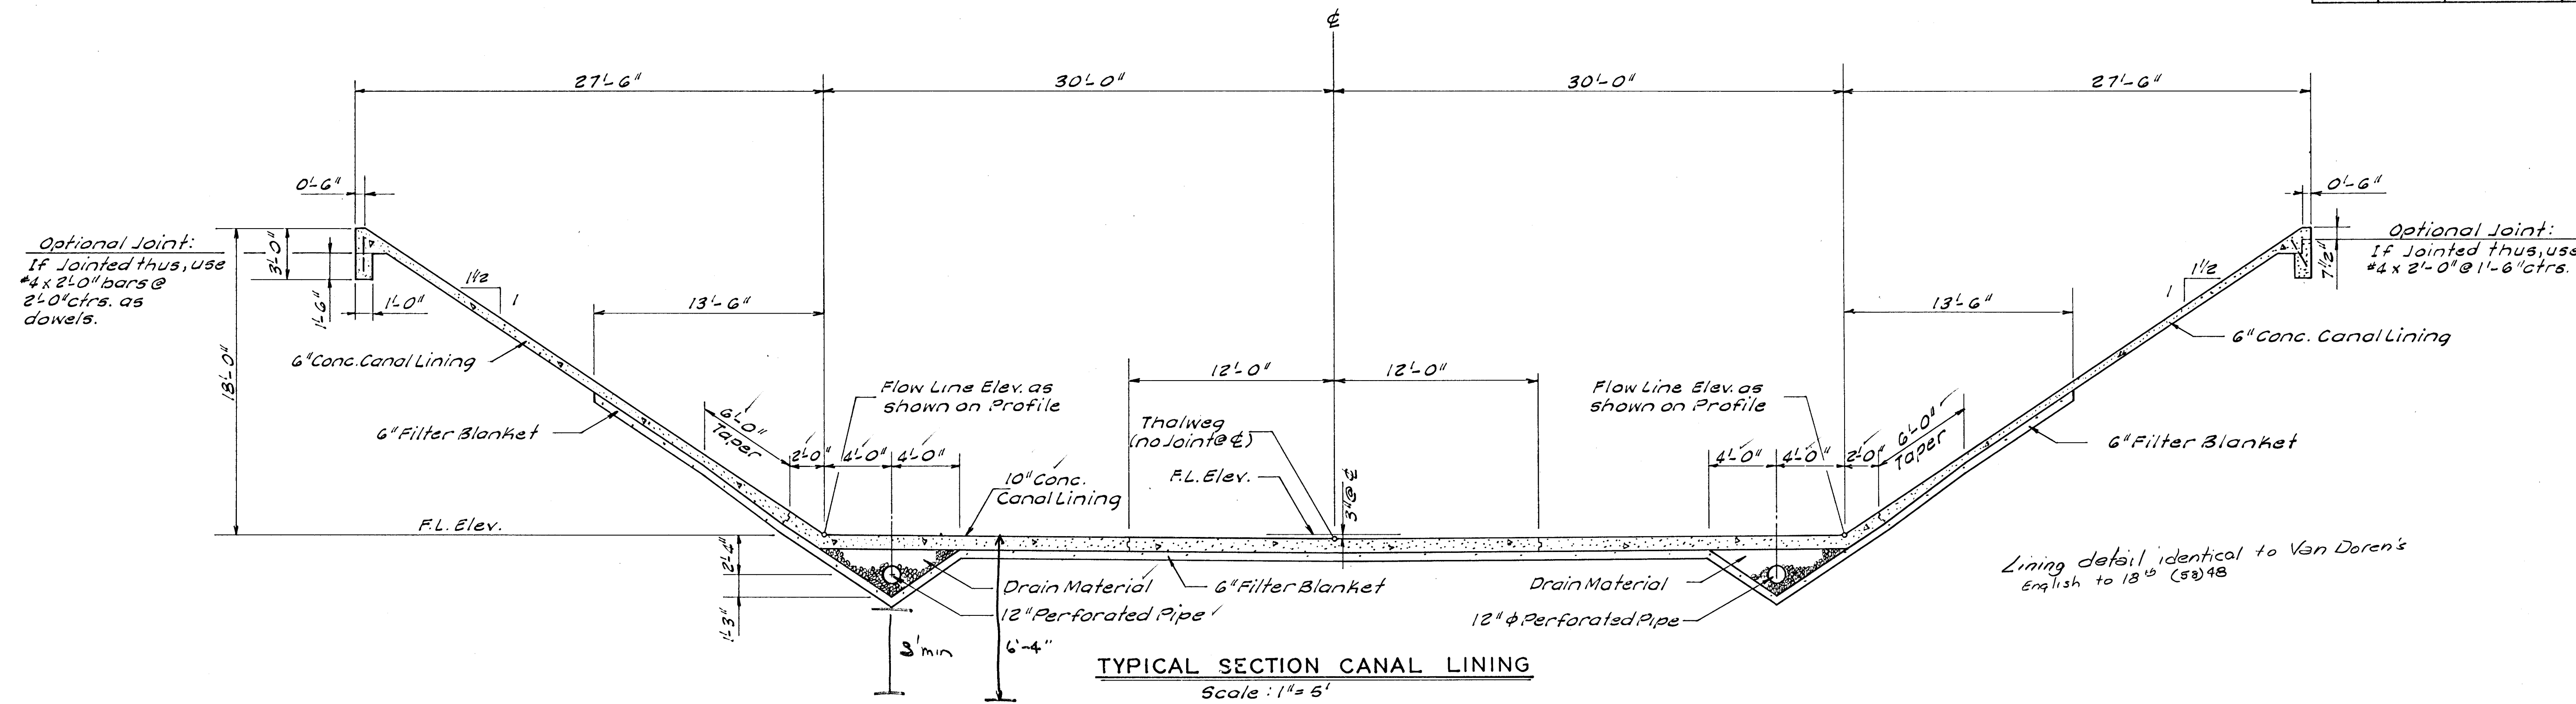

| 3                                                            |        |           |        |         |     |
|--------------------------------------------------------------|--------|-----------|--------|---------|-----|
| 2                                                            |        |           |        |         |     |
| 1                                                            |        |           |        |         |     |
| NO.                                                          | DATE   | REVISIONS | BY     | APP'D   |     |
| STATE HIGHWAY COMMISSION OF KANSAS                           |        |           |        |         |     |
| CANAL LINING SECTION & DETAILS                               |        |           |        |         |     |
| WILSON & COMPANY<br>ENGINEERS & ARCHITECTS<br>SALINA, KANSAS |        |           |        |         |     |
| DESIGNED                                                     | S.T.F. | TRACED    | J.F.B. | CHECKED | DCT |