

SEWER SERVICE TABLE

NUMBER	TYPE	LOCATION			FOR INFORMATION ONLY	
		LOT NO.	BLOCK NO.	LINE NO.	STATION DIRECTION	APPROXIMATE LENGTH 4" PIPE
9	10" X 4" Tee	46	A	1	10+00/Rt.	02 10.5'
10	10" X 4" Tee	45	A	1	11+56/Rt.	11.5'
11	10" X 4" Tee	36	A	1	13+50/Rt.	11.0'
12	10" X 4" Tee	35	A	1	15+00/Rt.	10.0'
13	4" Stub	34	A	1	16+00/Rt.	06 10.0'
14	10" X 4" Tee	33	A	1	16+00/Rt.	91 10.0'
15	8" X 4" Tee	20	A	1	18+00/Rt.	68.5 10.0'



NOTE: Vertical Riser Pipe shall be extended to 2' minimum above ground water elevation and 4' maximum below proposed ground elevation.

BENCHMARKS:
 BM #1: BENT 60d NAIL IN LIGHT POLE, 55' SSW OF THE E1/4 COR., SEC. 13, TWP. 26-S, R-1-W.
 ELEV. = 1336.54 NGVD29

BM #2: RAILROAD SPIKE IN E. FACE OF N. "H" POLE, 60± S. OF N. LINE, S1/2, NE1/4, SEC. 13, TWP. 26-S, R-1-W.
 ELEV. = 1335.93 NGVD29

BM #3: "□" CUT ON TOP OF NE COR. OF WATER VAULT, 437± E. & 54± N. OF S1/4 COR., SEC. 13, TWP. 26-S, R-1-W.
 ELEV. = 1334.81 NGVD29

Scale: 1" = 40' Horizontal
 1" = 5' Vertical
 • = Iron

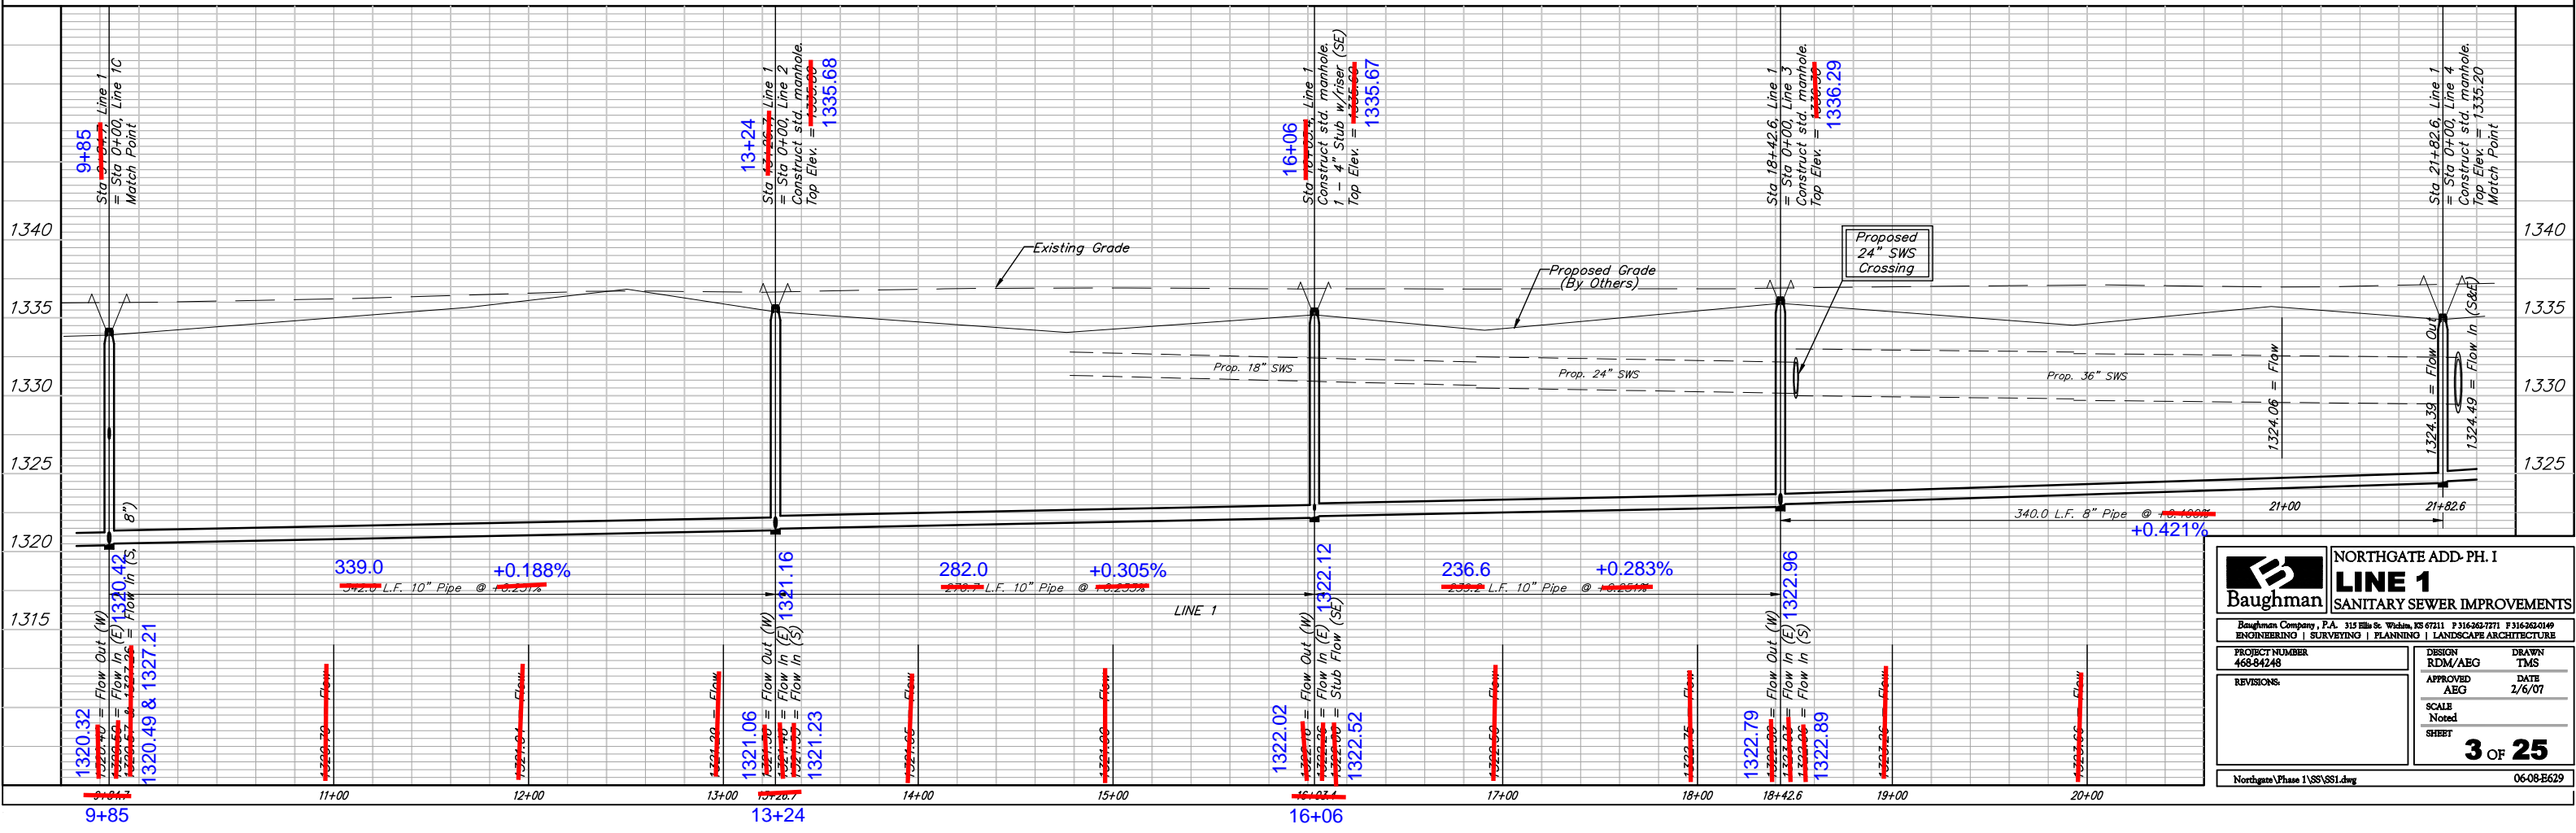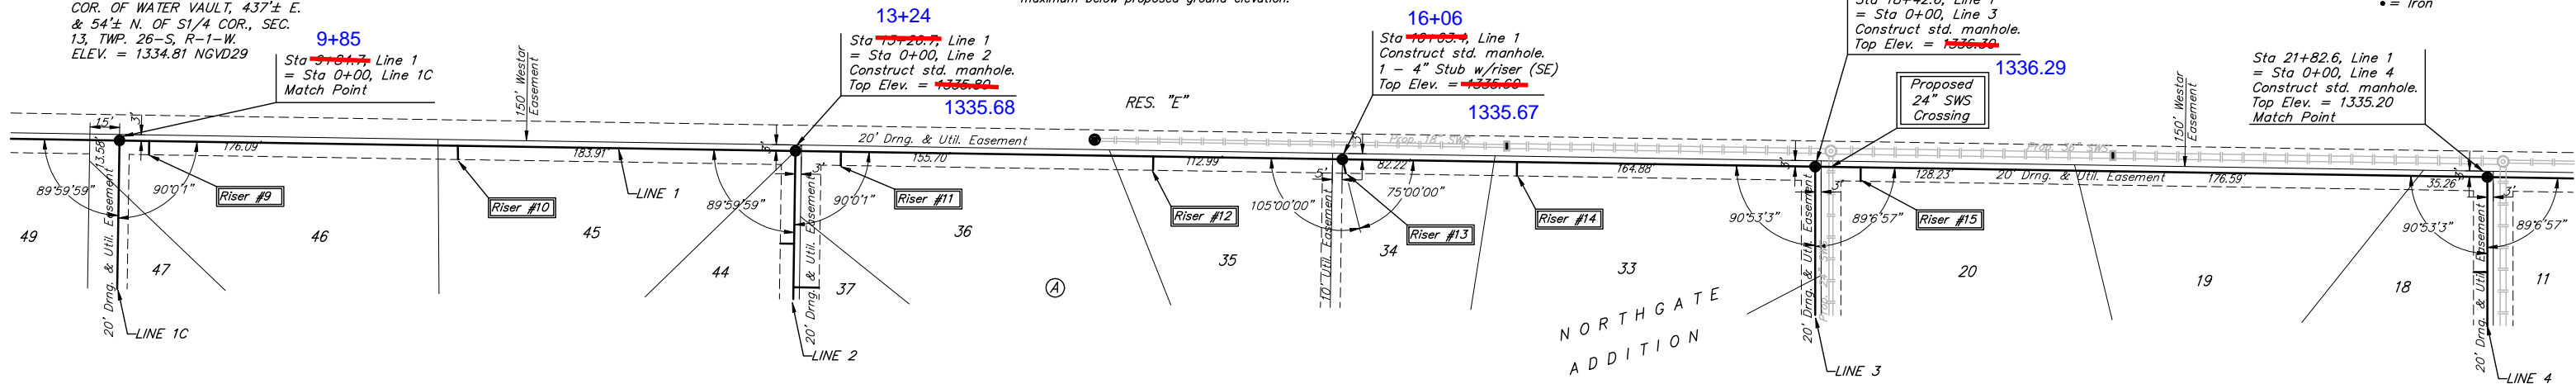

Baughman NORTHGATE ADD. PH. I
LINE 1
 SANITARY SEWER IMPROVEMENTS

Baughman Company, P.A. 315 Ellis St. Wichita, KS 67211 P 316-262-7771 F 316-262-0149
 ENGINEERING | SURVEYING | PLANNING | LANDSCAPE ARCHITECTURE

PROJECT NUMBER: 468-84248
 DESIGN: RDM/ABG
 DRAWN: TMS
 APPROVED: ABG
 DATE: 2/6/07
 SCALE: Noted
 SHEET: 3 OF 25

Northgate Phase 1\SS\SS1.dwg 06-08-B629