
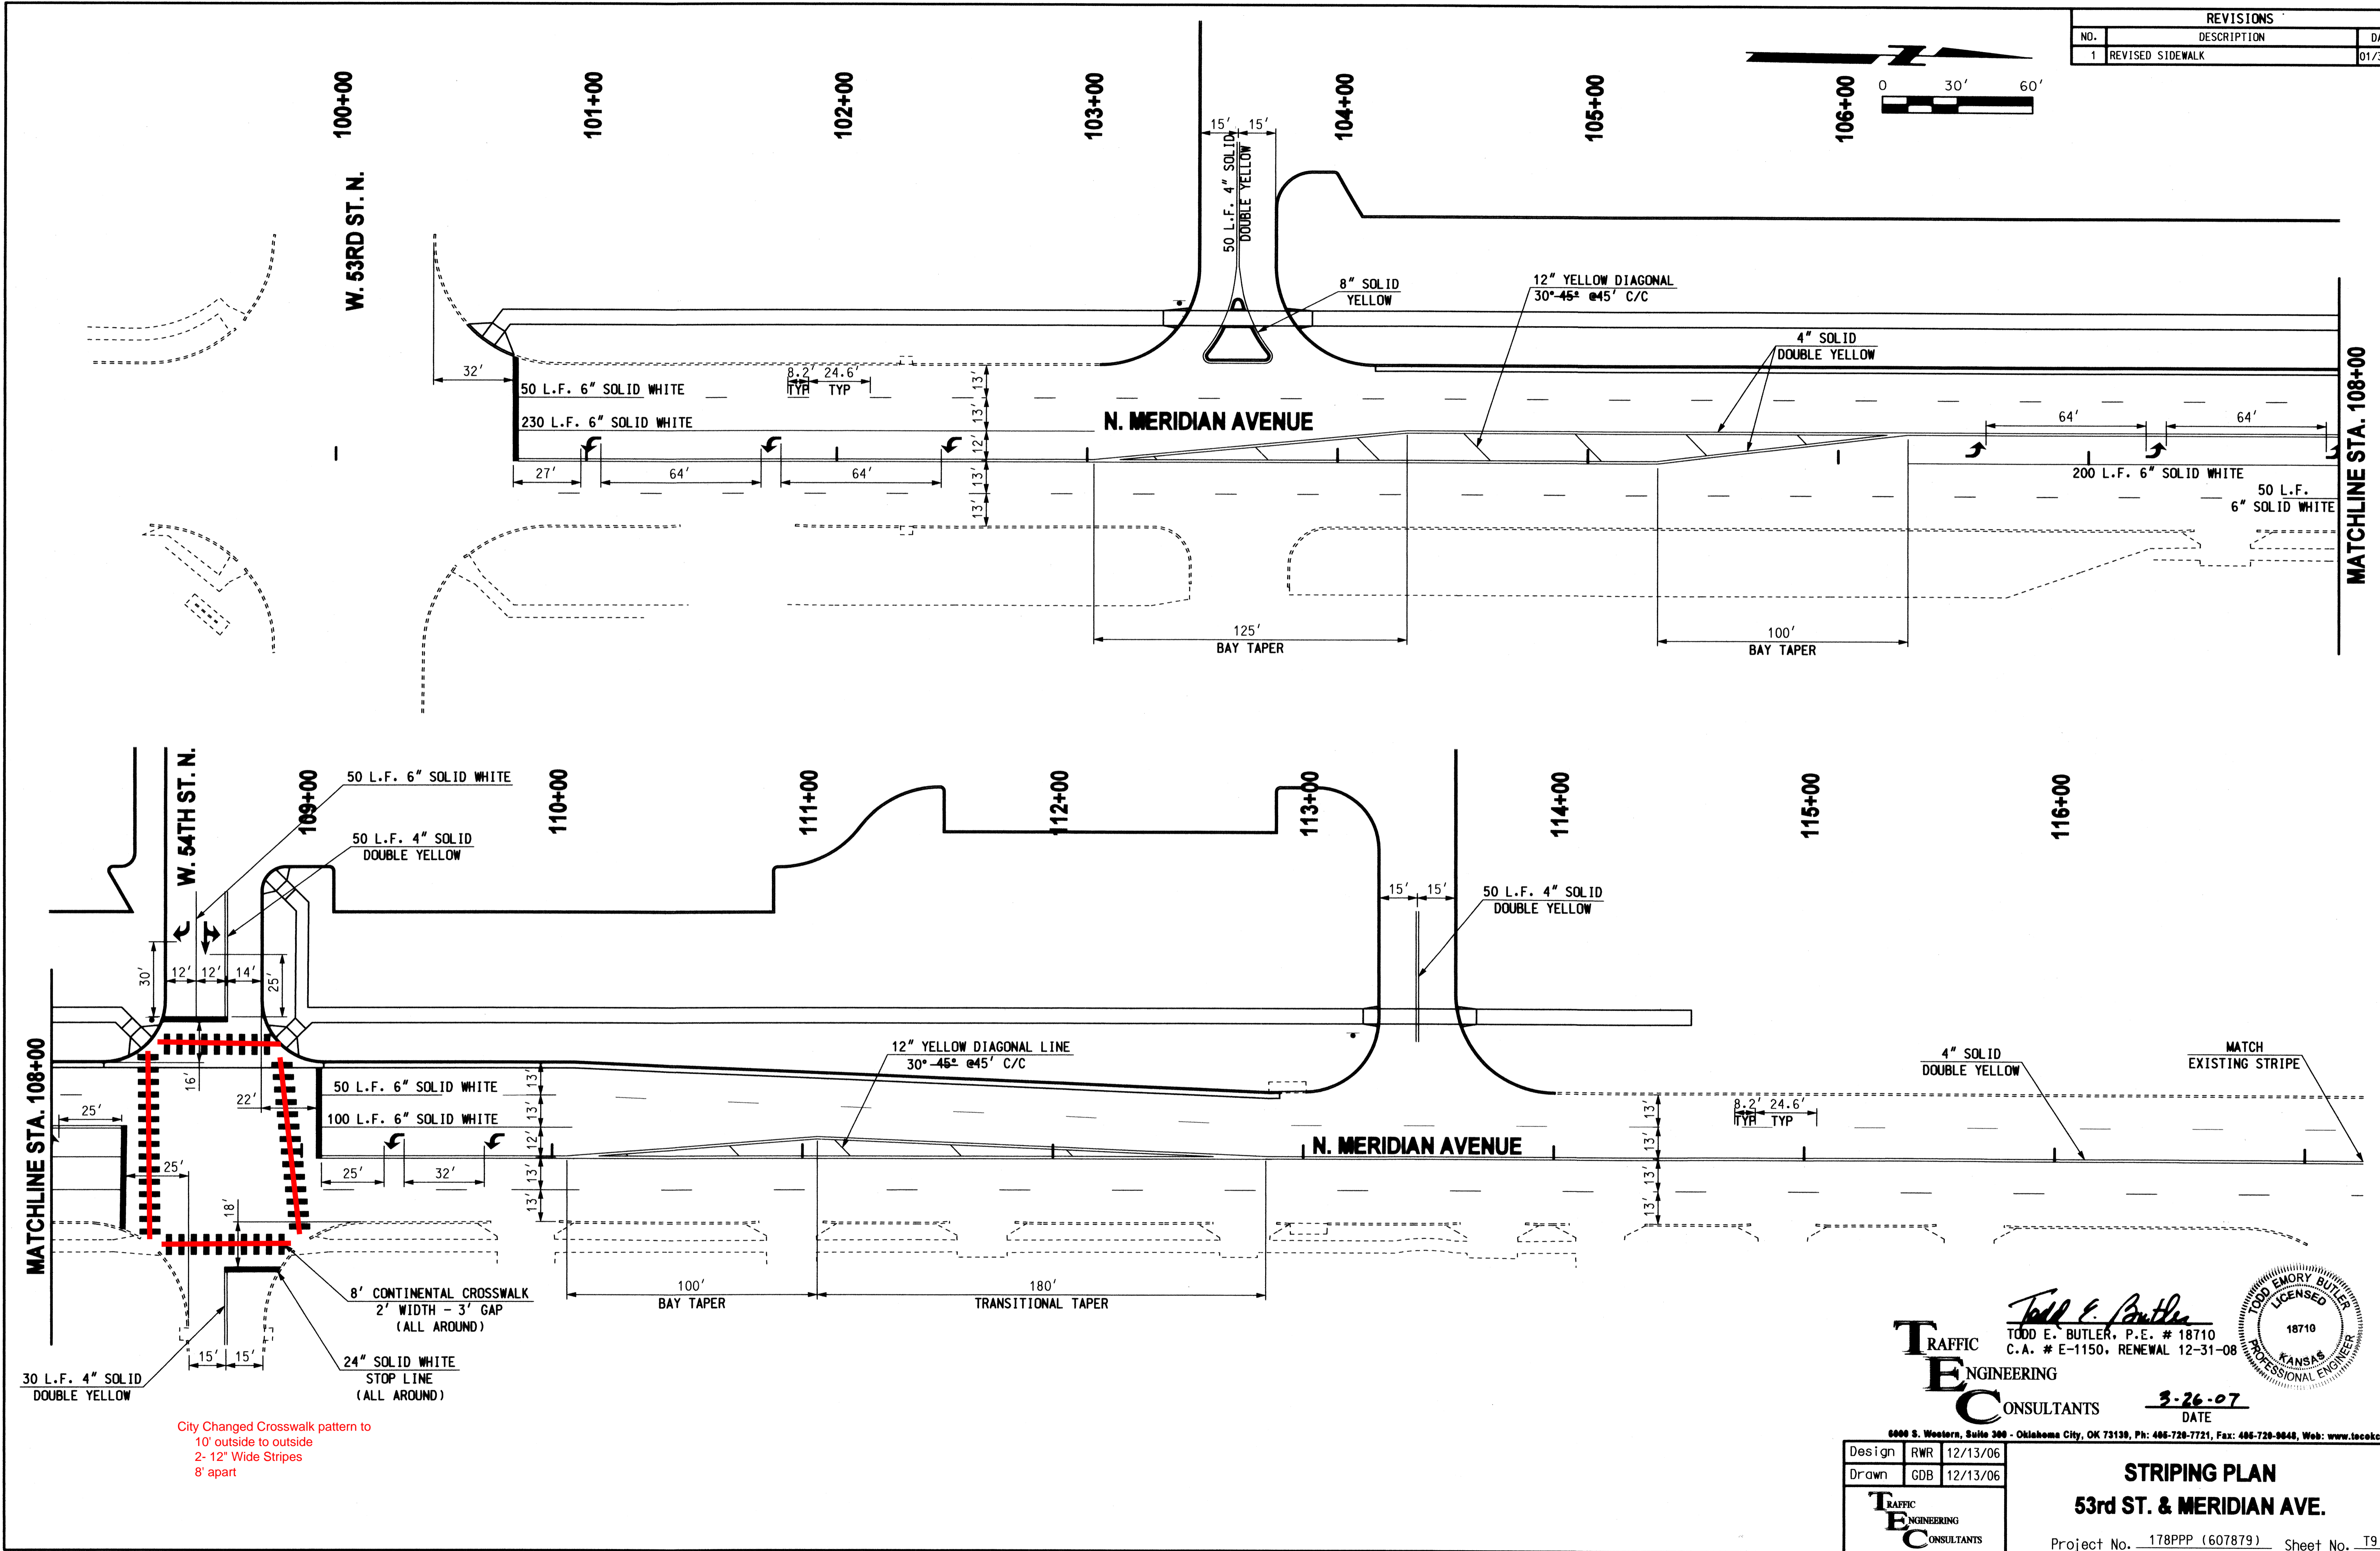


REVISIONS		
NO.	DESCRIPTION	DATE
1	REVISED SIDEWALK	01/30/07

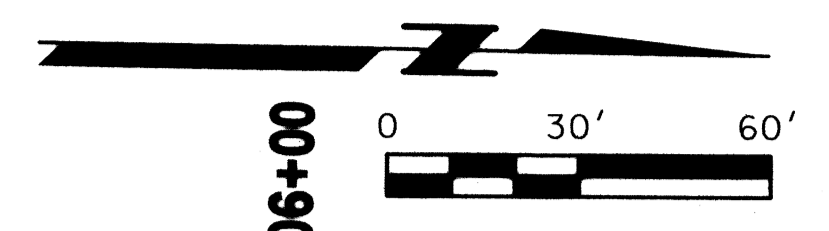

City Changed Crosswalk pattern to
 10' outside to outside
 2- 12\"/>

03/23/07 F:\CAD\T-563\STRIPING REV3.dgn

Traffic Engineering Consultants
 Todd E. Butler, P.E. # 18710
 C.A. # E-1150, RENEWAL 12-31-08
 DATE: **3-26-07**

Design	RWR	12/13/06
Drawn	GDB	12/13/06
STRIPING PLAN		
53rd ST. & MERIDIAN AVE.		
Project No. 178PPP (607879)		Sheet No. 19

6000 S. Western, Suite 300 - Oklahoma City, OK 73139, Ph: 406-728-7721, Fax: 406-728-9848, Web: www.tecokc.com

SEDGWICK COUNTY