
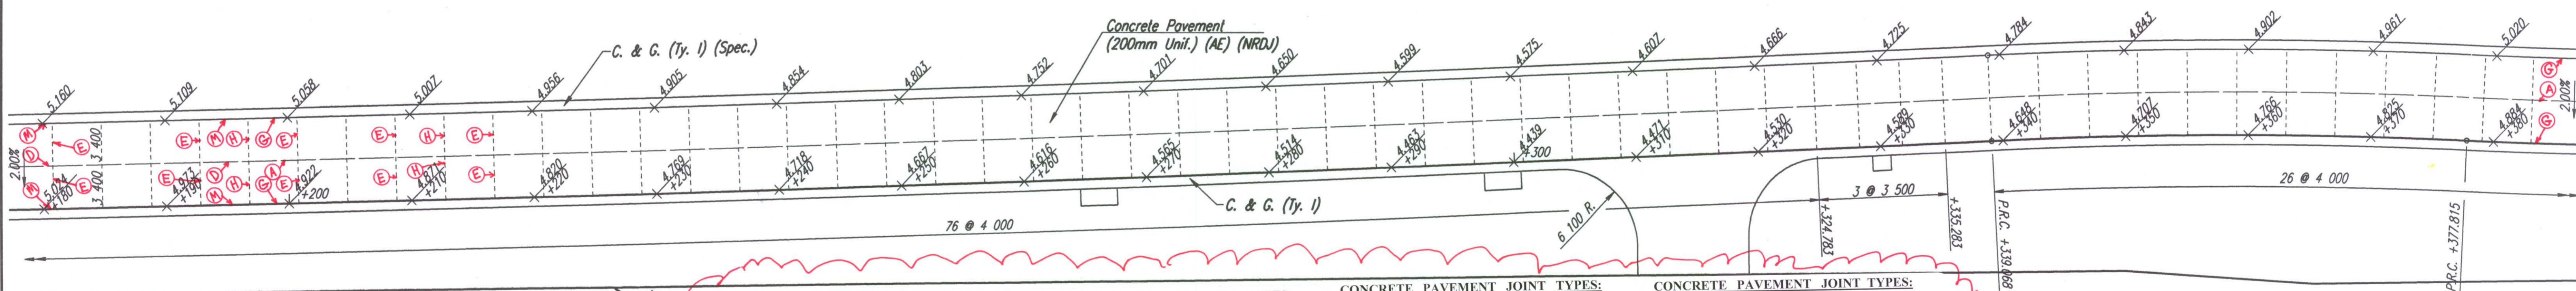


FHWA REGION NO.	STATE	PROJECT NO.	YEAR	SHEET NO.	TOTAL SHEETS
7	KANSAS	54-87 K-6657-01	2002	94	1122

DATE	BY	REFERENCES NOTED	REFERENCES CHECKED

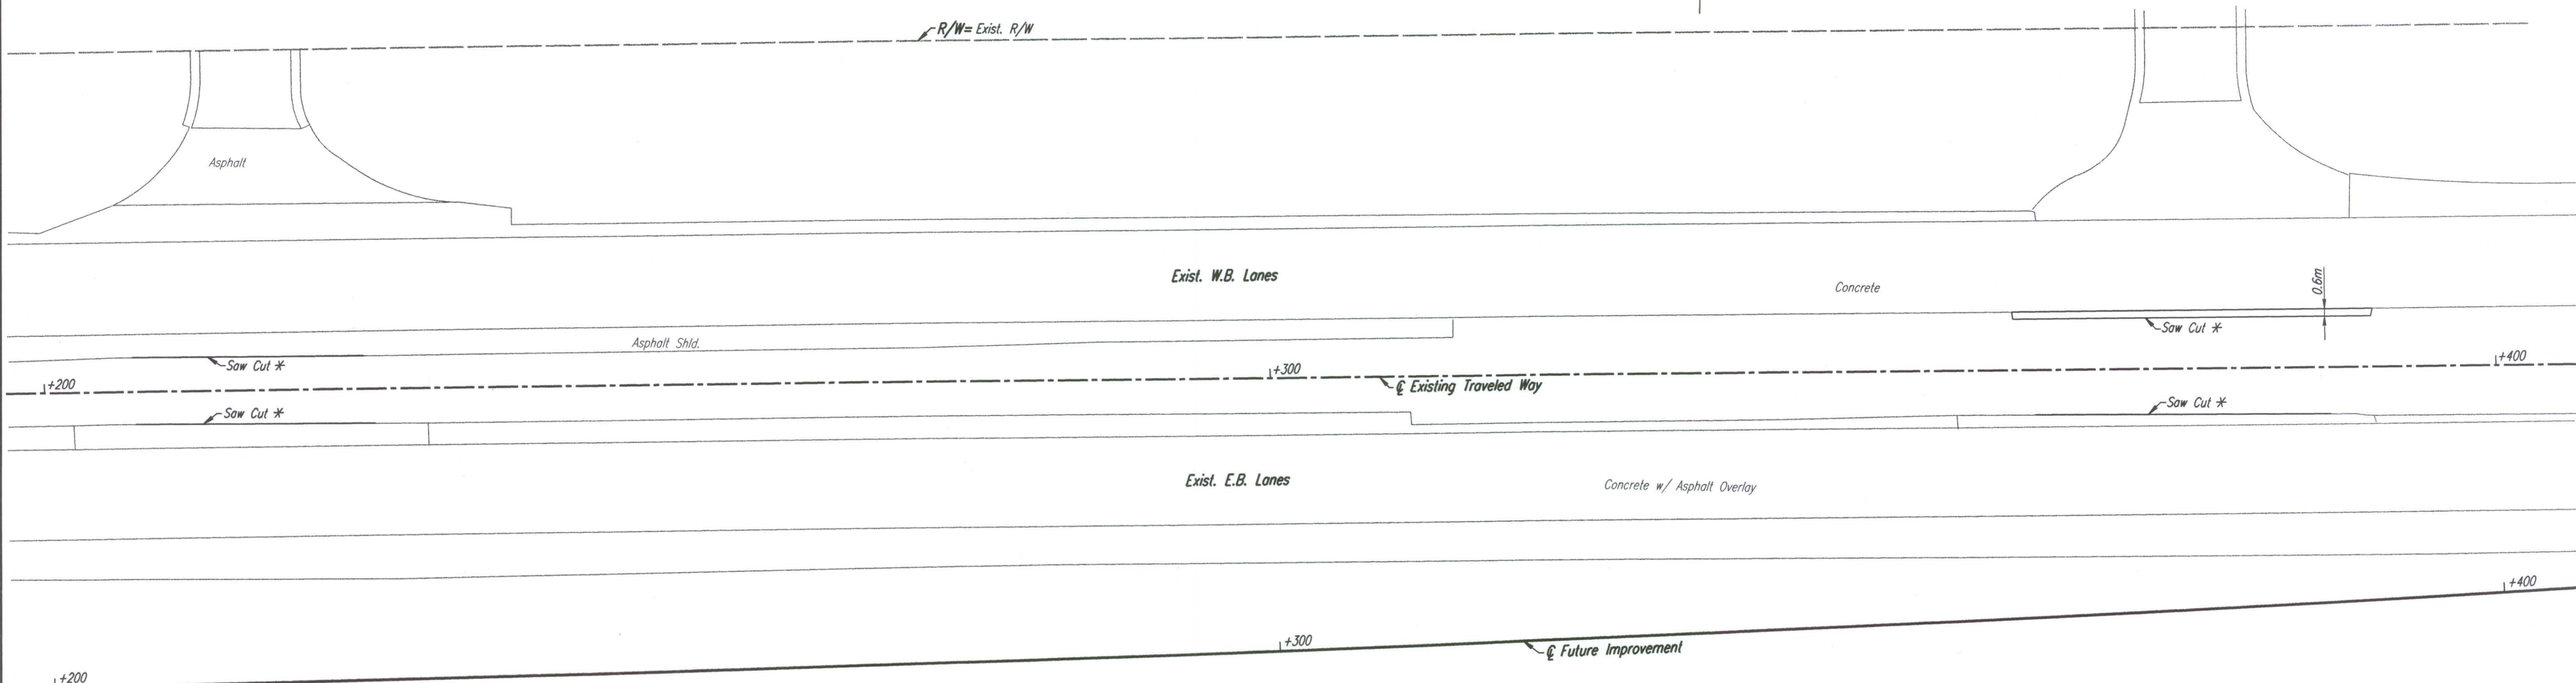

- CONCRETE PAVEMENT JOINT TYPES:**
- A) CONTRACTION JOINT with #16 x 600mm DEFORMED TIE BARS & SAWN.
 - B) CONSTRUCTION JOINT with #16 x 600mm DEFORMED TIE BARS ONLY.
 - C) CONSTRUCTION JOINT: KEYWAY ONLY.
 - D) CONSTRUCTION JOINT with KEYWAY & #16 x 600mm DEFORMED TIE BARS.
 - E) CONTRACTION JOINT with SMOOTH DOWEL BARS:
 - 1) 200mm PCCP = 25mm x 450mm.
 - 2) 260mm PCCP = 32mm x 450mm.
 - F) CONSTRUCTION JOINT: NON-TIED.
 - G) CONSTRUCTION JOINT along curb & gutter with #16 x 900mm EPOXY COATED DEFORMED TIE BARS.
 - H) CONSTRUCTION JOINT with SMOOTH DOWEL BARS:
 - 1) 200mm PCCP = 25mm x 450mm.
 - 2) 260mm PCCP = 32mm x 450mm.
 - I) CONTRACTION JOINT (mainline outside shoulder only) with 2-#16 continuous epoxy deformed bars left uncured & SAWN.
 - J) CONSTRUCTION JOINT (outside shoulder) with 2-#16 continuous epoxy deformed bars.
 - K) CONTRACTION JOINT (inside or outside shoulder) NON-TIED & SAWN.
 - L) EXPANSION JOINT (19mm).
 - M) CONSTRUCTION JOINT along curb/gutter with KEYWAY & #16 x 900mm TIE BARS.
- * Saw cut to a neat line at median crossover locations.

DSNR: WDH OPER: JGP SCALE: 1:250
 i:/1997/97362/PAVING/PAV142.DGN 1-31-2001 11:16:32 LAST REV: 12-31-01 BY: JGP

Revisions		By	Date
CITY OF WICHITA			
PAVING PLAN			
STA. 14+200 TO STA. 14+400			
SEDGWICK COUNTY			
Professional Engineering Consultants, P.A. 303 S. TOPKA • WICHITA, KANSAS 67202 316-262-2691 • FAX 316-262-3003			
Designed by	WDH	Checked by	WDH
Drawn by	JGP	Date	Apr 11, 2002
		Job No.	97362