


- CONCRETE PAVEMENT JOINT TYPES:**
- A) CONTRACTION JOINT with #16 x 600mm DEFORMED TIE BARS & SAWN.
 - B) CONTRACTION JOINT with #16 x 600mm DEFORMED TIE BARS ONLY.
 - C) CONSTRUCTION JOINT: KEYWAY ONLY.
 - D) CONSTRUCTION JOINT with KEYWAY & #16 x 600mm DEFORMED TIE BARS.
- CONCRETE PAVEMENT JOINT TYPES:**
- E) CONTRACTION JOINT with SMOOTH DOWEL BARS:
 - 1) 200mm PCCP = 25mm x 450mm.
 - 2) 260mm PCCP = 32mm x 450mm.
 - F) CONSTRUCTION JOINT: NON-TIED.
 - G) CONSTRUCTION JOINT along curb & gutter with #16 x 900mm EPOXY COATED DEFORMED TIE BARS.
- CONCRETE PAVEMENT JOINT TYPES:**
- H) CONSTRUCTION JOINT with SMOOTH DOWEL BARS:
 - 1) 200mm PCCP = 25mm x 450mm.
 - 2) 260mm PCCP = 32mm x 450mm.
 - I) CONTRACTION JOINT (mainline outside shoulder only) with 2-#16 continuous epoxy deformed bars left uncured & SAWN.
- CONCRETE PAVEMENT JOINT TYPES:**
- J) CONSTRUCTION JOINT (outside shoulder) with 2-#16 continuous epoxy deformed bars.
 - K) CONTRACTION JOINT (inside or outside shoulder) NON-TIED & SAWN.
 - L) EXPANSION JOINT (19mm).
 - M) CONSTRUCTION JOINT along curb/gutter with KEYWAY & #16 x 900mm TIE BARS.

DATE	
BY	
REFERENCES NOTED	
REFERENCES CHECKED	

BY: JGP

1-2-02

DSNR: WDH OPER: JGP SCALE: 1:250
 I:1997/97362/PAVING/PAV158.DGN 2-20-2001 10:40:46 LAST REV: 1-2-02

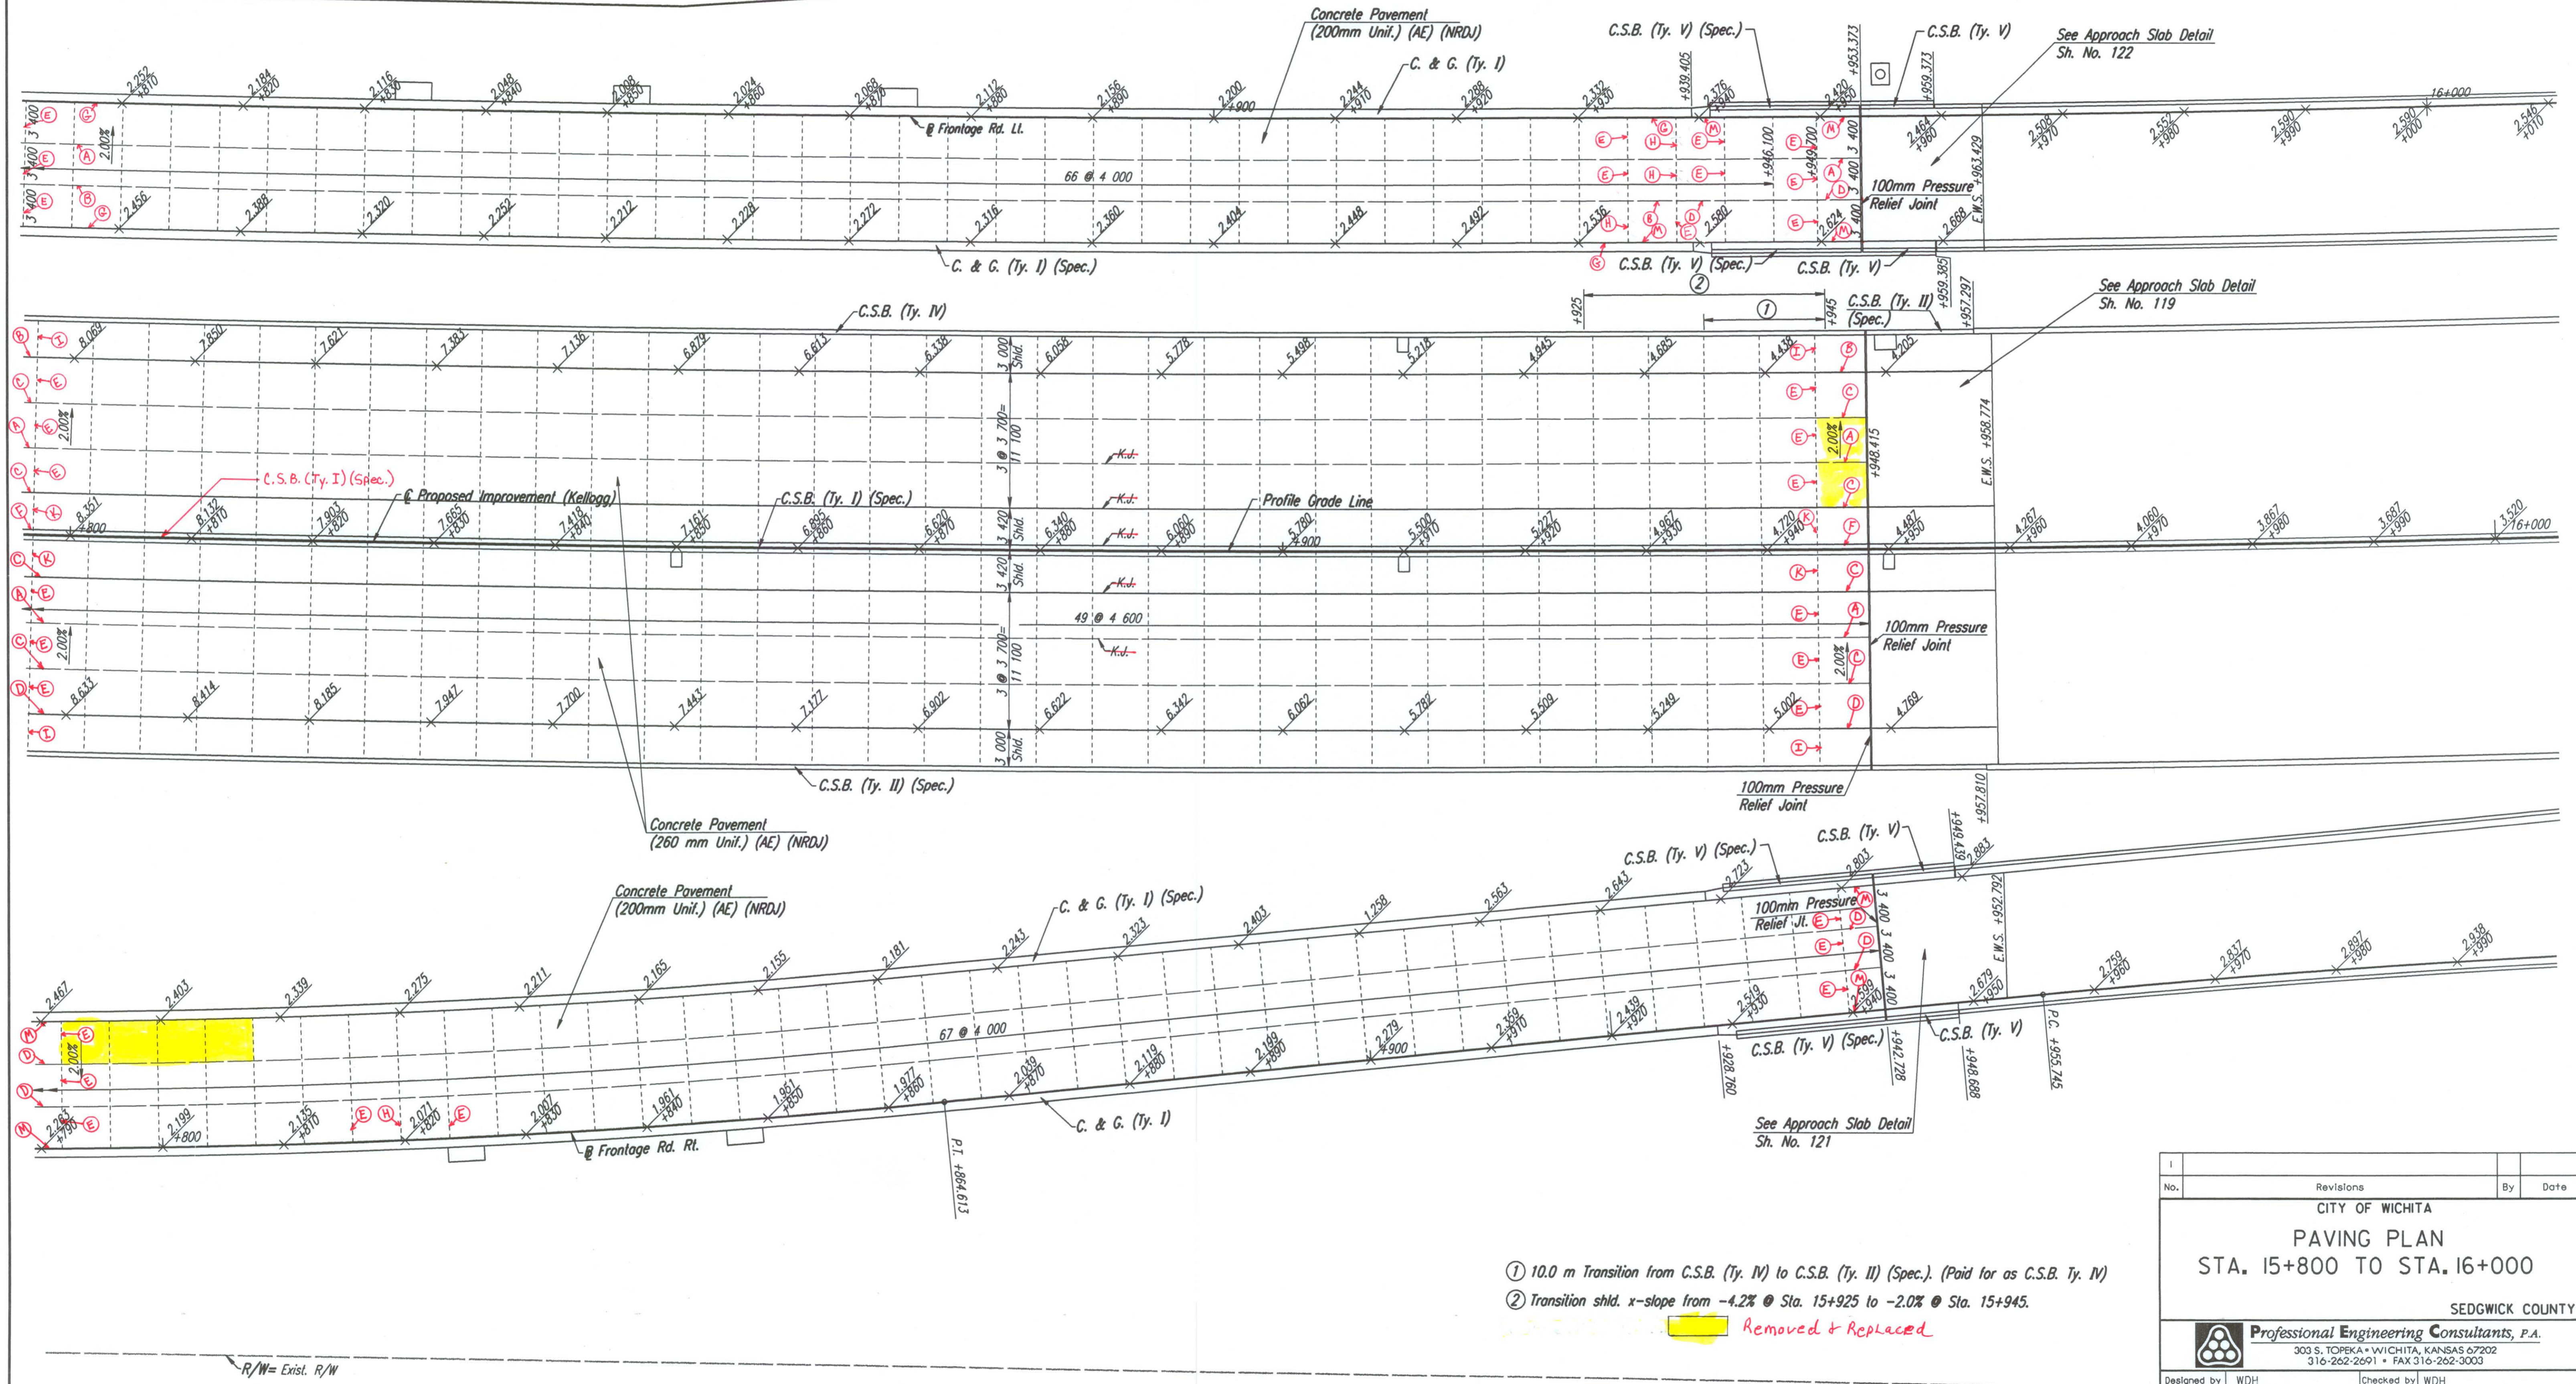

- ① 10.0 m Transition from C.S.B. (Ty. IV) to C.S.B. (Ty. II) (Spec.). (Paid for as C.S.B. Ty. IV)
- ② Transition shld. x-slope from -4.2% @ Sta. 15+925 to -2.0% @ Sta. 15+945.

Removed + Replaced

No.	Revisions	By	Date
CITY OF WICHITA PAVING PLAN STA. 15+800 TO STA. 16+000 SEDGWICK COUNTY			
Professional Engineering Consultants, P.A. <small>303 S. TOPEKA • WICHITA, KANSAS 67202 316-262-2691 • FAX 316-262-3003</small>			
Designed by	WDH	Checked by	WDH
Drawn by	JGP	Date	Apr 11, 2002
		Job No.	97362