


DATE	
BY	
REFERENCES NOTED	
REFERENCES CHECKED	

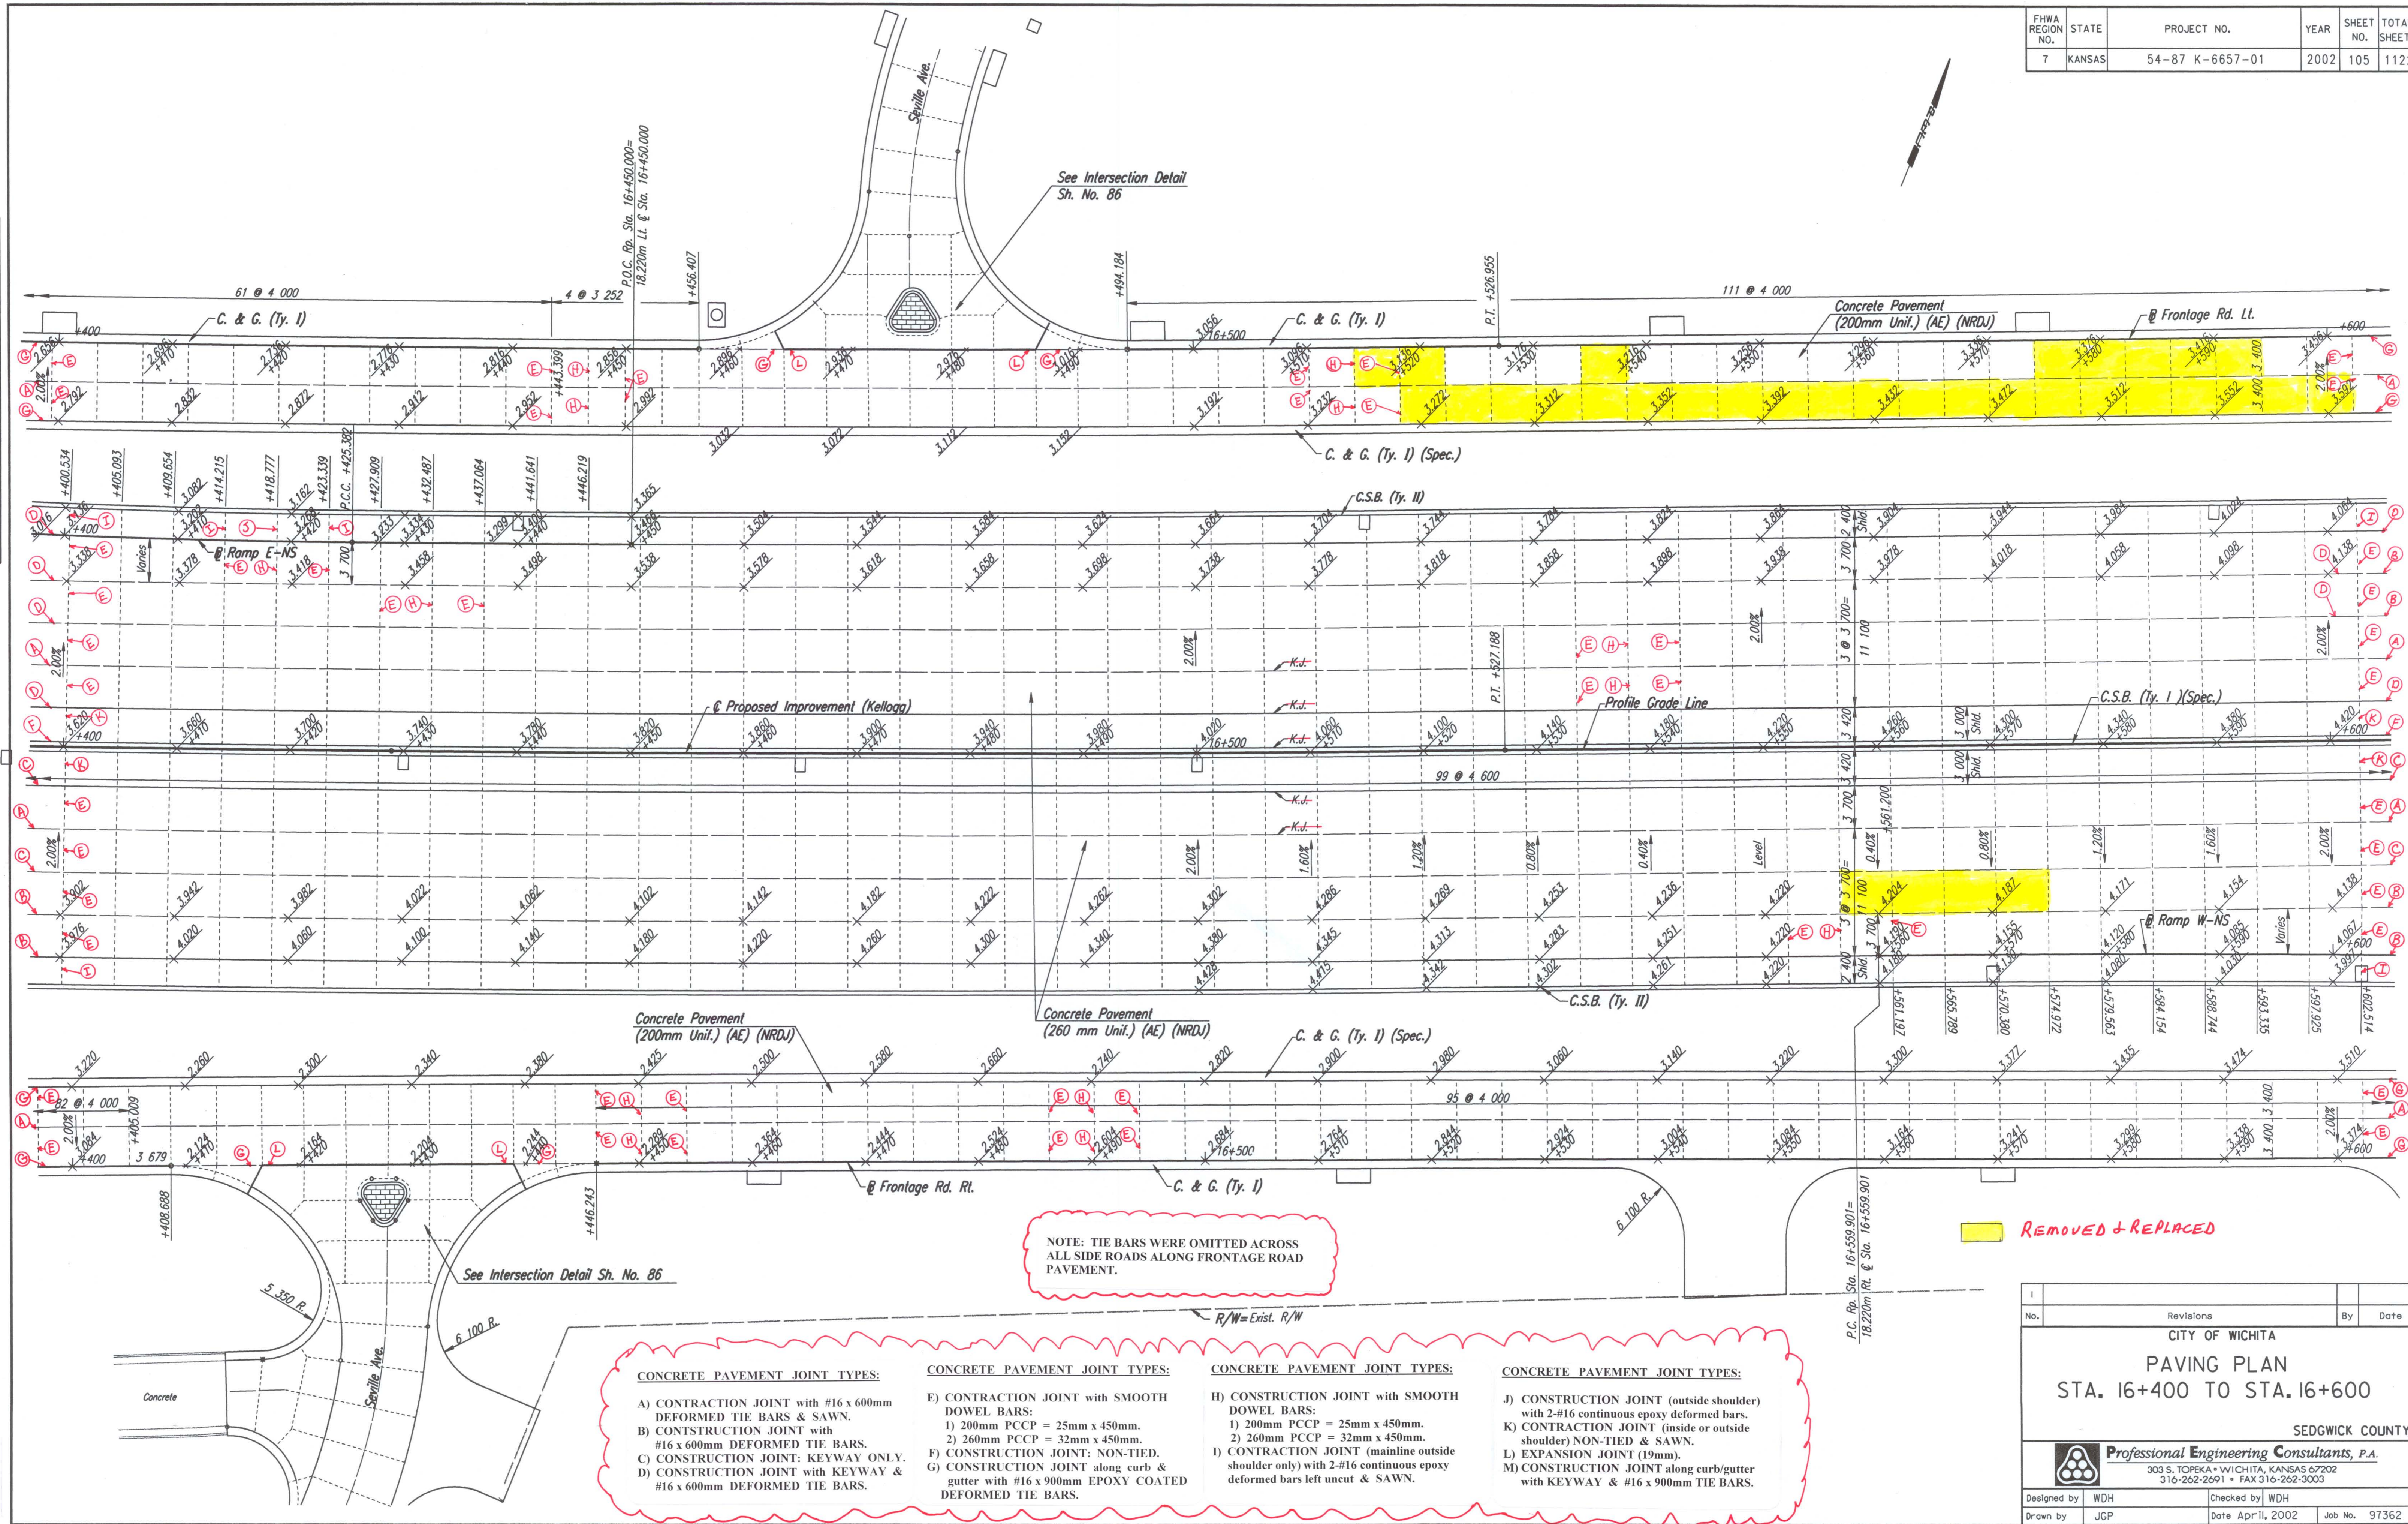

DSNR: WDH OPER: JGP SCALE: 1:250  
 i:/1997/97362/PAVING/PAV164.DGN 2-20-2001 14:19:39 LAST REV: 11-20-01 BY: JGP

- |   |  |   |  |
|---|--|---|--|
| <p><b>CONCRETE PAVEMENT JOINT TYPES:</b></p> <p>A) CONTRACTION JOINT with #16 x 600mm DEFORMED TIE BARS &amp; SAWN.</p> <p>B) CONSTRUCTION JOINT with #16 x 600mm DEFORMED TIE BARS.</p> <p>C) CONSTRUCTION JOINT: KEYWAY ONLY.</p> <p>D) CONSTRUCTION JOINT with KEYWAY &amp; #16 x 600mm DEFORMED TIE BARS.</p> | <p><b>CONCRETE PAVEMENT JOINT TYPES:</b></p> <p>E) CONTRACTION JOINT with SMOOTH DOWEL BARS:<br/>         1) 200mm PCCP = 25mm x 450mm.<br/>         2) 260mm PCCP = 32mm x 450mm.</p> <p>F) CONSTRUCTION JOINT: NON-TIED.</p> <p>G) CONSTRUCTION JOINT along curb &amp; gutter with #16 x 900mm EPOXY COATED DEFORMED TIE BARS.</p> | <p><b>CONCRETE PAVEMENT JOINT TYPES:</b></p> <p>H) CONSTRUCTION JOINT with SMOOTH DOWEL BARS:<br/>         1) 200mm PCCP = 25mm x 450mm.<br/>         2) 260mm PCCP = 32mm x 450mm.</p> <p>I) CONTRACTION JOINT (mainline outside shoulder only) with 2-#16 continuous epoxy deformed bars left uncut &amp; SAWN.</p> | <p><b>CONCRETE PAVEMENT JOINT TYPES:</b></p> <p>J) CONSTRUCTION JOINT (outside shoulder) with 2-#16 continuous epoxy deformed bars.</p> <p>K) CONTRACTION JOINT (inside or outside shoulder) NON-TIED &amp; SAWN.</p> <p>L) EXPANSION JOINT (19mm).</p> <p>M) CONSTRUCTION JOINT along curb/gutter with KEYWAY &amp; #16 x 900mm TIE BARS.</p> |
|---|--|---|--|

REMOVED & REPLACED

No.	Revisions	By	Date
CITY OF WICHITA <b>PAVING PLAN</b> STA. 16+400 TO STA. 16+600 SEDGWICK COUNTY			
<b>Professional Engineering Consultants, P.A.</b> 303 S. TOPEKA • WICHITA, KANSAS 67202 316-262-2691 • FAX 316-262-3003			
Designed by	WDH	Checked by	WDH
Drawn by	JGP	Date	April, 2002
		Job No.	97362