



| FHWA REGION NO. | STATE | PROJECT NO. | YEAR | SHEET NO. | TOTAL SHEETS |
|-----------------|--------|-----------------------|------|-----------|--------------|
| 7 | KANSAS | 54 - 87 K - 6657 - 01 | 2002 | 663A | 1122 |

West Kellogg Freeway – Maize and Tyler Road Interchanges


City of Wichita Project Number: 472 - 83533

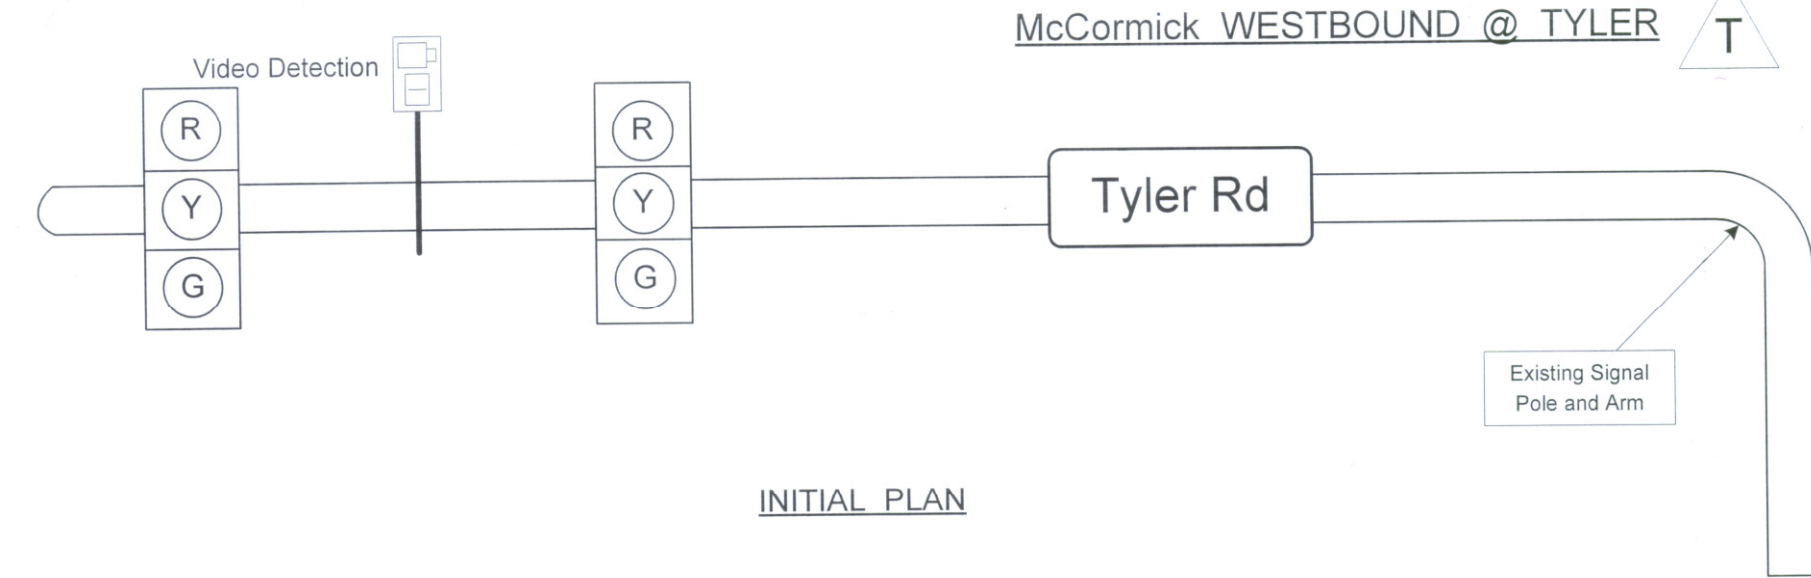

See Sheet # 663.

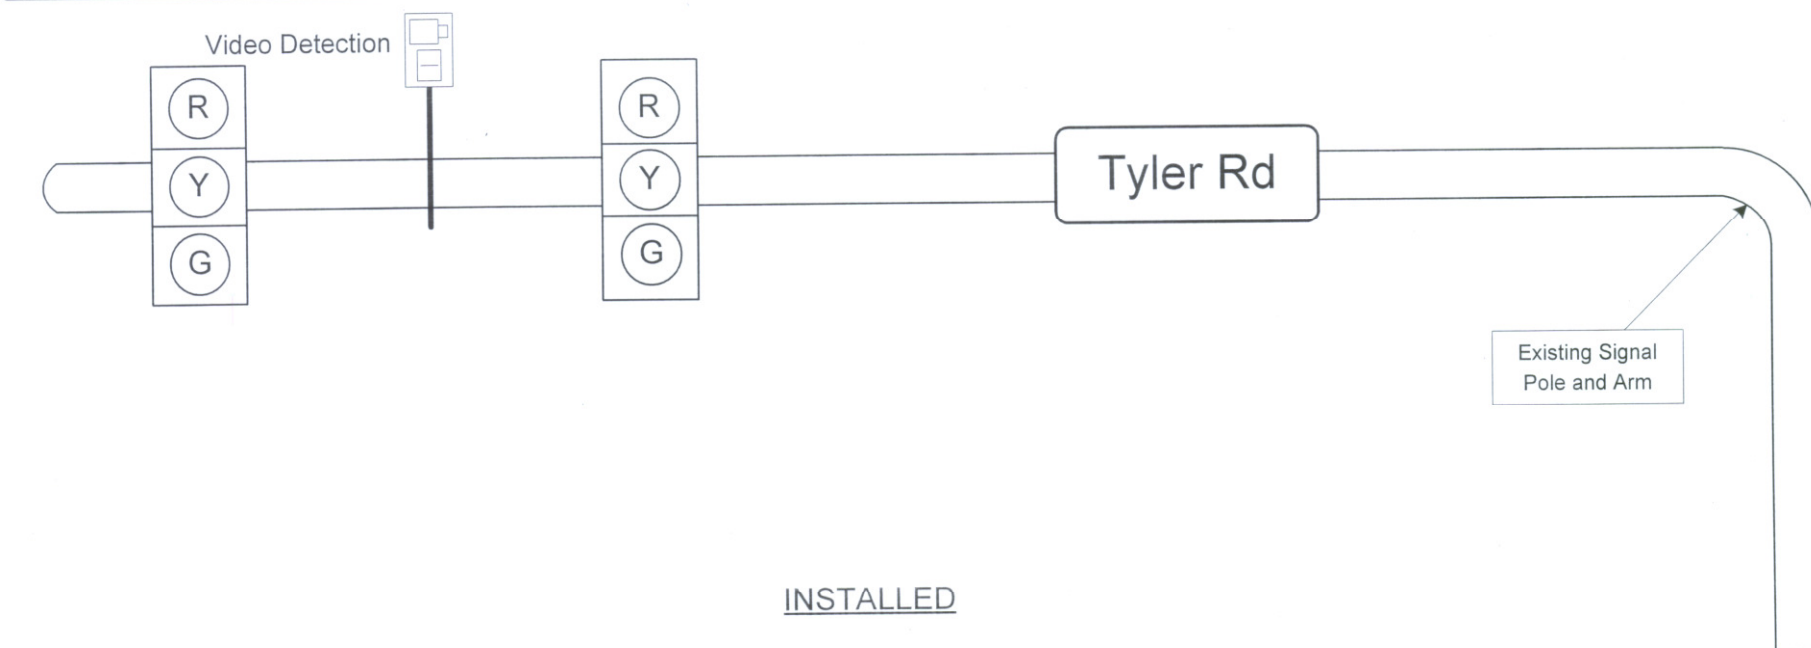

H: / Common / West Kellogg Freeway / Visio / Traffic Signals / McCormick @ Tyler

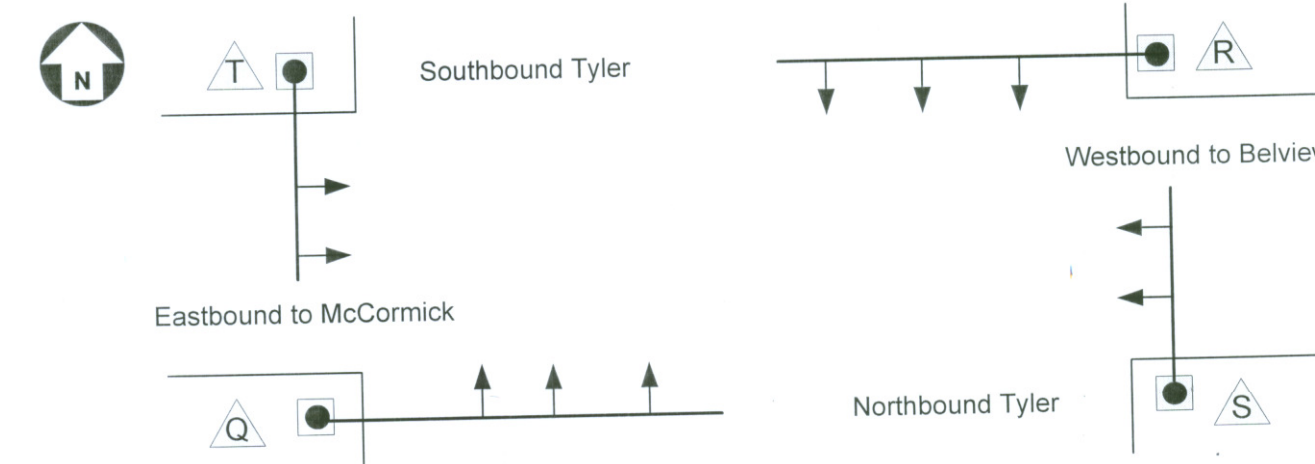


Tyler Road at McCormick/Belview Traffic Signal Location Plan


H: / Common / West Kellogg Freeway / Visio / Traffic Signals / Schematic

West Kellogg Freeway – Maize and Tyler Road Interchanges

City of Wichita Project Number: 472 - 83533

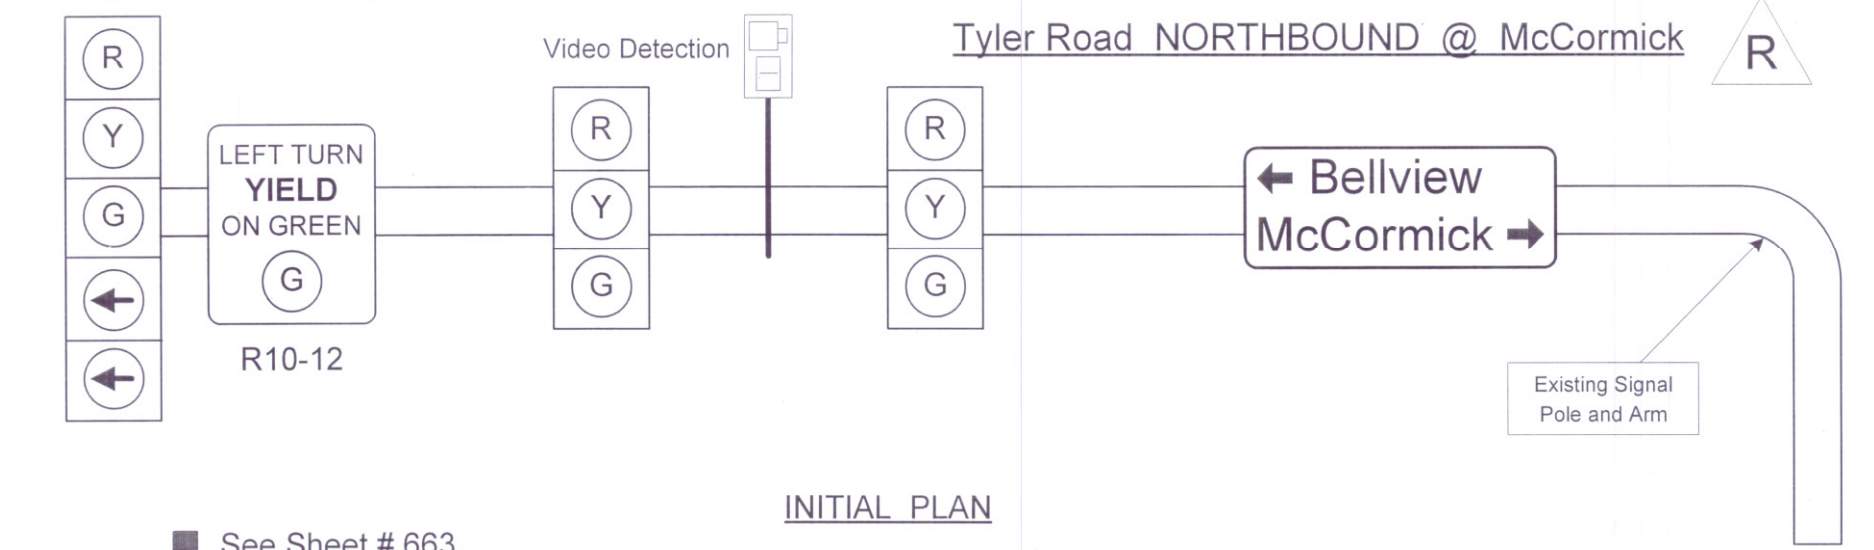


See Sheet # 663.

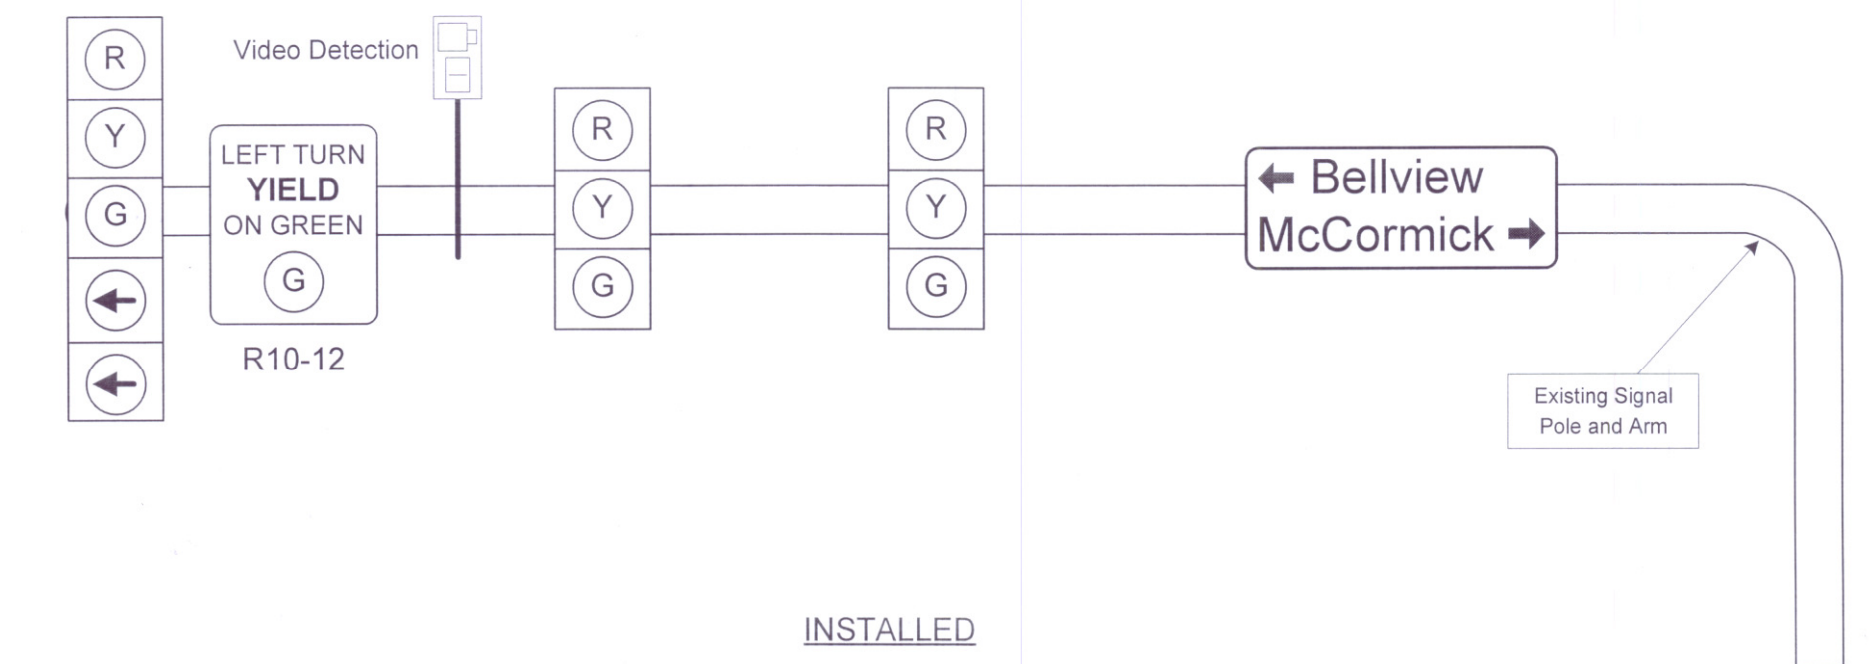


H: / Common / West Kellogg Freeway / Visio / Traffic Signals / Tyler @ McCormick

West Kellogg Freeway – Maize and Tyler Road Interchanges

City of Wichita Project Number: 472 - 83533

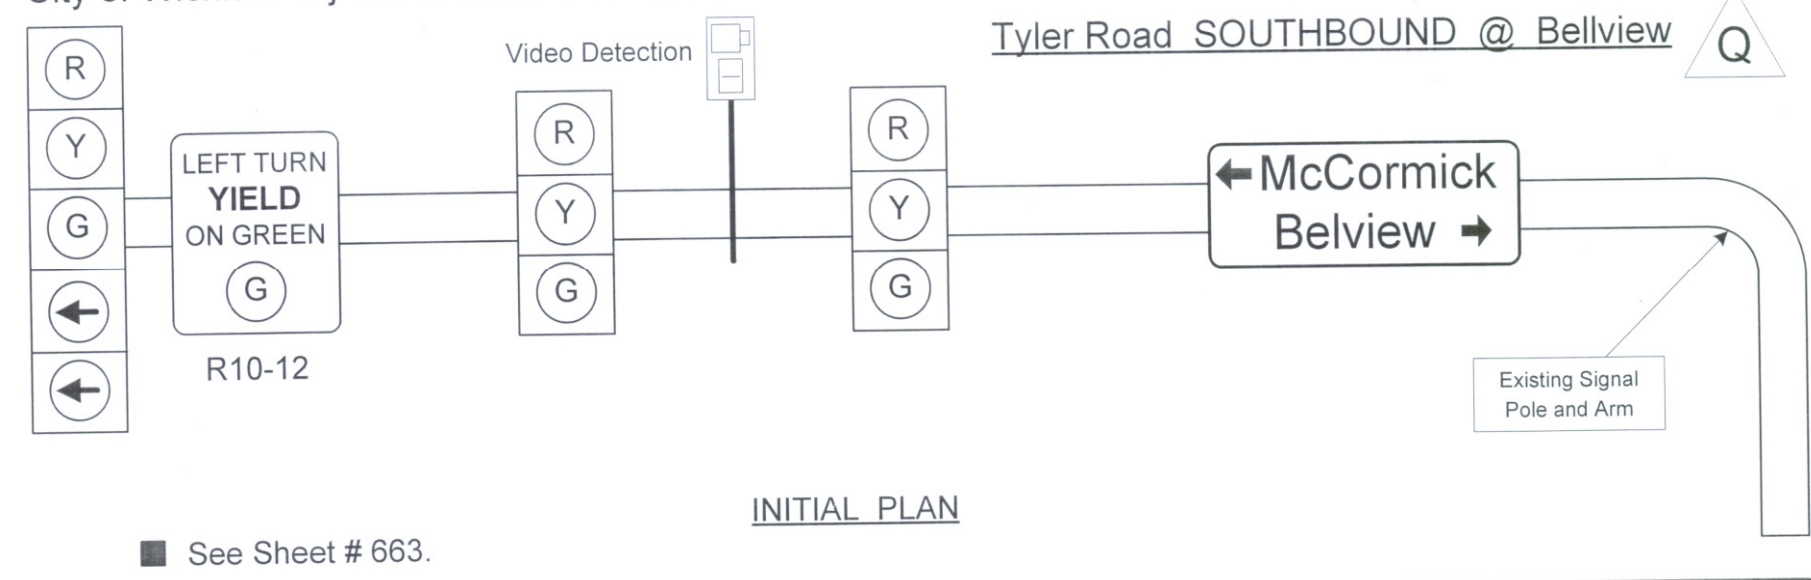


See Sheet # 663.

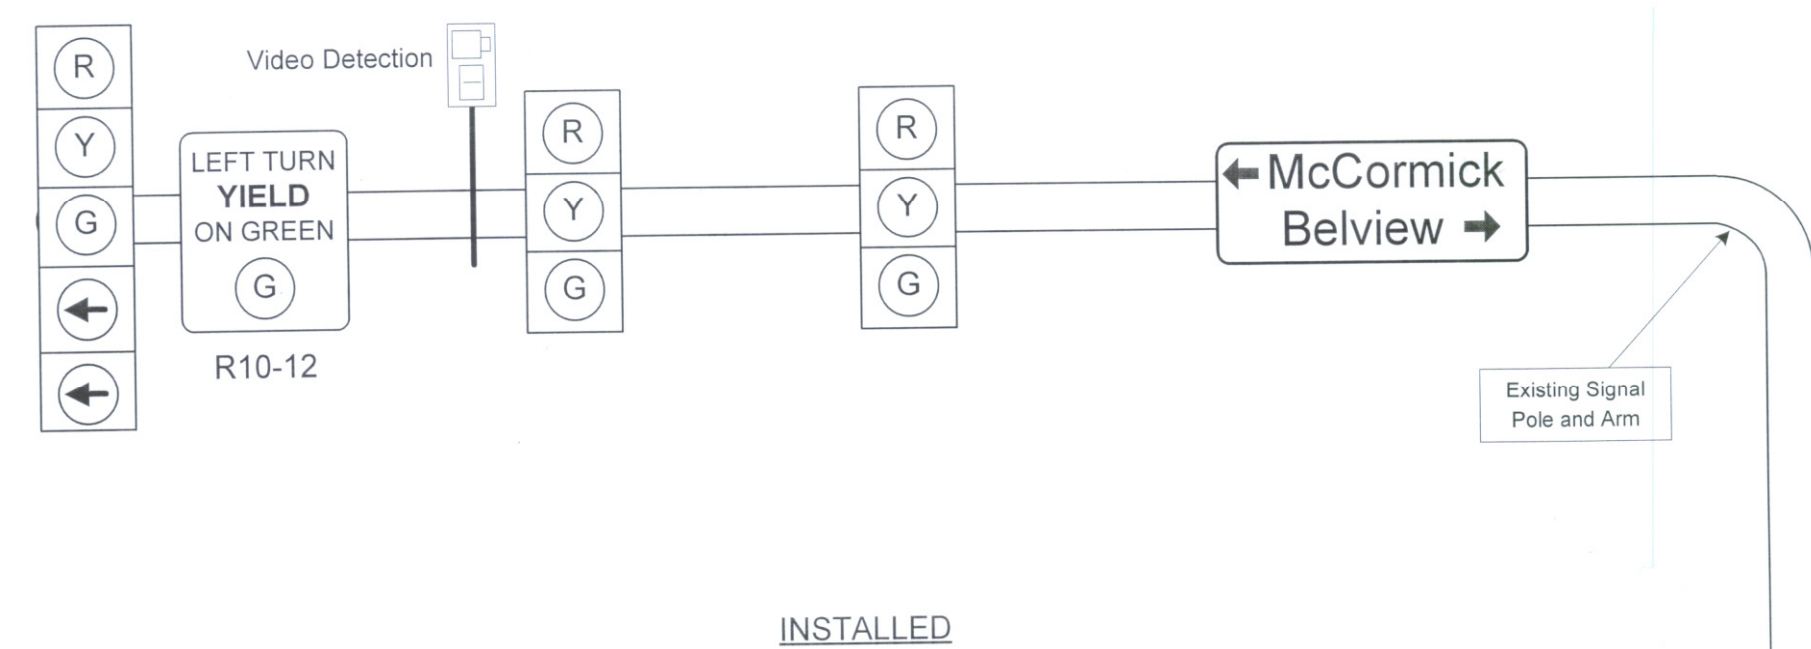


H: / Common / West Kellogg Freeway / Visio / Traffic Signals / Tyler @ Bellview

West Kellogg Freeway – Maize and Tyler Road Interchanges

City of Wichita Project Number: 472 - 83533

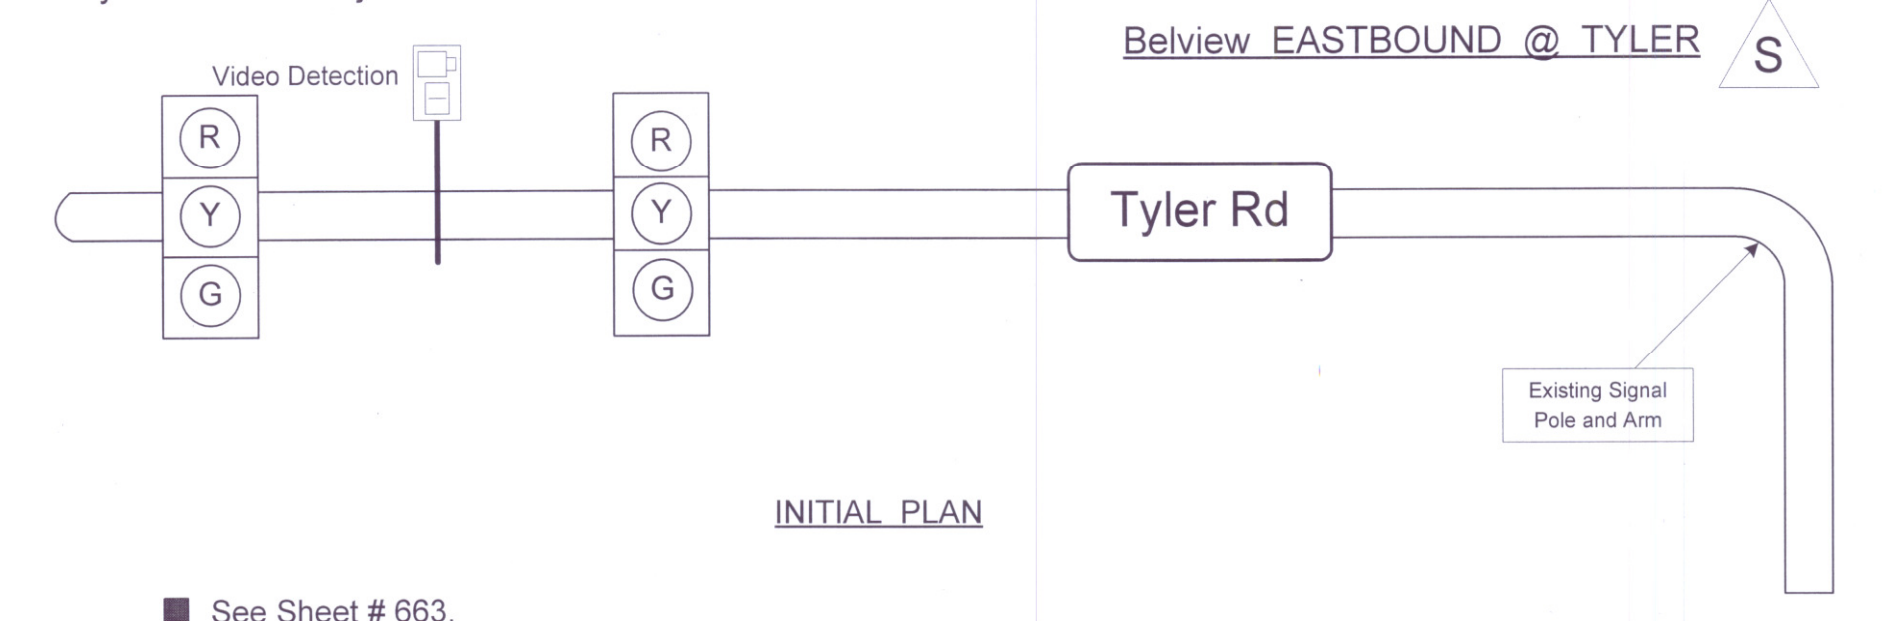

See Sheet # 663.

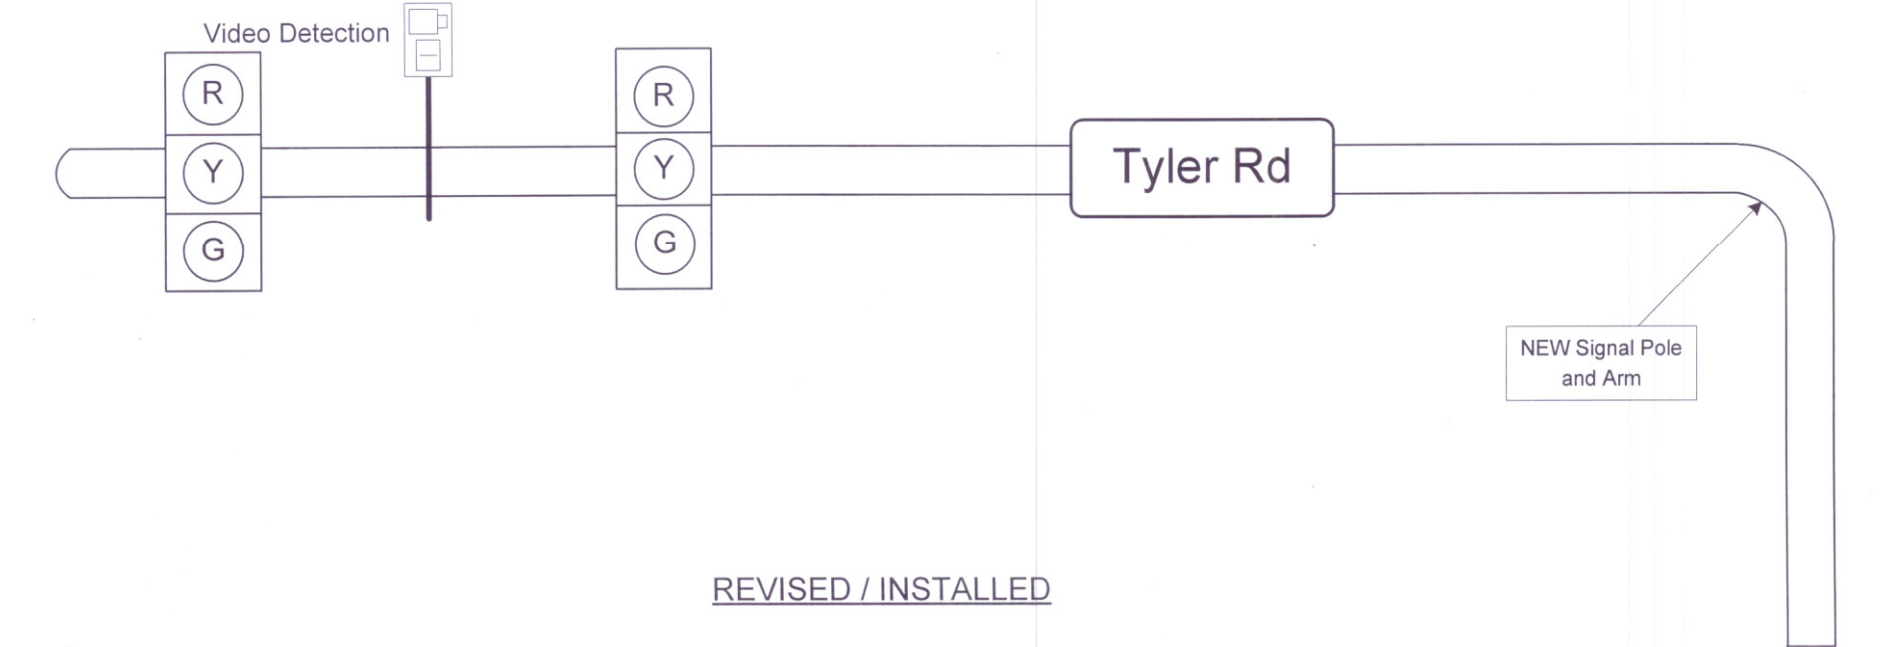

H: / Common / West Kellogg Freeway / Visio / Traffic Signals / Bellview @ Tyler