FHWA REG NO.	STATE	PROJECT NO.	YEAR	SHEET NO.	TOTAL SHEETS
7	KANSAS	54-87 K-6657-01	2002	1114	1122

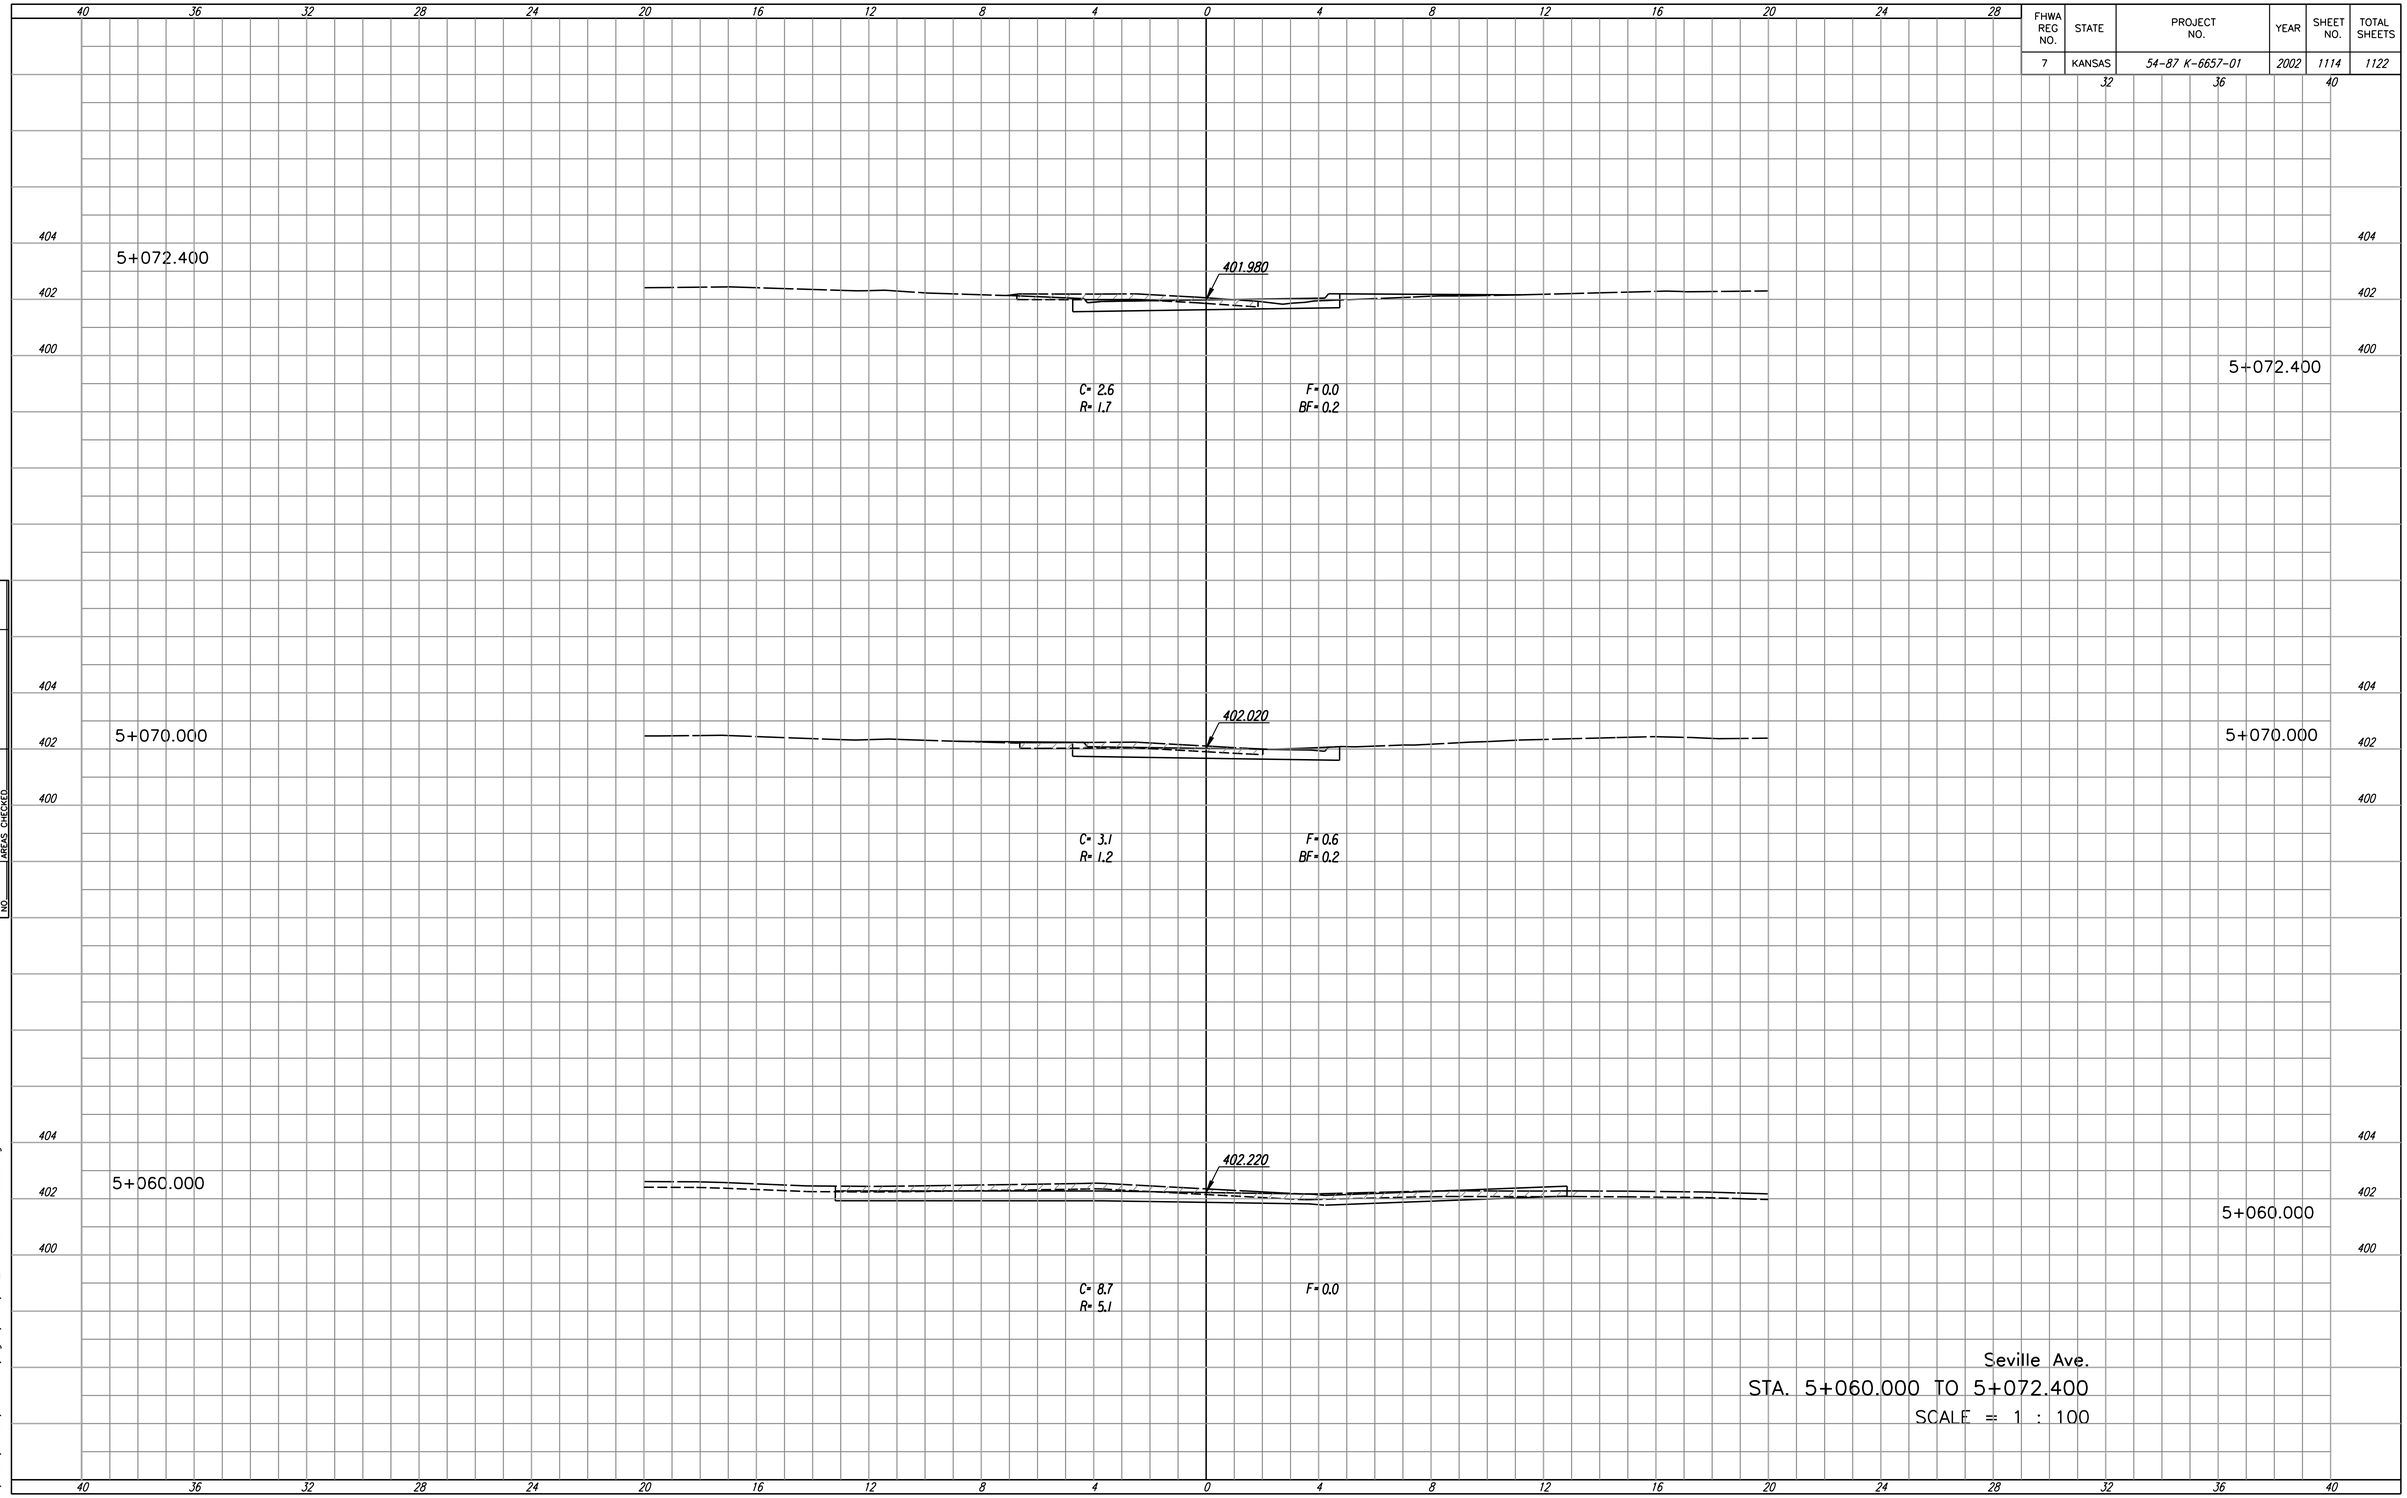

FINAL SURVEY		BY	DATE
	SURVEYED		
	PLOTTED		
NOTE BOOK	PLANIMETER AREAS		
NO.	AREAS CHECKED		

DSNR: RHM OPER: SCALE: 1:100
I:/1997/97062/As-Builts/dgn's/Vol.5/Sht_1114-Seville-XS5060.dgn