


NOTE: PROTECT TREES FROM DAMAGE UNLESS INDICATED FOR REMOVAL. COORDINATE WITH ENGINEER IF EXTRA REMOVAL IS REQUIRED. TREE REMOVAL SHALL BE INCIDENTAL TO BID ITEM FOR SITE CLEARING AND RESTORATION.



SCALE 1" = 40'
IRON = •

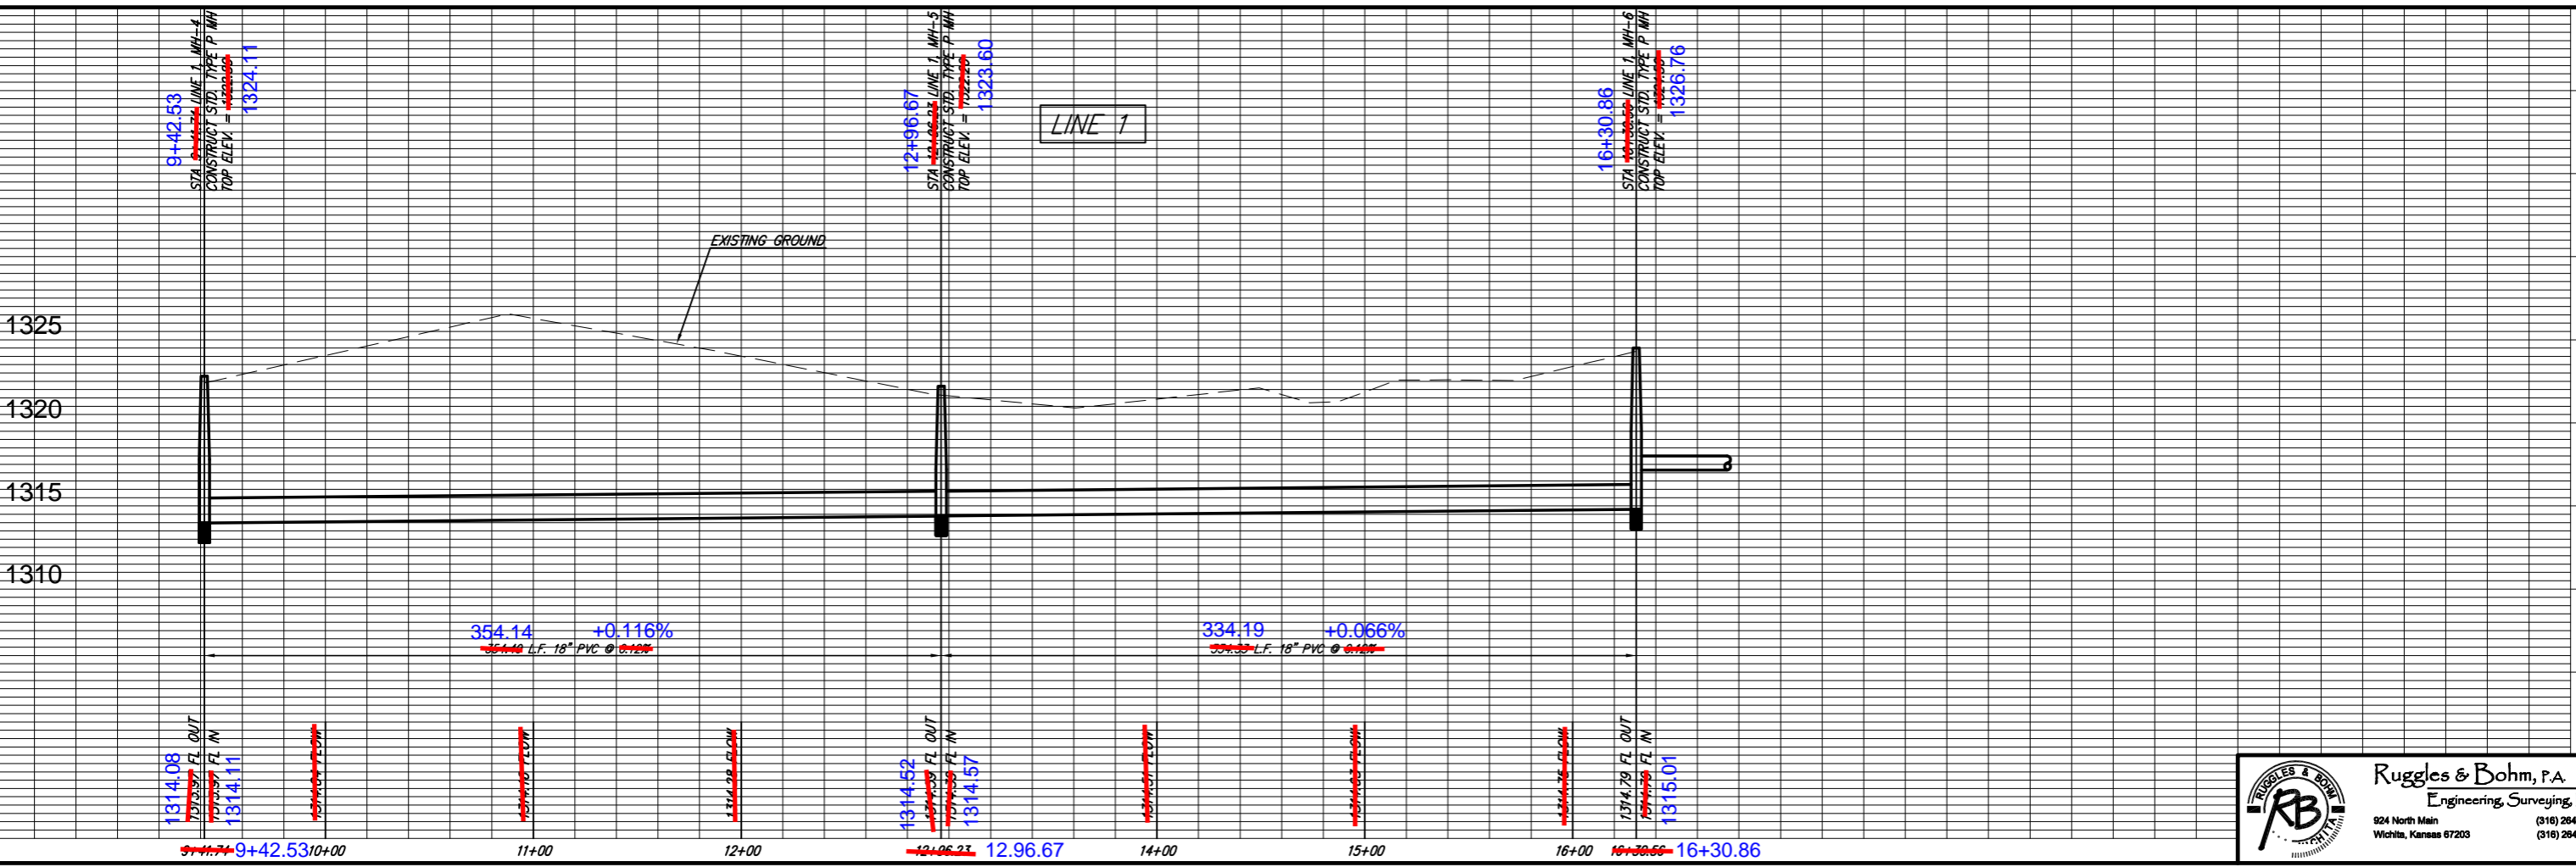

PROJECT NUMBER 468-84141	DESIGN AML	DRAWN MLP	REVIEW MLP
DRAWING FILE Sanitary Sewer ISS 02J	UTILITY	DATE Jan. 3, 2006	REVIEW
MAIN 23, SOUTHWEST INTECEPTOR Gravity Sewer Main			
1325			
1320			
1315			
1310			

Ruggles & Bohm, P.A.
Engineering, Surveying, Land Planning

924 North Main
Wichita, Kansas 67203

(316) 264-8008
(316) 264-4821 fax

RB JOB
2822E
SHE
3
OF
16