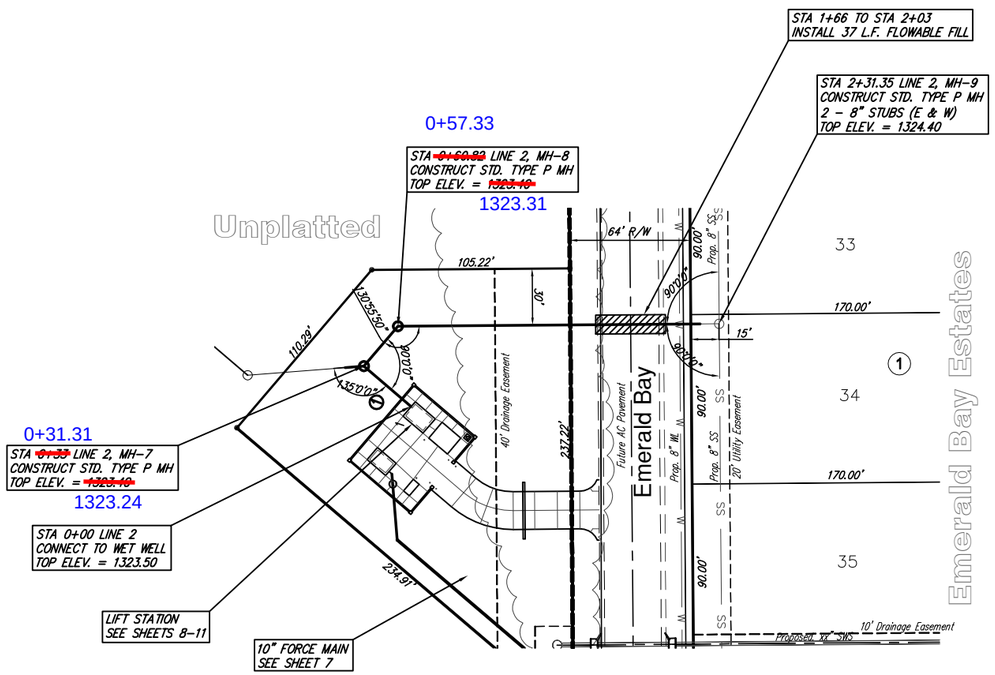

SCALE 1" = 40'
IRON = •

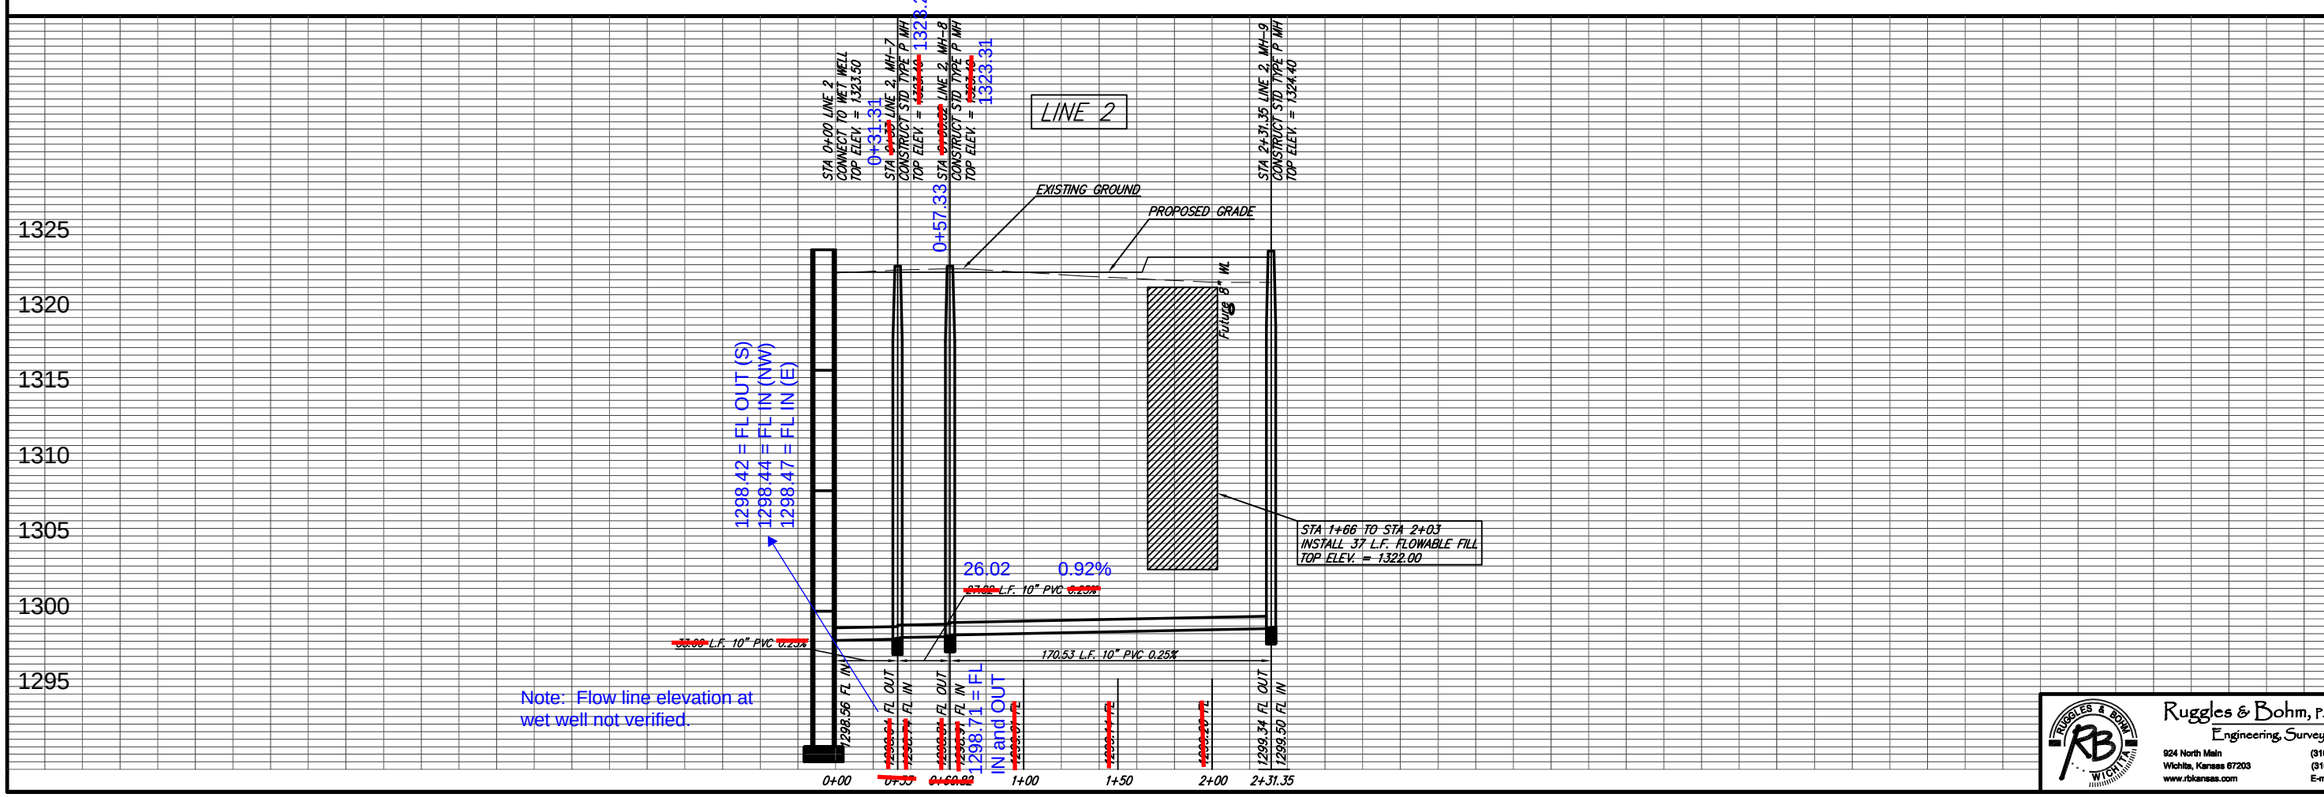

DESIGN	DRAWN
AML	MLP
UTILITY	DATE
	Jan. 5, 2006
REVISED	REVIEW
	.

PROJECT NUMBER XXX-XXXXX

DRAWING FILE Sanitary Sewer [SS 03]

Emerald Bay Estates Addition
Sanitary Sewer
WICHITA, KANSAS

Ruggles & Bohm, P.A.
Engineering, Surveying, Land Planning
924 North Main
Wichita, Kansas 67203
www.rbkansas.com
(316) 264-8006
(316) 264-4621 fax
E-mail: info@rbkansas.com

RB JOB 2822E

SHEET 4 OF 15