SEE REVISED SHEET

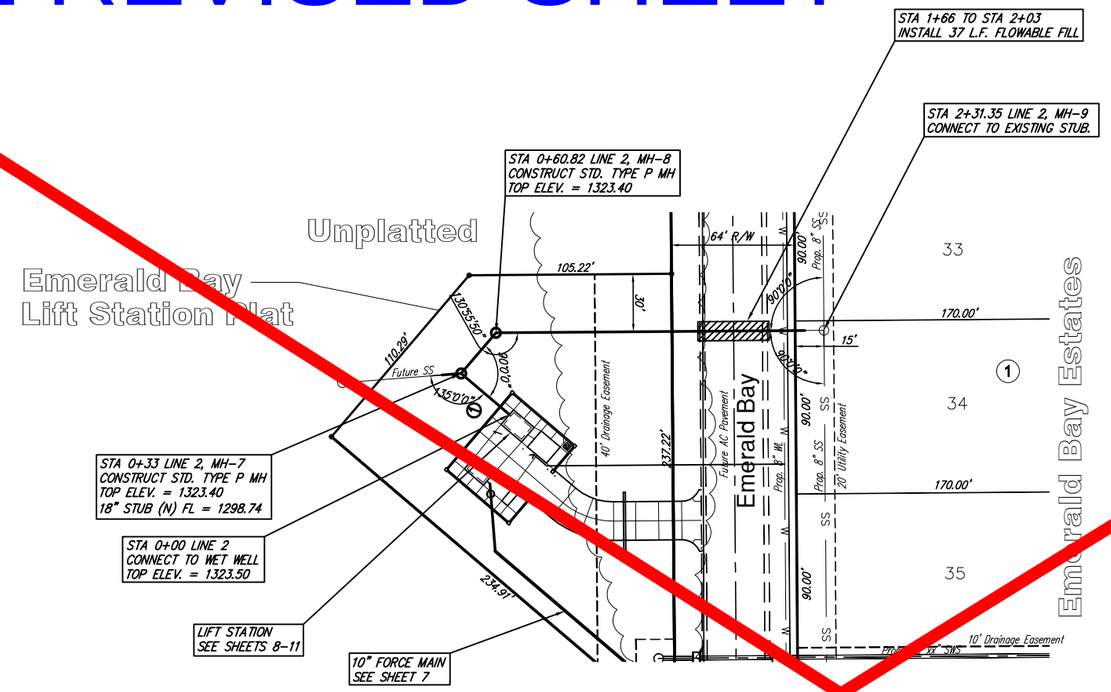

SCALE 1" = 40'
IRON = ●

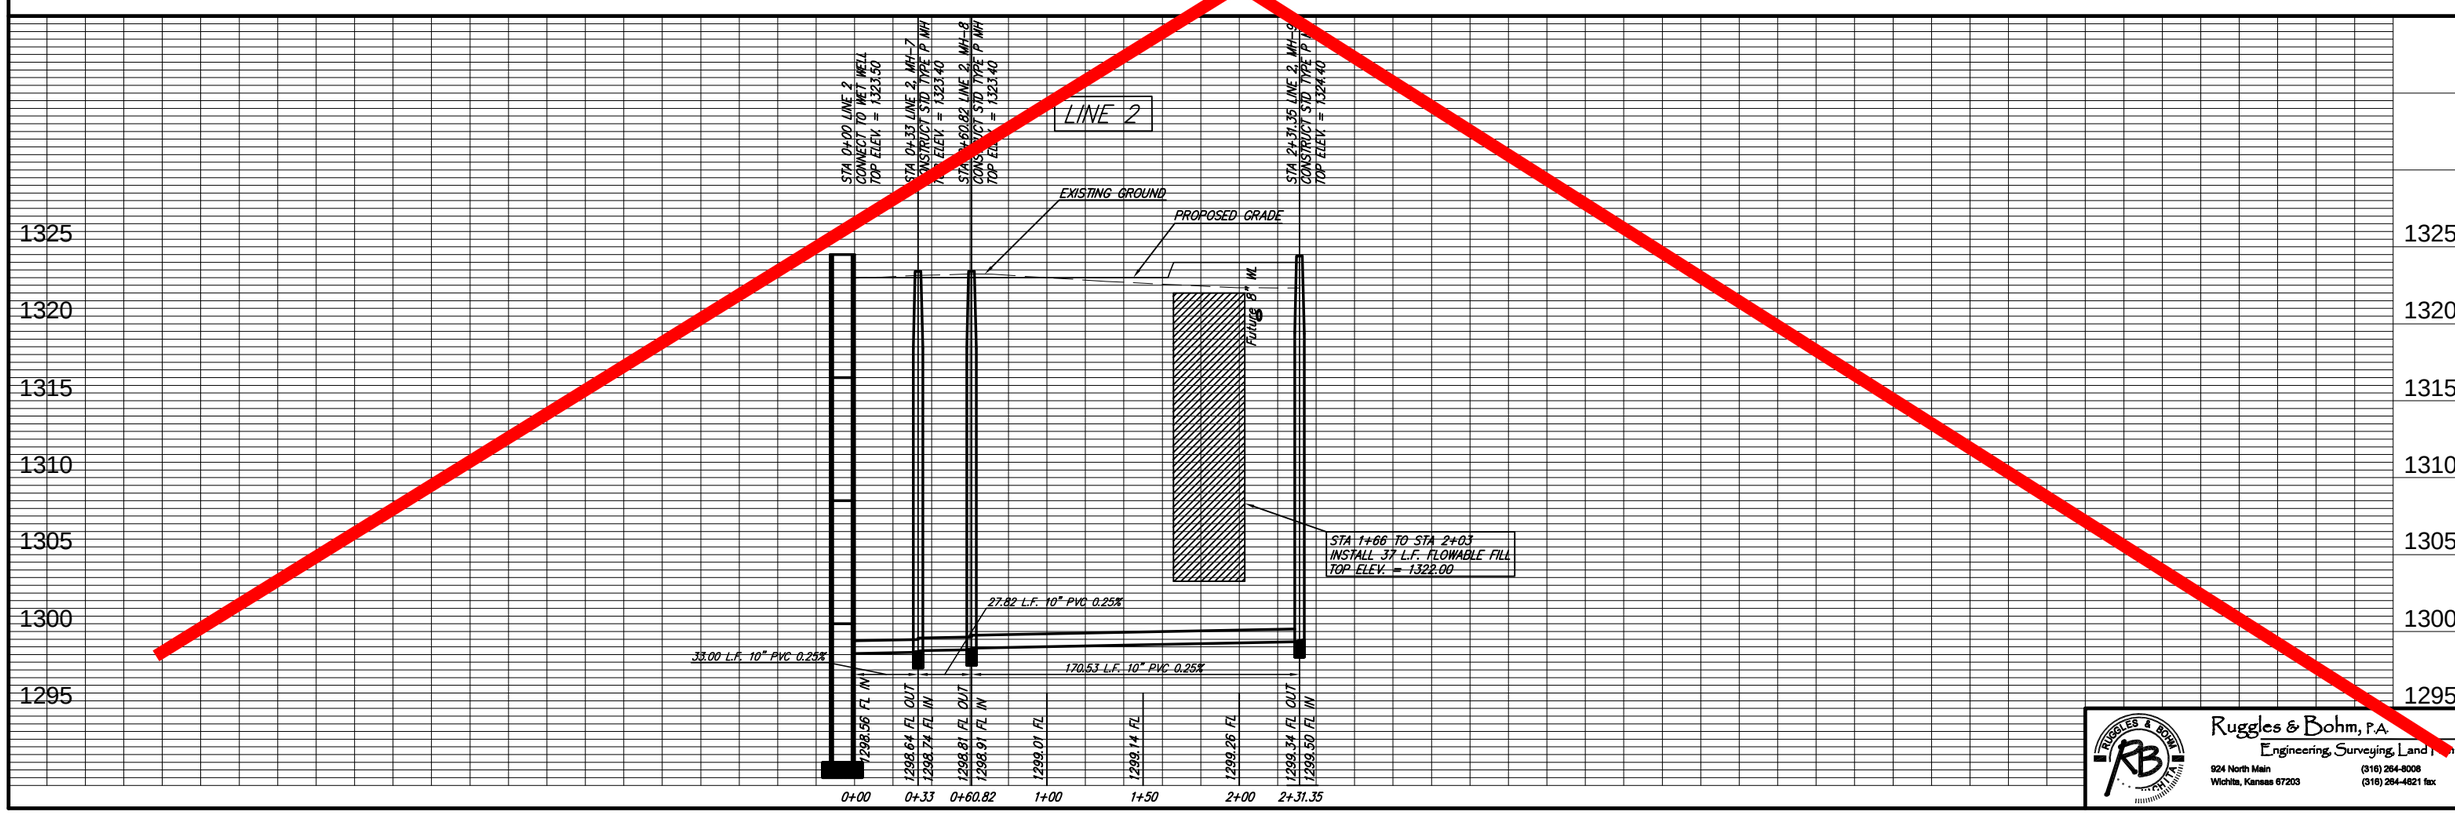

DESIGN AML
DRAWN MLP
DATE Jan. 5, 2006
REVISED
REVIEW
UTILITY

PROJECT NUMBER 468-84141
DRAWING FILE Sanitary Sewer {SS 03}

MAIN 23, SOUTHWEST INTECEPTOR
Gravity Sewer Main

Ruggles & Bohm, P.A.
Engineering, Surveying, Land Planning
924 North Main
Wichita, Kansas 67203
(316) 264-8006
(316) 264-4621 fax

RB JOB 2822E
SHT 4 of 16