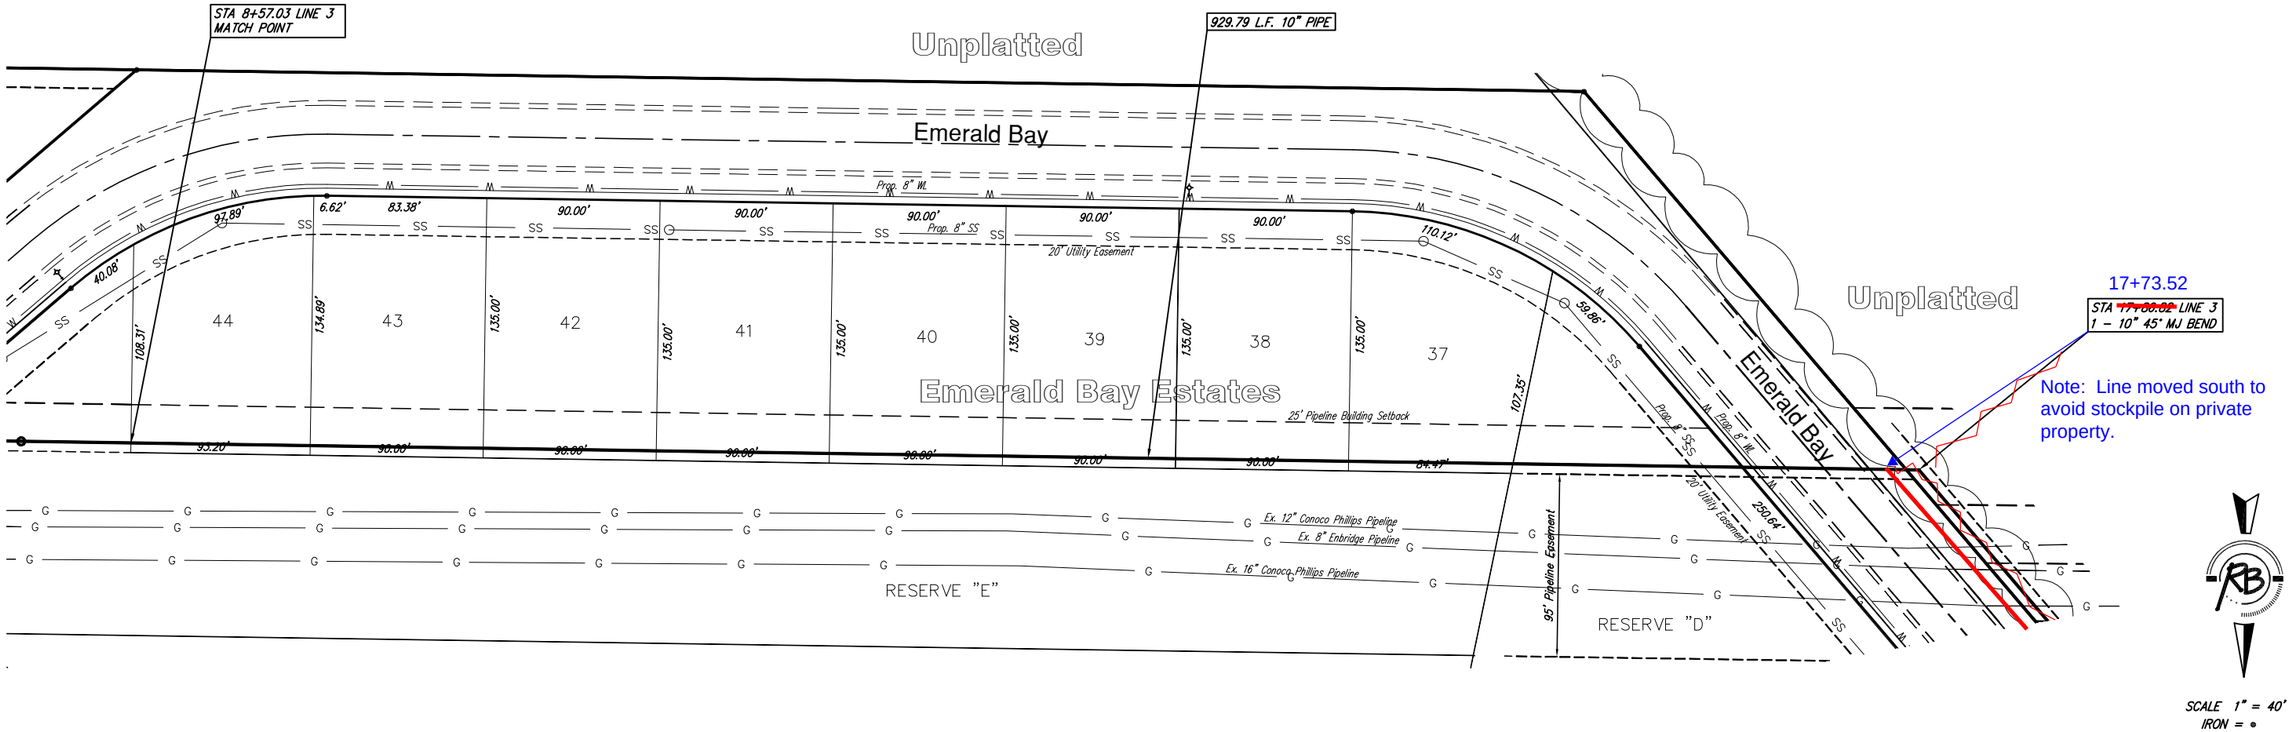

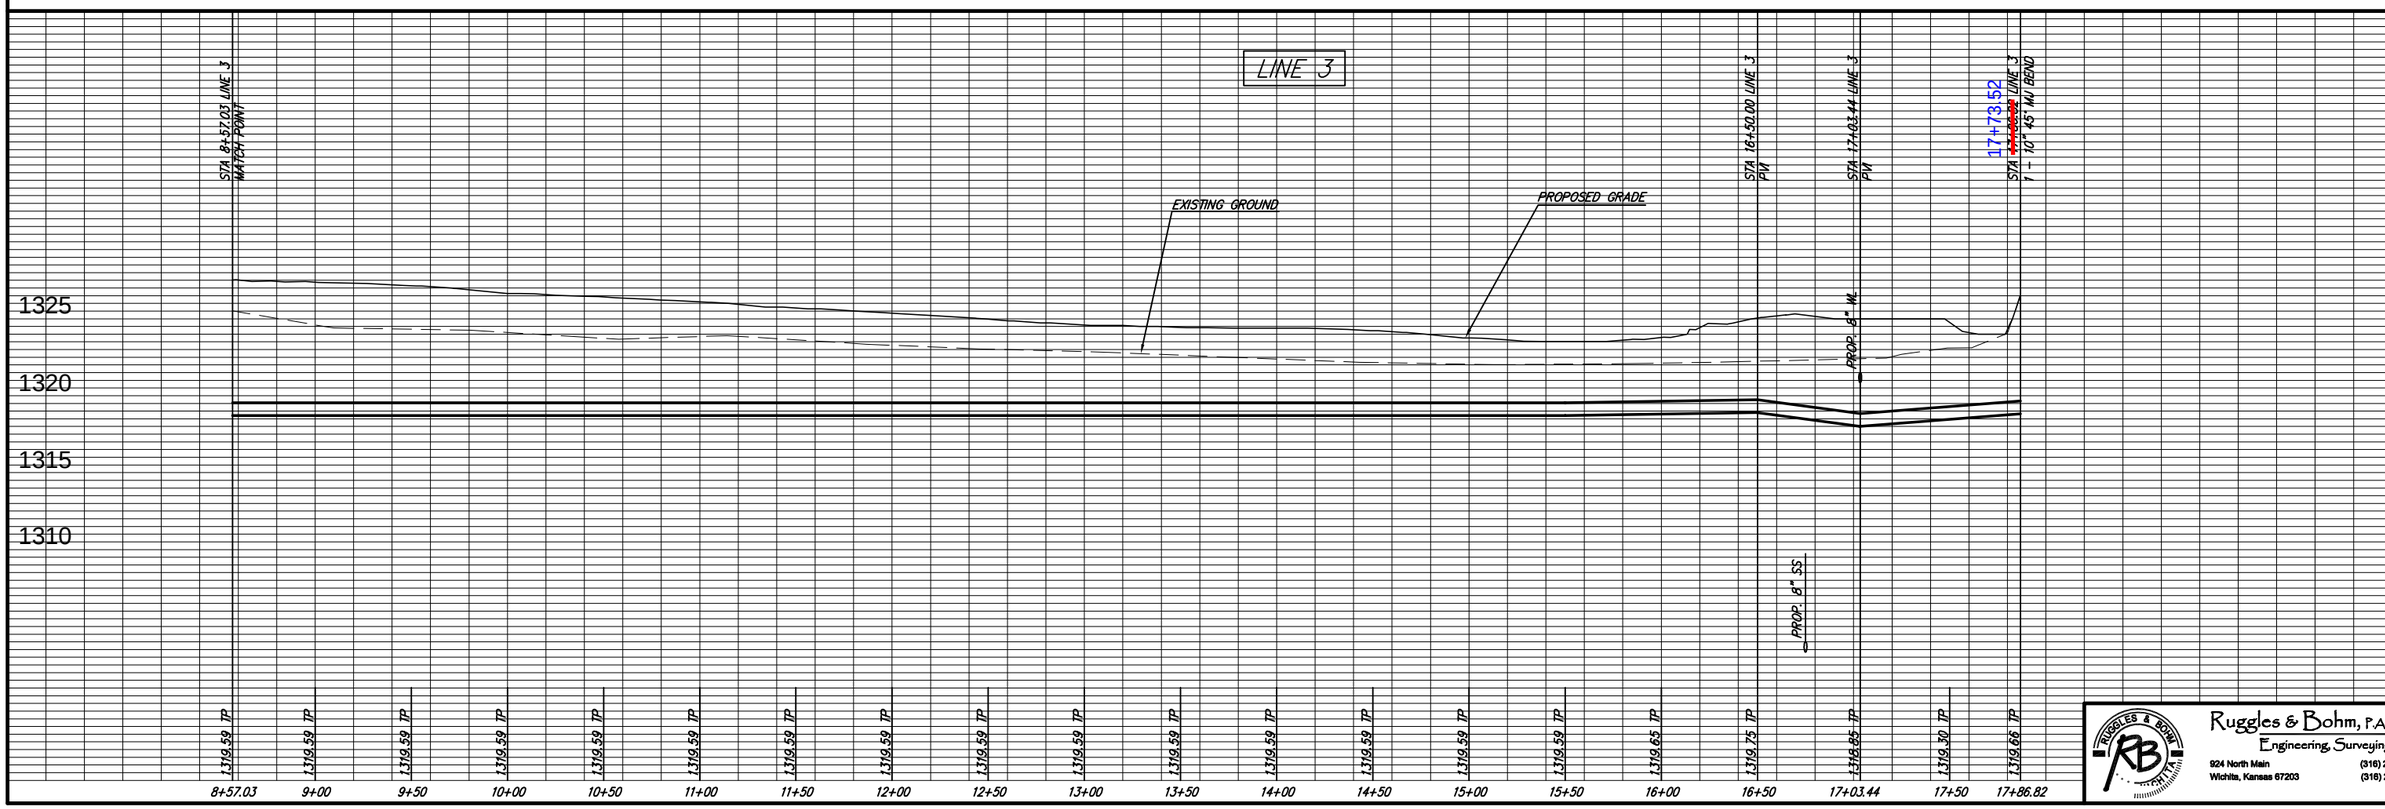

DESIGN AML	DRAWN MLP
UTILITY	DATE Jan. 5, 2006
REVISED	REVIEW
PROJECT NUMBER 468–84141	DRAWING FILE Sanitary Sewer {SS 05}

MAIN 23, SOUTHWEST INTECEPTOR
Sewer Force Main

Ruggles & Bohm, P.A.
Engineering, Surveying, Land Planning
924 North Main
Wichita, Kansas 67203
(316) 264-8008
(316) 264-4621 fax

RB JOB 2822E